



BOILERS N° 2571-2-3.

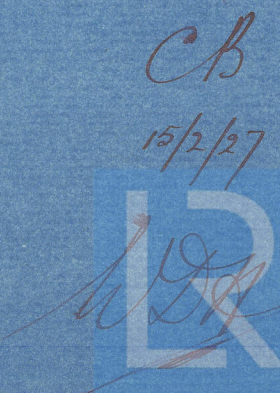

© 2020
 Lloyd's Register
 Foundation

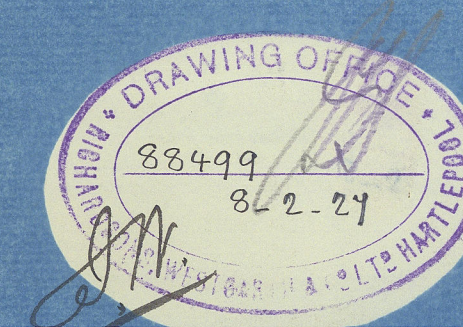

Richardsons, Westgarth & Co. La

Boilers Nos. 2571-2-3

intended for

Palmer's L. & L. Co's. 974-5-6.

"Monagas" Nwc. 81746.

~~GEN. BOX NO 640~~

~~RETAIN~~



© 2020

Lloyd's Register
Foundation

W1151-0072