


^{"Senta"}
~~S/S~~ ^{ex} REGULUS

Deck Plans
of vessel as built

Union Iron Works Co
Alameda: Cal.

No 16.

S. F. Rht. No. 2477.

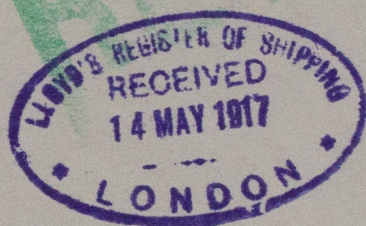

© 2020

Lloyd's Register
Foundation
W1157-0198