

STEEL SCREW STEAMERS

N^{os} 504 & 511

SCALE 1/2" = 1 FOOT

DIMENSIONS

LENGTH B.P.	168-0 ✓
BREADTH MLD.	26-4 1/2 ✓
DEPTH "	12-1 1/2 ✓
DEPTH (A) LLOYDS	10-1 1/2 ✓
DEPTH " " R.O.D.	14-1 1/2 ✓

EQUIPMENT


2 Stockless Anchors each	12-2-0 ✓
1 " " " "	10-2-0 ✓
1 " " " "	4-0-0 Ex. Stock ✓
1 Hedge	1-3-0 ✓
195 Fathoms 1 1/2" Stud Chain Cable	✓
60 " 1 1/2" Short Link Chain or 2 1/4" Steel Wire	✓
75 " 8" Hemp	or " " " ✓
30 " 6 " "	" 2 1/4 " " ✓

FORGING	
PROPELLER POST	STEM 64 x 18 ✓
RUDDER	64 x 52 ✓
RUDDER HEAD	54 x 54 ✓
RUDDER PINTLES	42 DIA ✓
RUDDER PLATE	24 ✓

$$\frac{1}{12} \times 7.5 \times 1.25 = 350 \times \frac{15}{102} = 789$$

MAIN DECK	
BREADTH	26 3/4
DEPTH	12 6/25
39 000 SMALL N ^o	
168	
6552 00 LONGIT. N ^o	
RO. QTR DECK	108 83 x 4 435 32
T.G. FORECASTLE	23 29 x 75 x 75 130 98
BRIDGE HOUSE	12 85 x 80 x 75 76 98
CASING	46 58 x 65 x 5 151 88
7347 16 EQUIPMENT N ^o	

BEAMS	6 53
MAIN DECK DEPTHS	12 31
QTR	10 10
168	
7224 00	

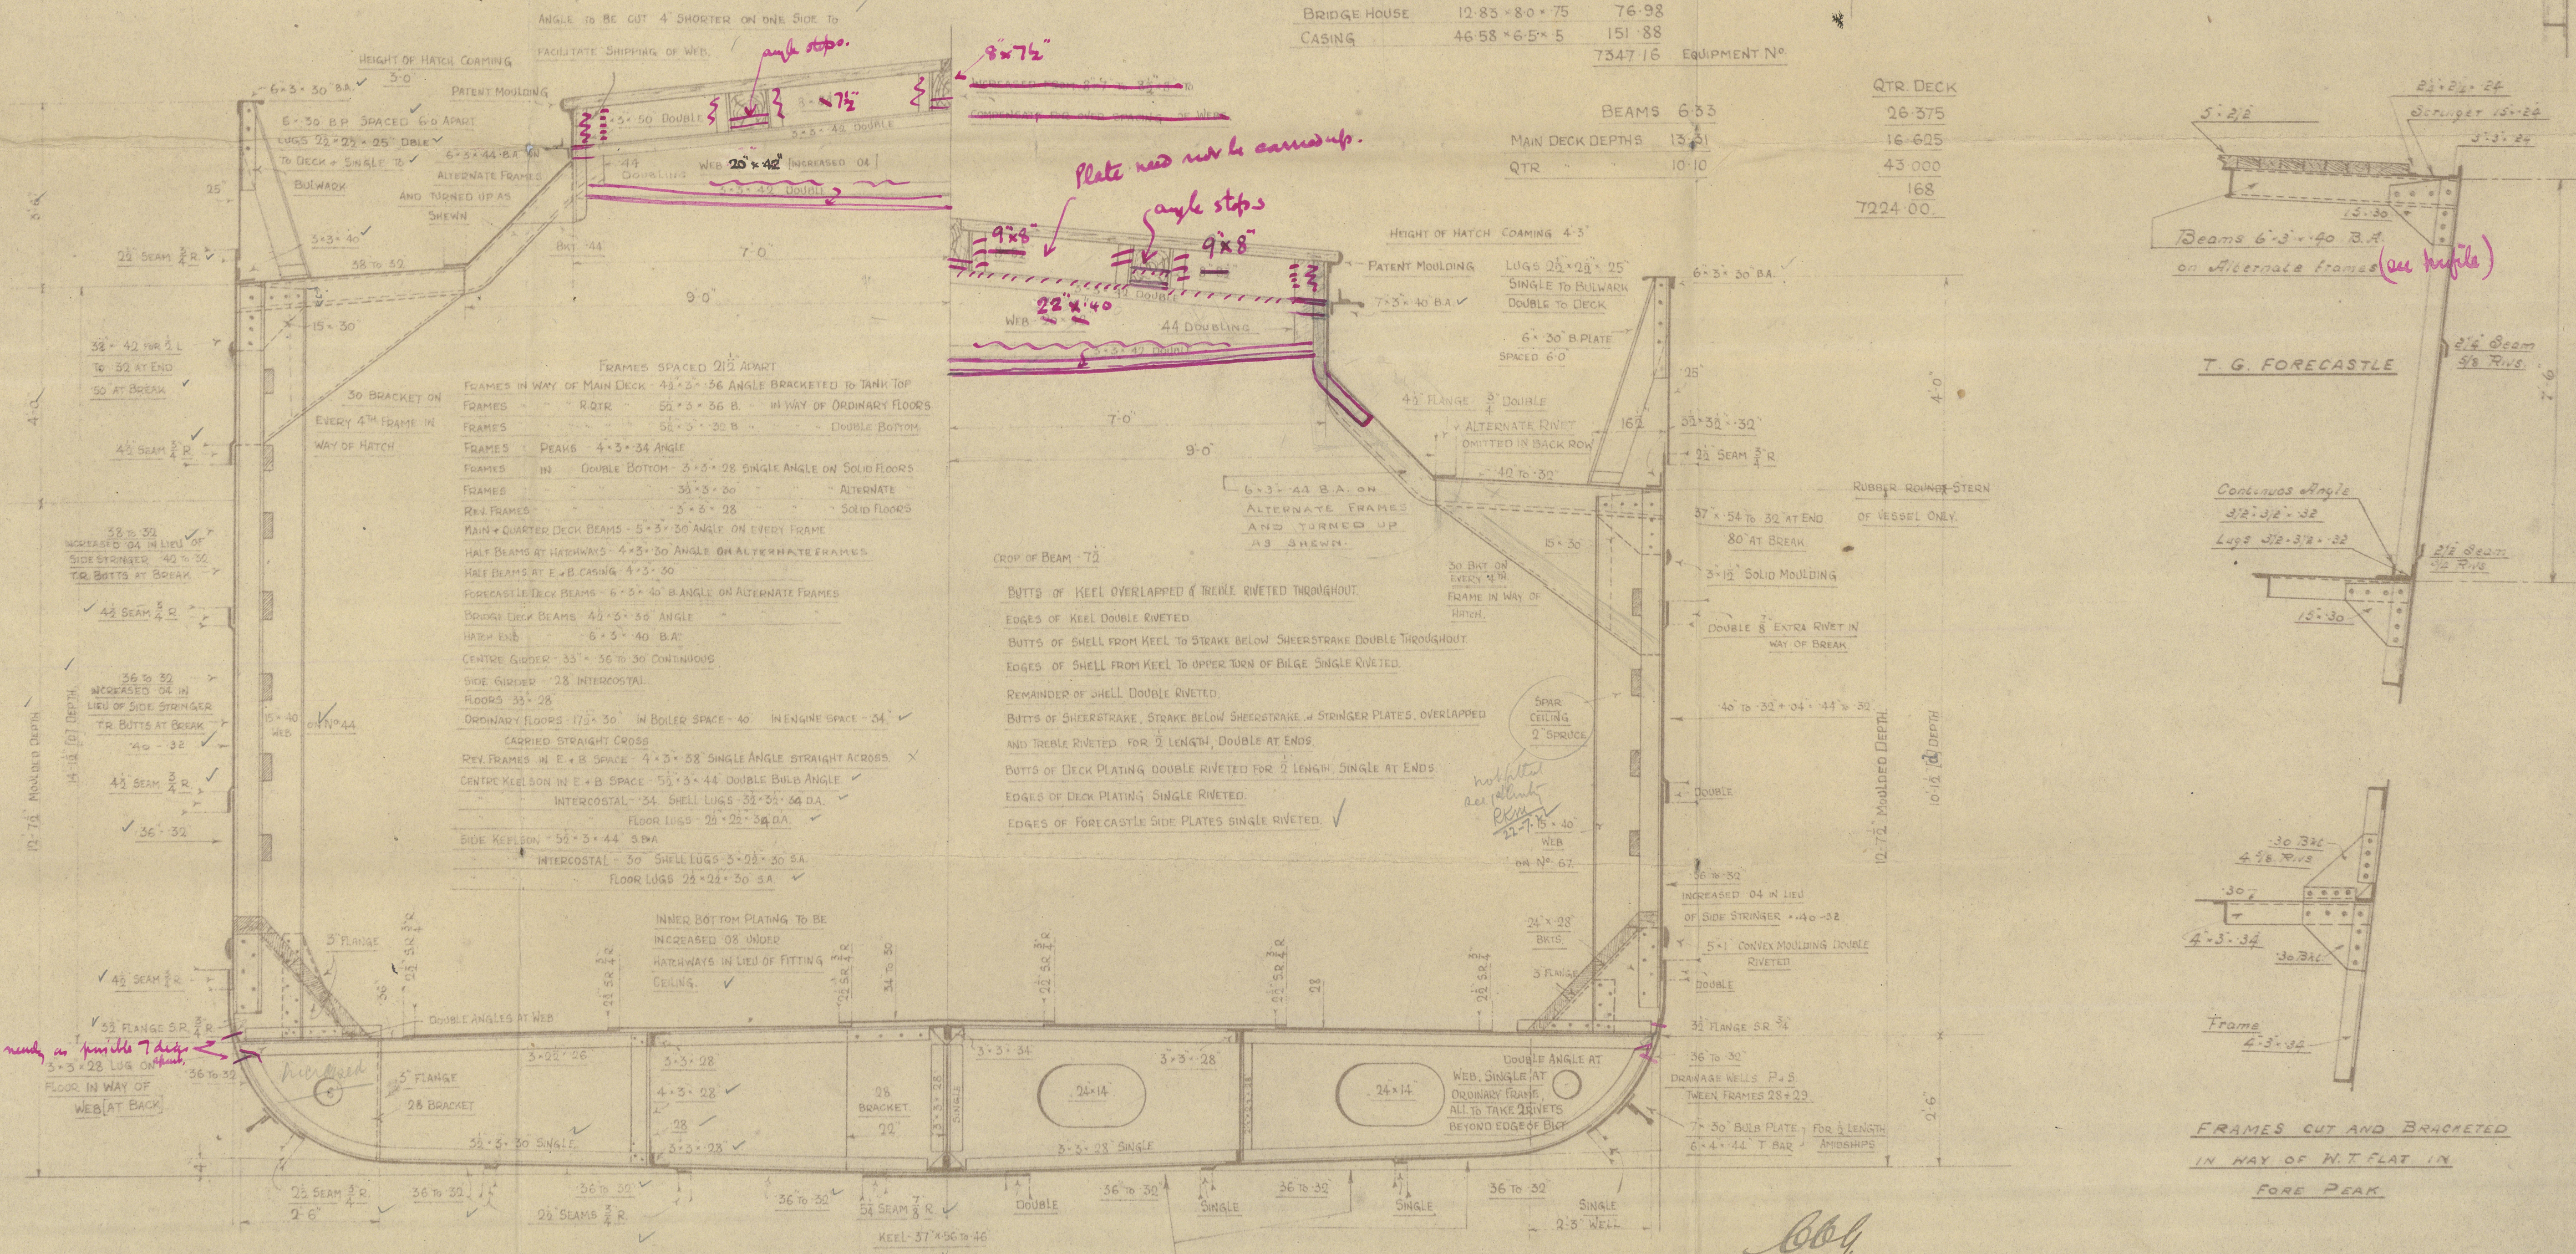

DRAWING No. 196
 THE ABOVE DRAWING NO. MUST BE
 QUOTED IN ALL CORRESPONDENCE IN
 REFERENCE TO SAME.
JOHN CHAMBERS LTD.
 SHIPBUILDERS AND ENGINEERS,
 OULTON BROAD, LOWESTOFT.

20.11.19.

Midship Sect.

~~Box 2684~~

"Royal Regis"


Lon. 85671.

n.n. Berriedale

M/M. 1162

PLANS TRANSFERRED
TO SISTER VESSEL

Barnehta

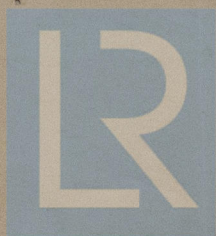

© 2021

Lloyd's Register

W1162-0070