


N^{os} 504 & 511
STEEL SCREW STEAMERS

DIMENSIONS 168' O.B.P. 26'-0" 12'-7 1/2" M.L.D.


PROFILE AND DECK PLAN

SCALE 1/4" = 1 FOOT

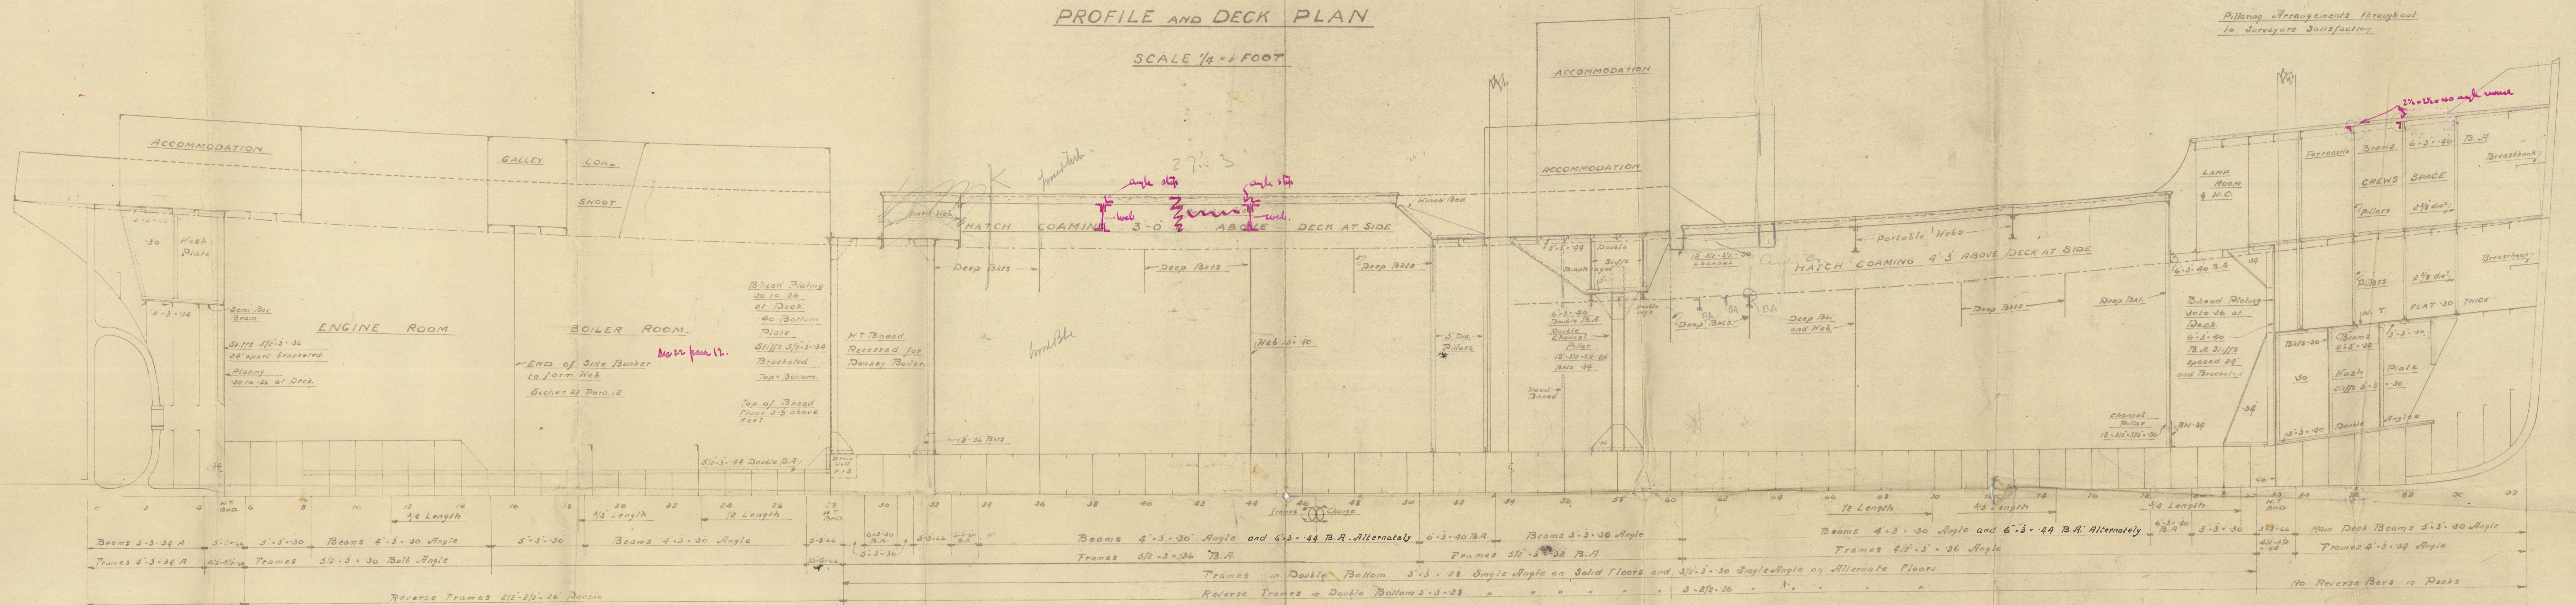

Pillaring Arrangements throughout
 to Surveyors Satisfaction.

Bottom Strengthening Forward as required by Rules
 to extend back to 12 Length. To be submitted

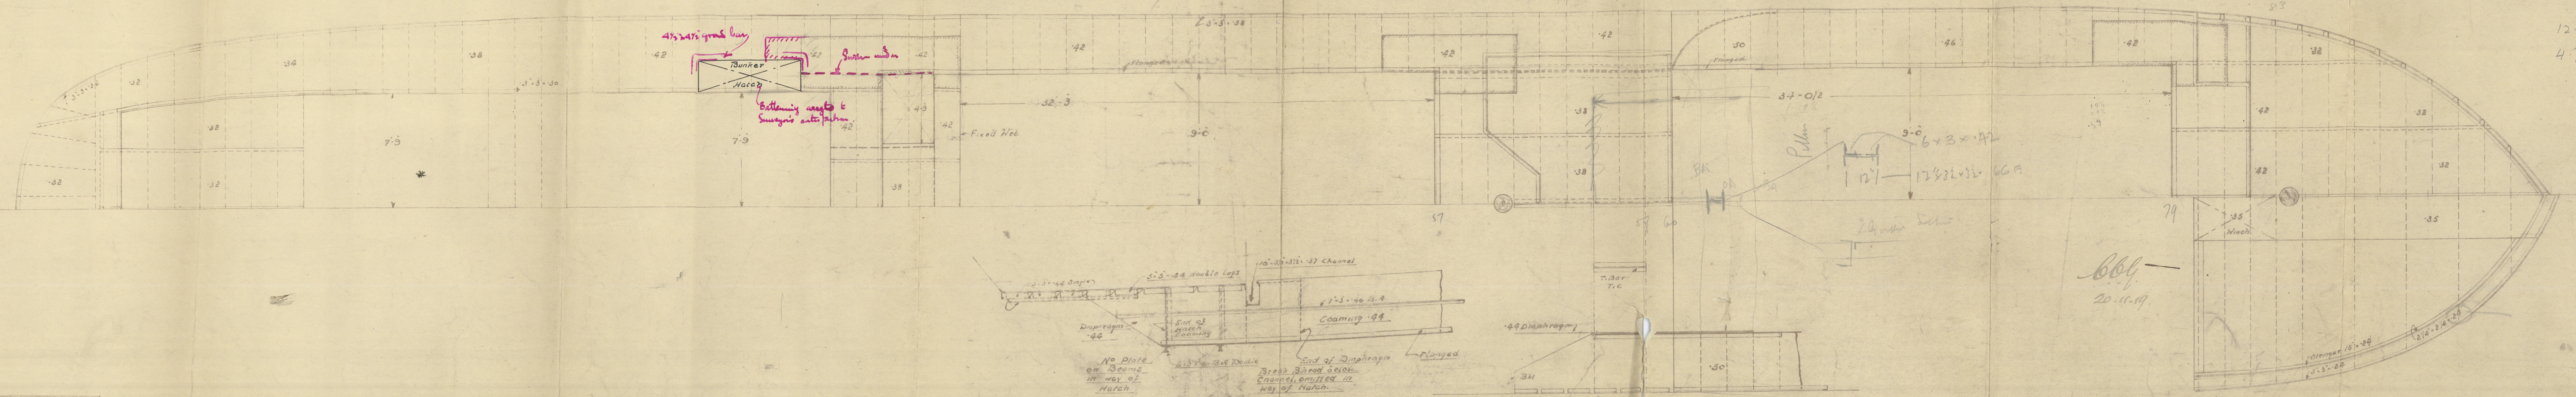

DRAWING No 209.
 THE ABOVE DRAWING IS NOT TO BE
 QUOTED IN ALL CORRESPONDENCE IN
 REFERENCE TO THIS
JOHN CHAMBERS LTD.
 SHIPBUILDERS & ENGINEERS
 CULTON ROAD, LOWESTOFT.

Sketch showing overlap of
 Hatch Coaming & Diaphragm
 in way of Break.

Profile & Deck Plan

~~Gun Box 2684~~

"Bevrieddale" ex "Royal Regis"

M/M. 1162

Lon. 85671

PLANS TRANSFERRED
TO SISTER VESSEL

Carmelita



© 2021

Lloyd's Register
Foundation

W1162-2073