

EQUIPMENT		C.Q. Lbs
2 Stockless Anchors each		12-2-0
1 " " "		10-2-0
1 Stream " "		4-0-0 Ex. Stock
1 Hedge " "		1-3-0 " "
195 Fathoms	1 1/2" Stud Chain Cable	
60 "	1 1/2" Short Link Chain or 2 1/2" Steel Wire	
75 "	8" Hemp	or " " "
30 "	6 " "	or 2 1/4 " "

## STEEL SCREW STEAMERS

Nos 504 & 511

SCALE 1/2" = 1 FOOT

DIMENSIONS	
LENGTH B.A.	168' 0"
BREADTH M.O.	26' 4 1/2"
DEPTH	12' 7 1/2"
DEPTH (d) LLOYDS	10' 1 1/2"
" " " R.O.D.	14' 1 1/2"

### FORGINGS

Propeller Post	6 1/4" x 1 1/2"
Rudder	6 1/4" x 3 3/4"
Rudder Head	4 1/2" dia.
Rudder Pintles	2 1/4"
Plate	.82

### Main Deck

Breadth	26' 3 3/4"
Depth	12' 6 25"
39' 0 00" Small No.	
168	
6582' 00" Length No.	

### OR. Deck

26' 3 3/4"	
12' 6 25"	
43' 0 00"	
168	
7224' 00"	

### T.G. FORECASTLE

### AFT OF FWD P.P.


Red. Or. Deck	108' 83" x 4"	435' 32"
T.G. Forecastle	23' 23" x 7' 5"	130' 48"
Bridge House	12' 83" x 8" x 7' 5"	76' 48"
Casing	46' 68" x 6' 5" x 3"	151' 88"

7347' 16 Equipment No.

Beams 6-33

Main Deck Depths 13' 31"

O.R. " 10' 10"

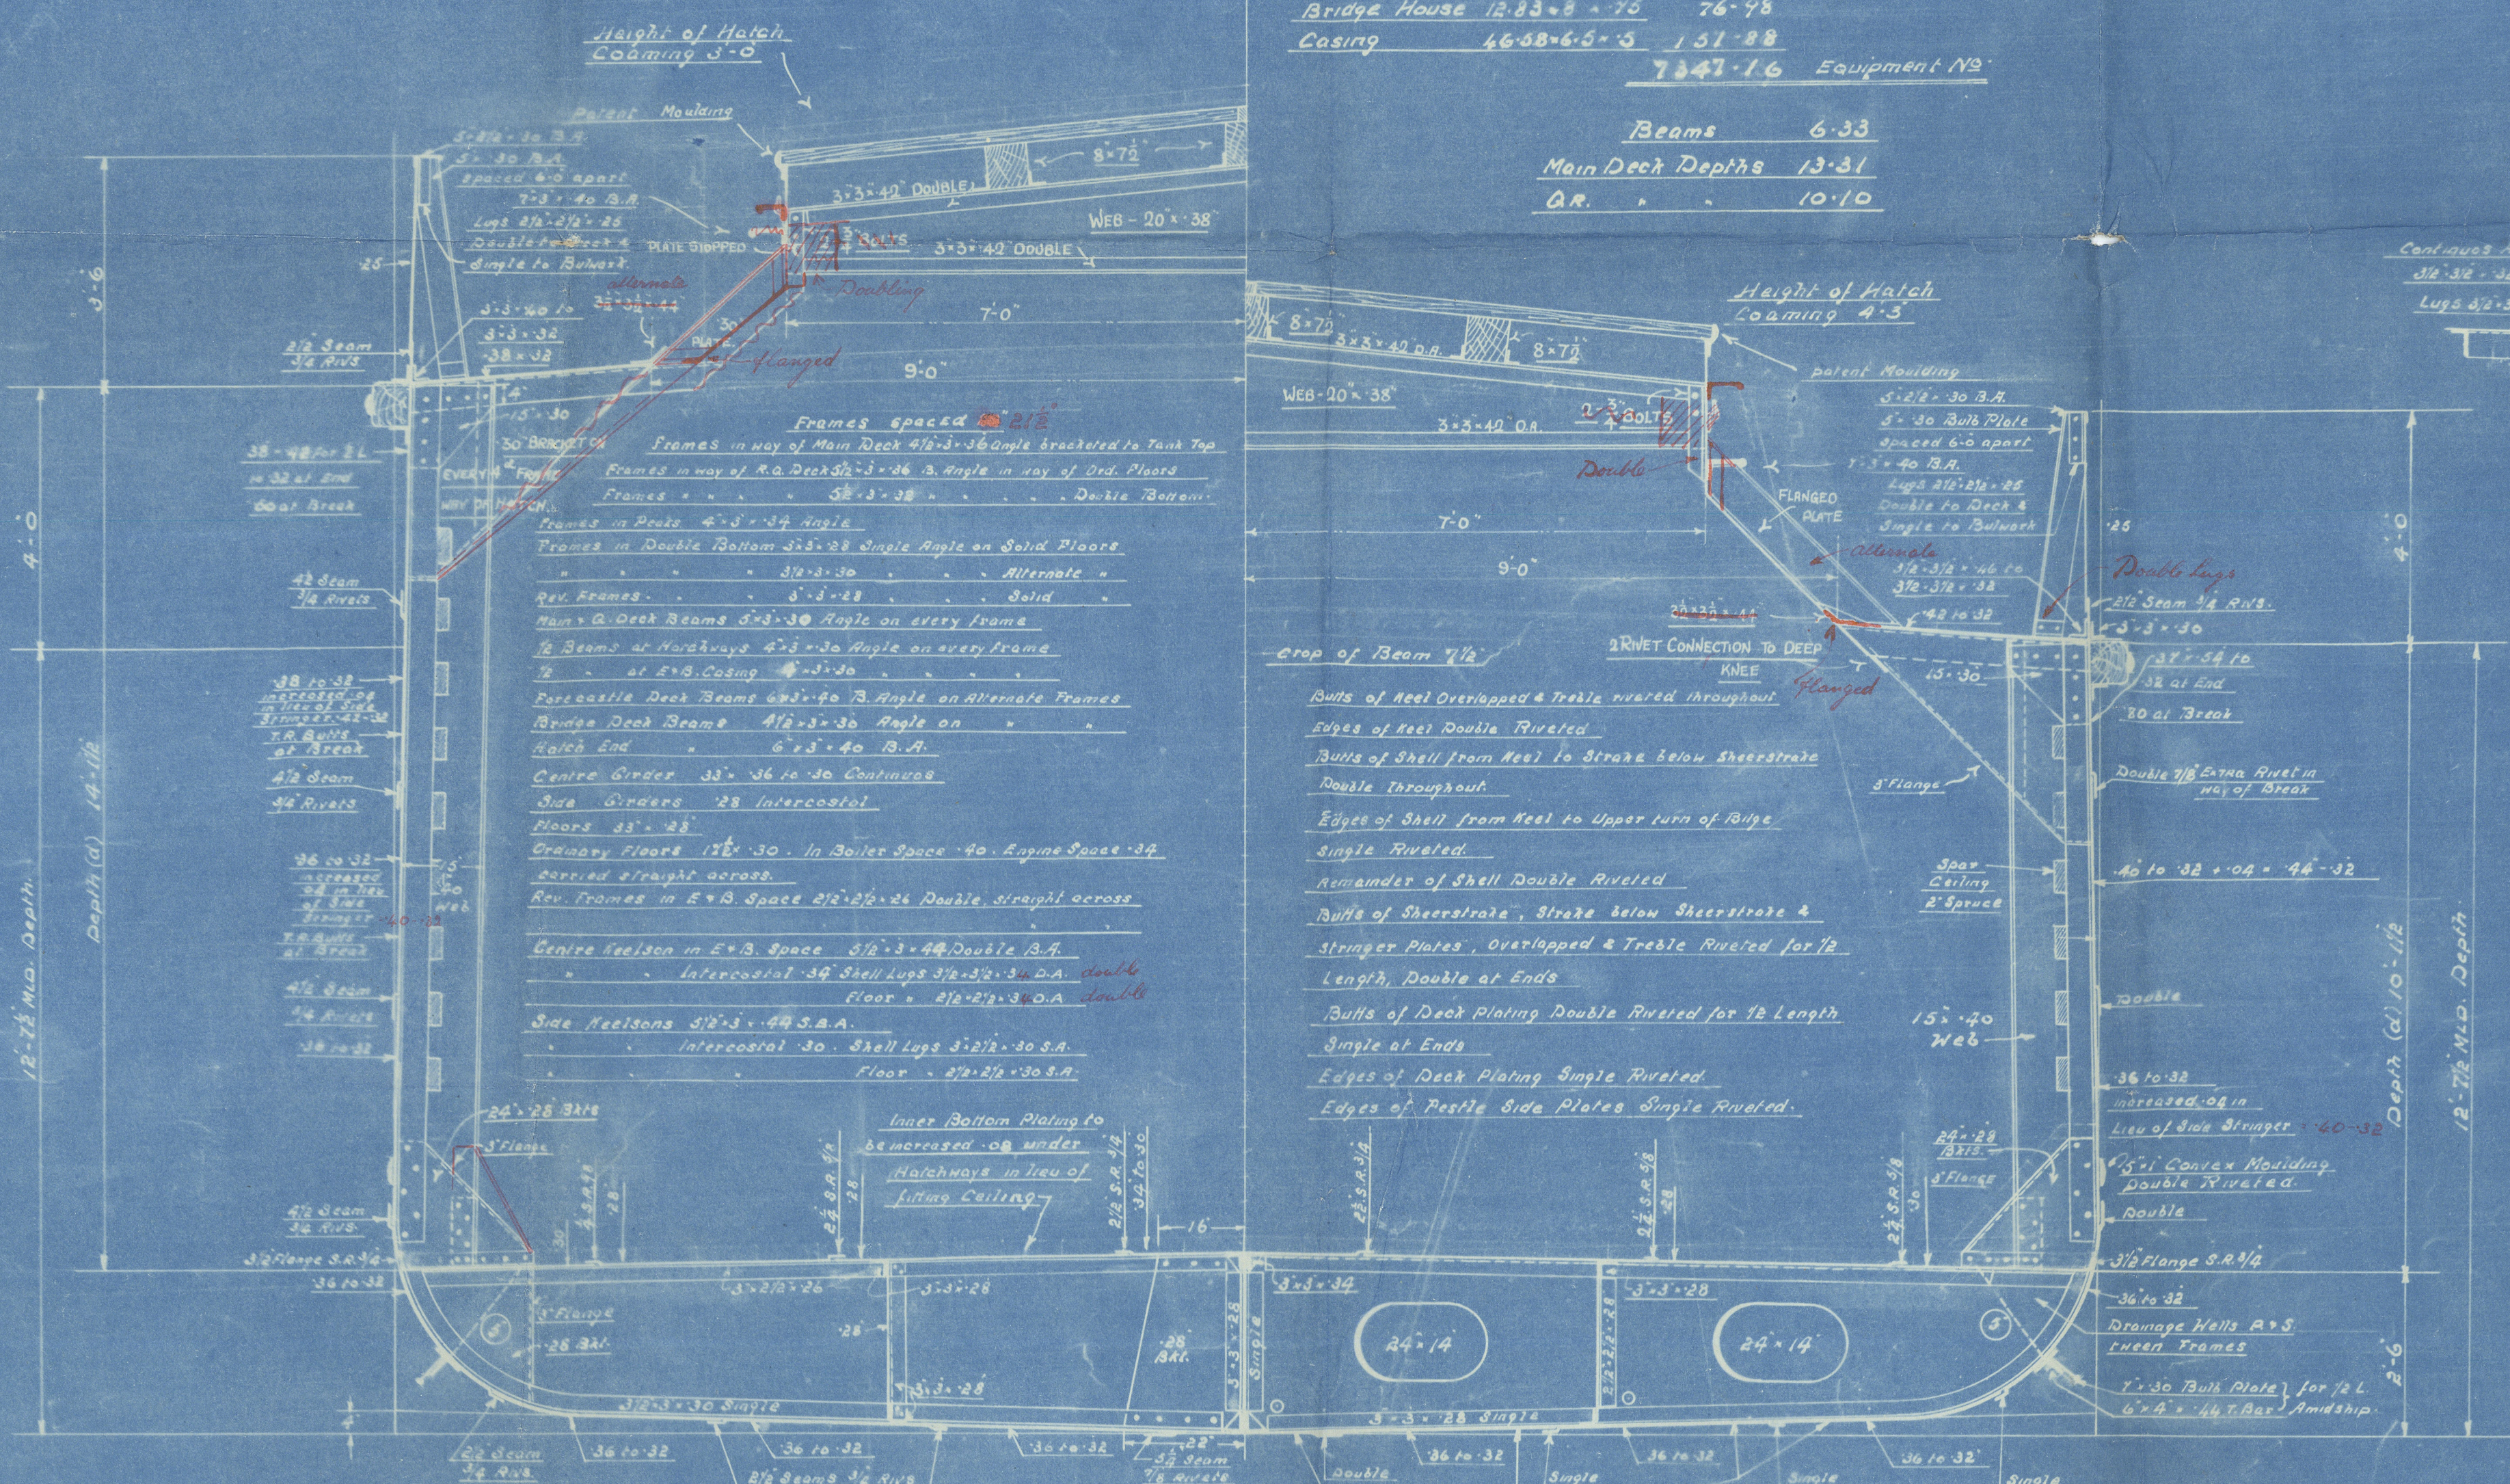


DRAWING No. 196.

THE ABOVE DRAWING MUST BE  
QUOTED IN ALL CORRESPONDENCE IN  
REFERENCE TO 34716

JOHN CHAMBERS LTD.  
SHIPBUILDERS & ENGINEERS  
OULTON ROAD, LOWESTOFT

664  
12.7.19

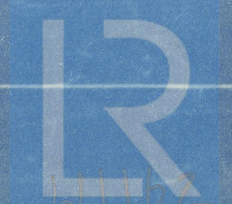

© 2021  
Lloyd's Register  
Foundation



604

Chambers Lovestoft

504 4511

Midship Section

BERRIEDALE

M/M. 1162

See amended plan

app<sup>d</sup> - 20/11/19

"Berriedale" ex "Royal Regis"  
Lon. 85671.

~~John Rose 1884~~

W. S. Jones

PLANS TRANSFERRED  
TO SISTER VESSEL

Carmelita



© 2021

Lloyd's Register  
Foundation

W1162-0074