


S.S. "CORABELLA"

SKETCH OF STERNFRAME SOLEPIECE
SHOWING POSITION OF FRACTURES



THE LLOYD'S REGISTER OF SHIPPING OF LONDON
15/4/1910

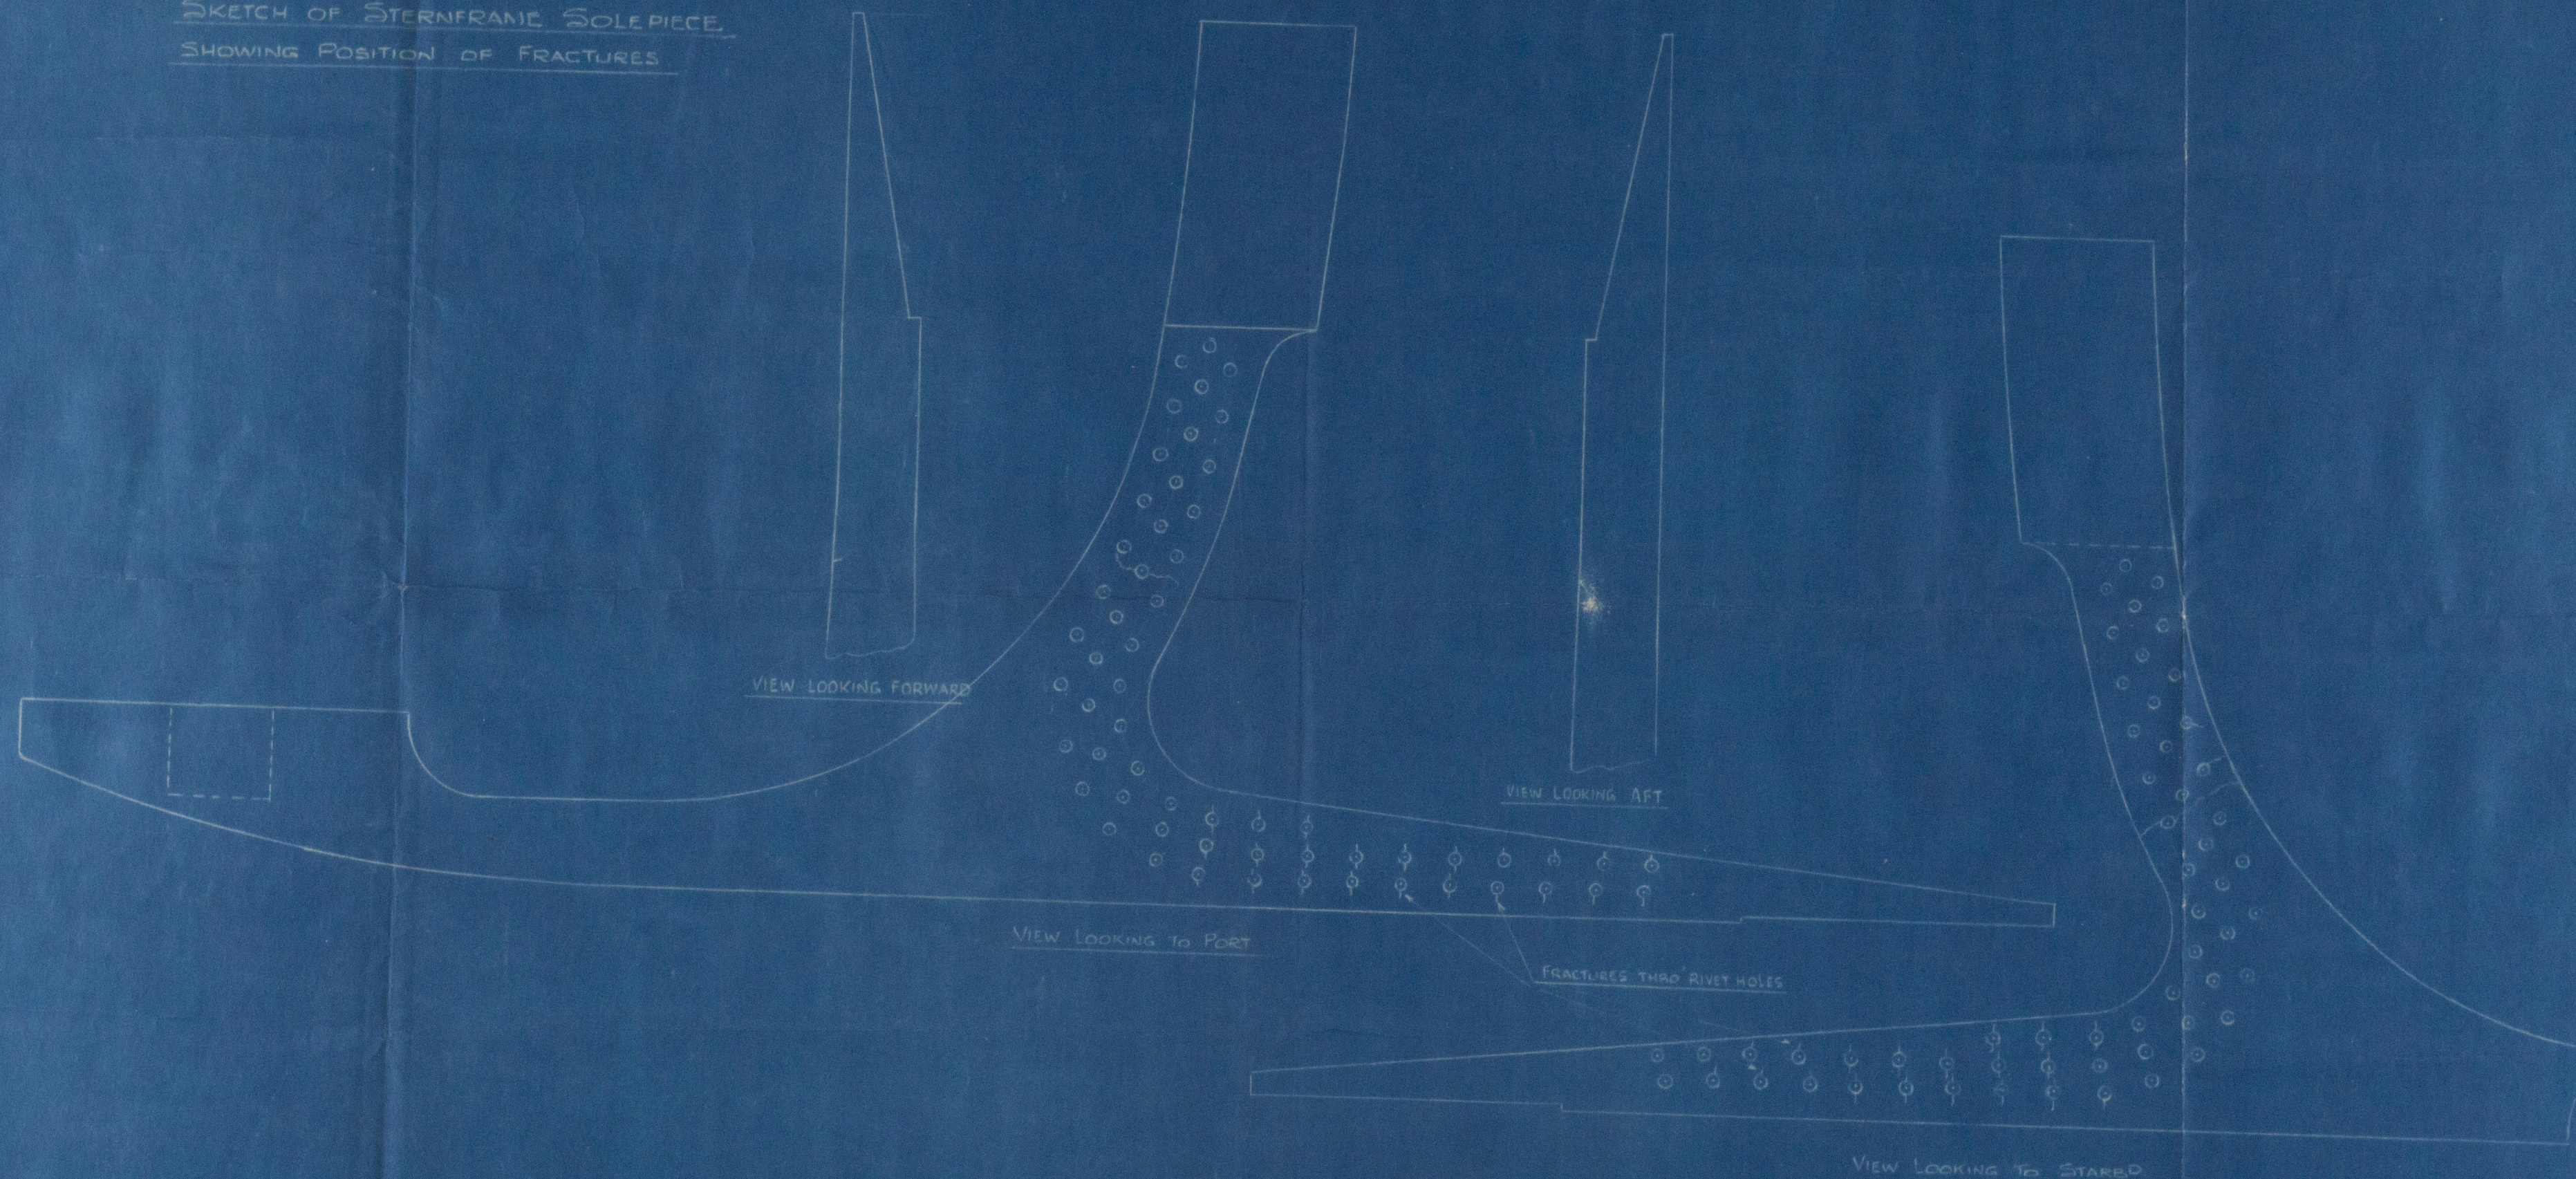

Lloyd's Register
Foundation

CORABELLA

NWC RPT 97392

SKETCH A

April 19

Fractures in Sternframe (bottom portion)



© 2020

Lloyd's Register
Foundation

W1168 - 0210