


DETAIL OF STEEL KEY PINS
IN SHAFT & CRANK PINS
FULL SIZE

SCALES AS MARKED

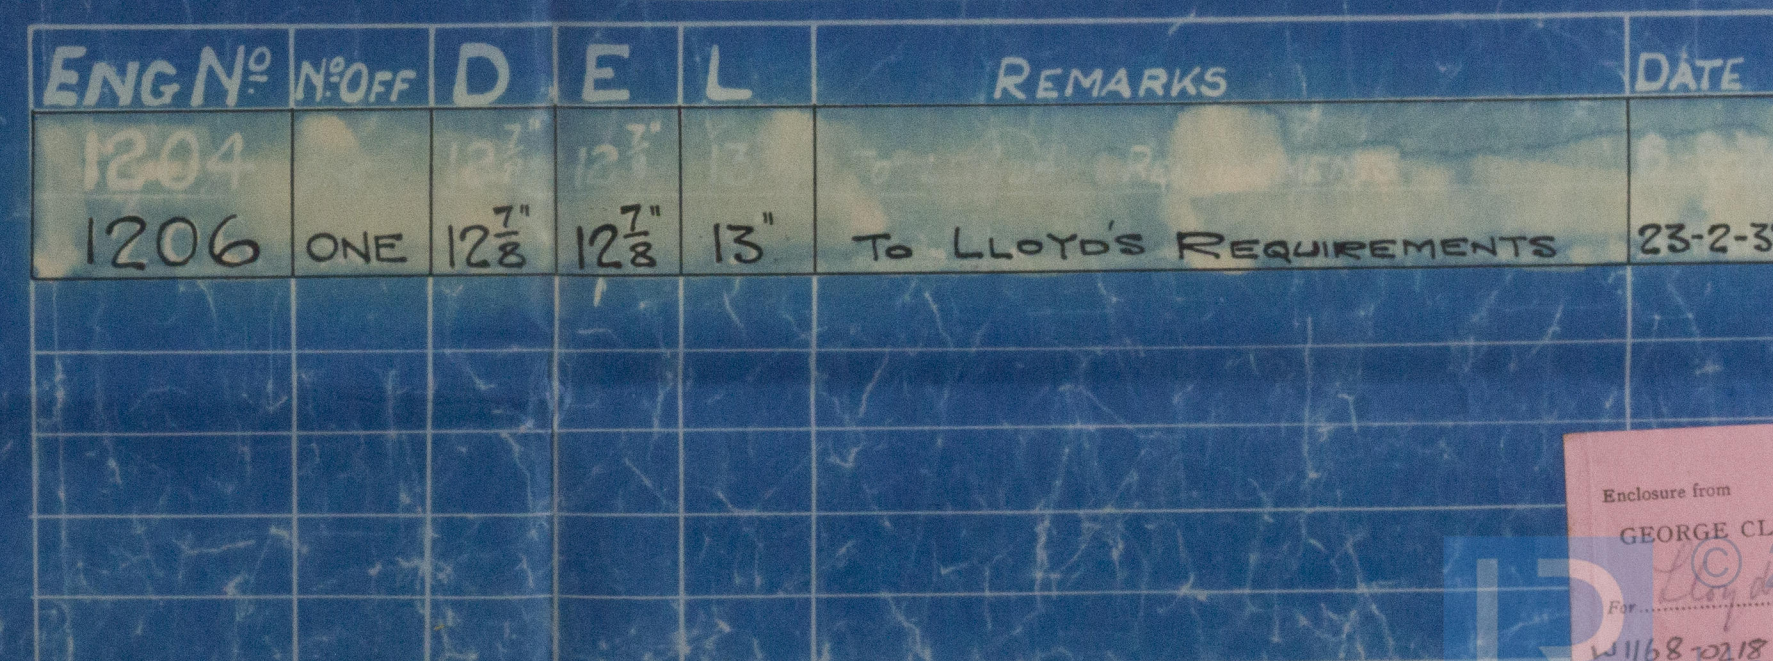

Enclosure from
GEORGE CLARK (1936) Ltr

© 2020

For.....
W1168-0218 2 1/2' land

G. CLARK (1936) L¹

Cont N^o 1206

—
—

SUNDERLAND RPT. NO. 32182

ss. "CORABELLA"

RETAIN

W1168-0218 1/2



© 2020

Lloyd's Register
Foundation

Enclosure from

GEORGE CLARK (1936) LTD.

For

W1168-0218 $2\frac{1}{2}$

land