

Northumberland's W 244

HOGG-CARR PATENT HATCH COVER.



THE HOGG-CARR CONSTRUCTION Co. Ltd.
AKENSIDE HOUSE
NEWCASTLE-UPON-TYNE.

OPENING 29'-9" long & 20'-0" wide

SCALE 1/2" = 1 FT.




PLAN VIEW ON TOP.

Spacing of bolts not to exceed 3'-0"

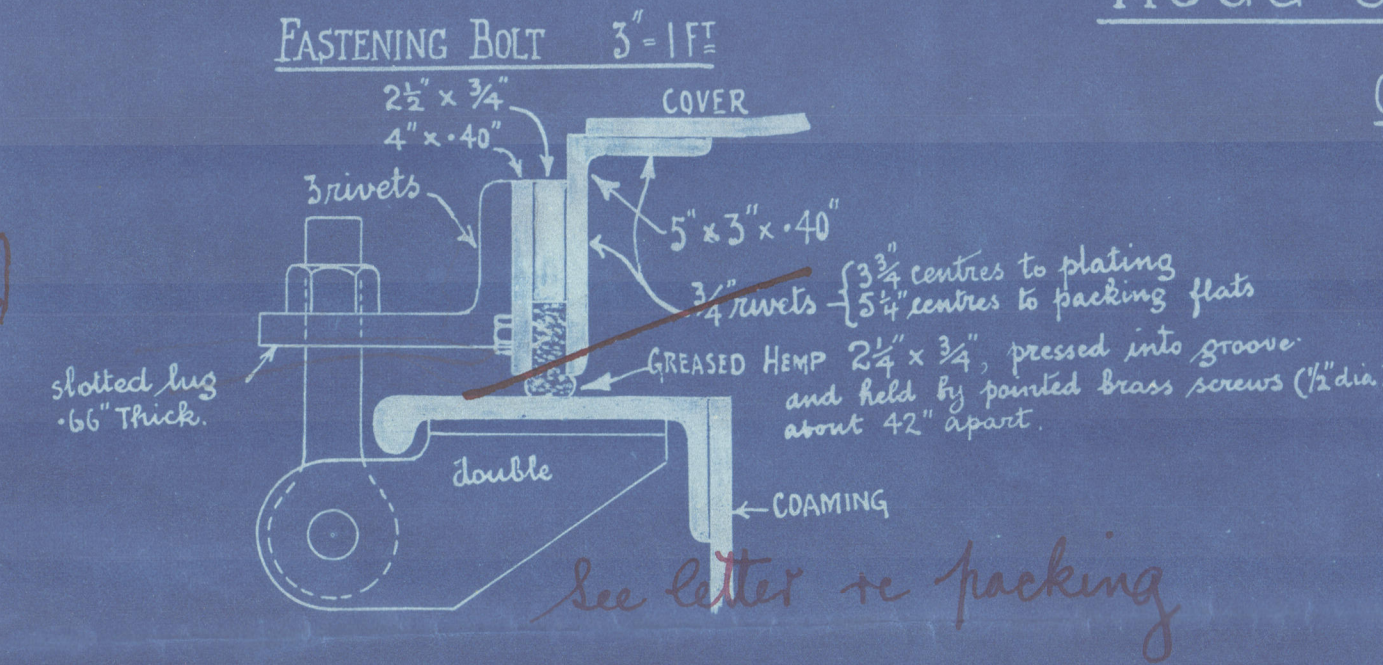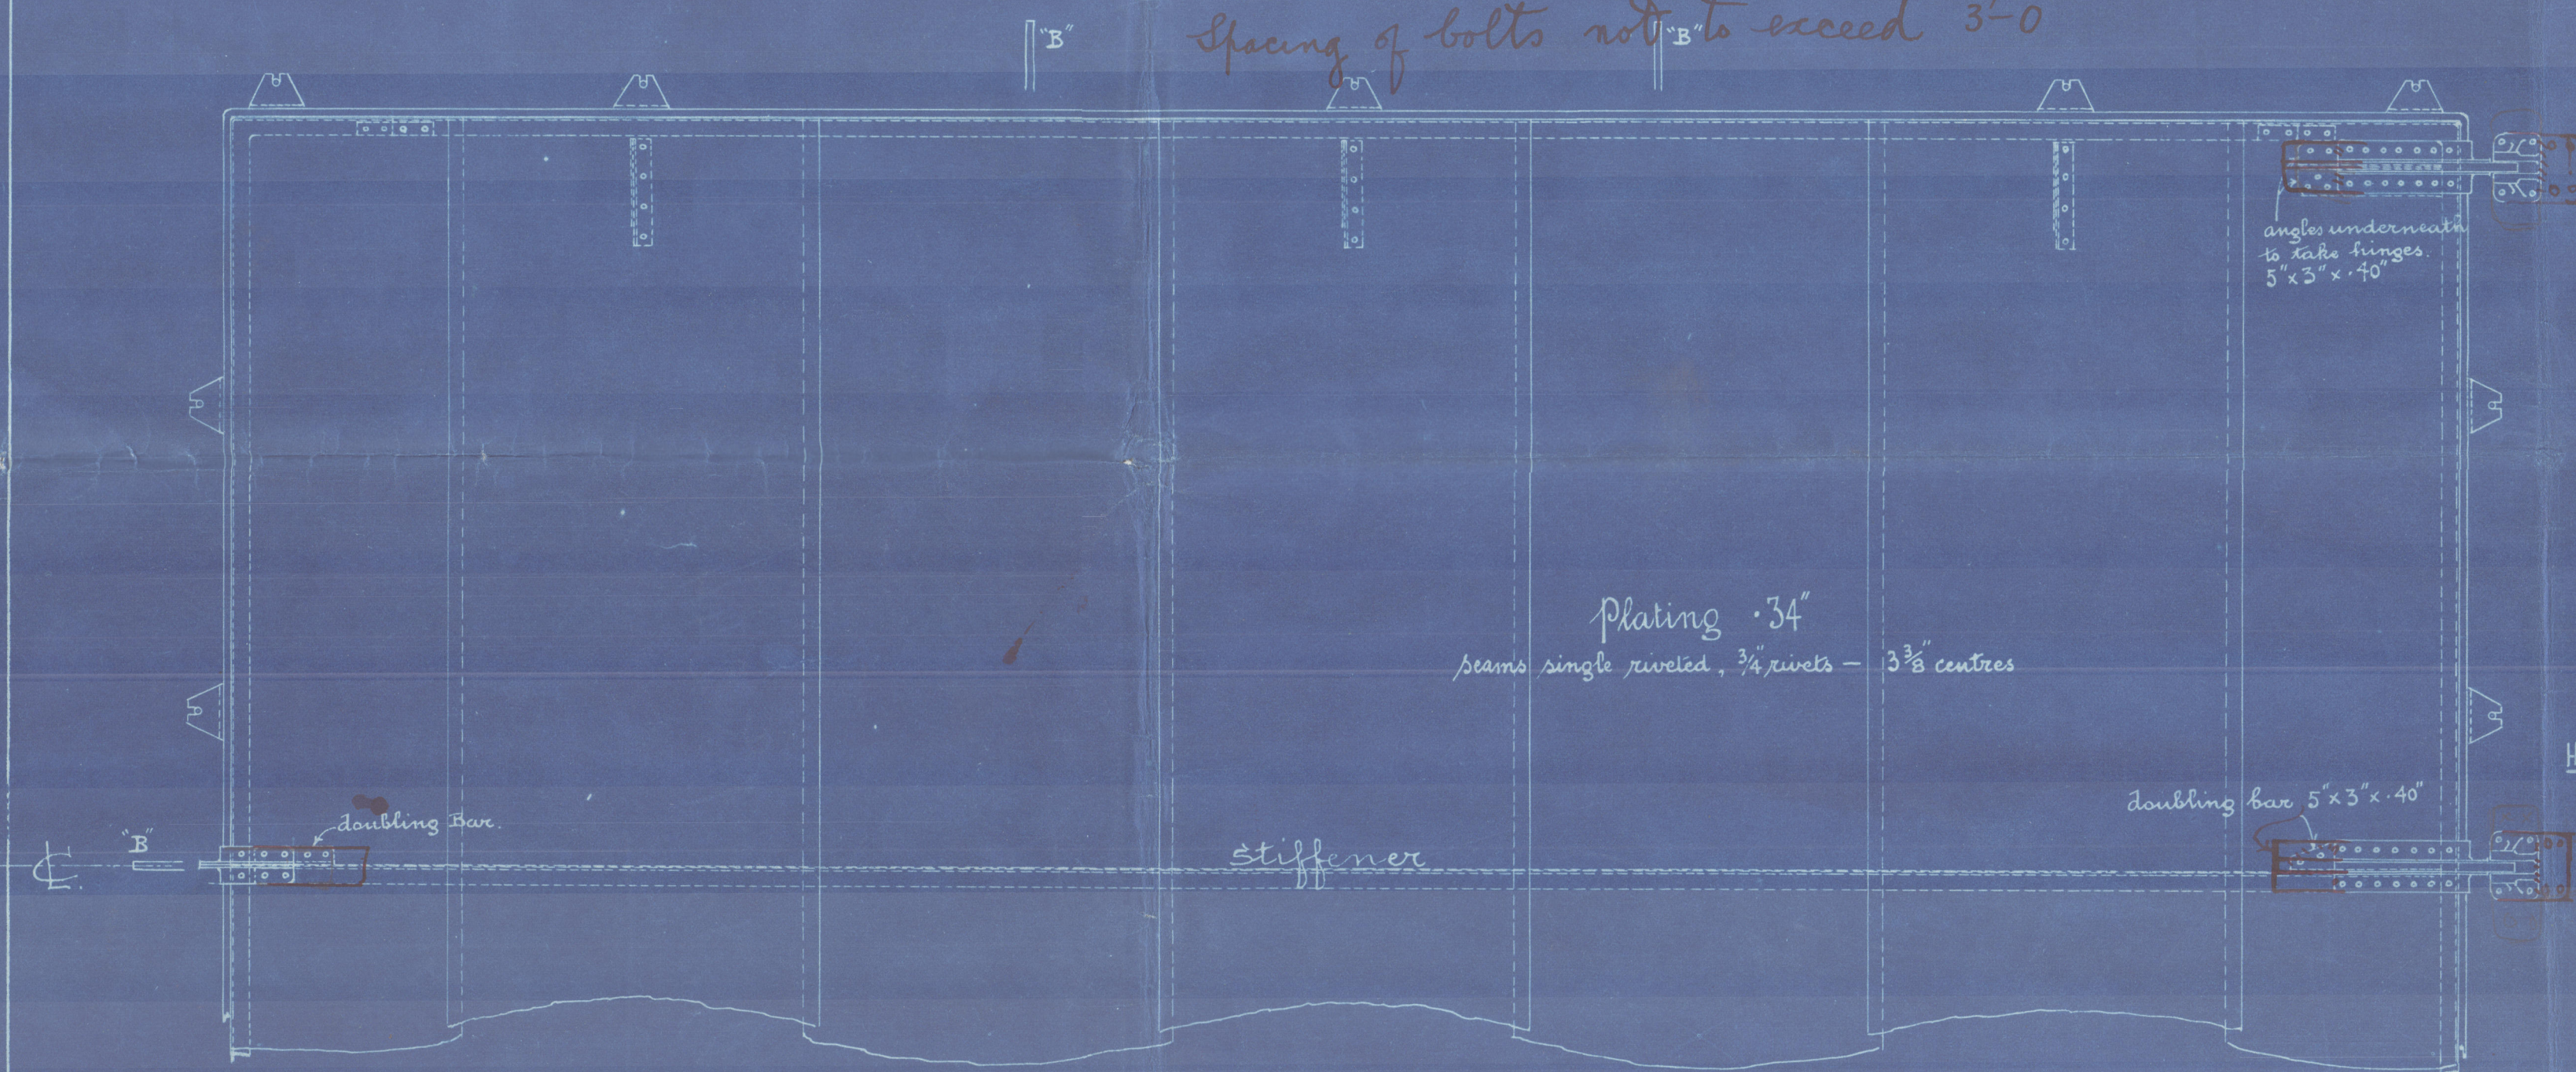


LIST OF HATCHES


Nº1 HATCH	29'-9" x 20'	as per this plan
Nº2 HATCH	24'-9" x 20'	as per this plan
Nº2a HATCH	17'-0" x 20'	as per this plan and sketch
Nº3 HATCH	34'-0" x 20'	as per this plan except: corrugation 18" deep
Nº4 HATCH	29'-9" x 20'	as per this plan

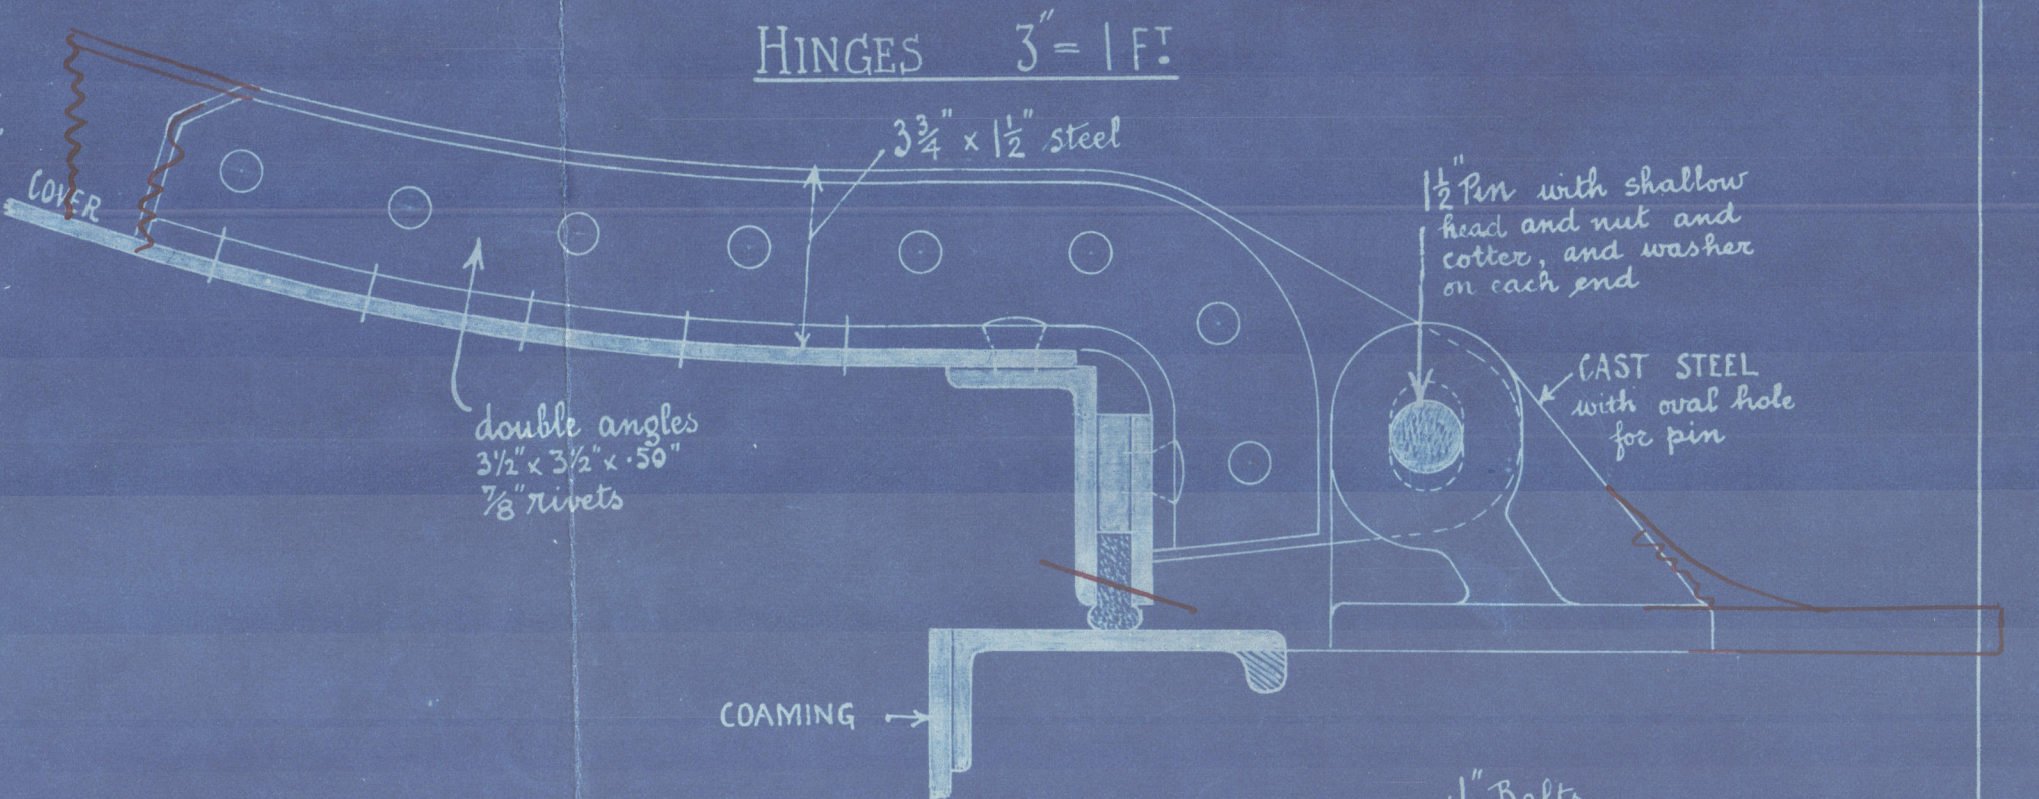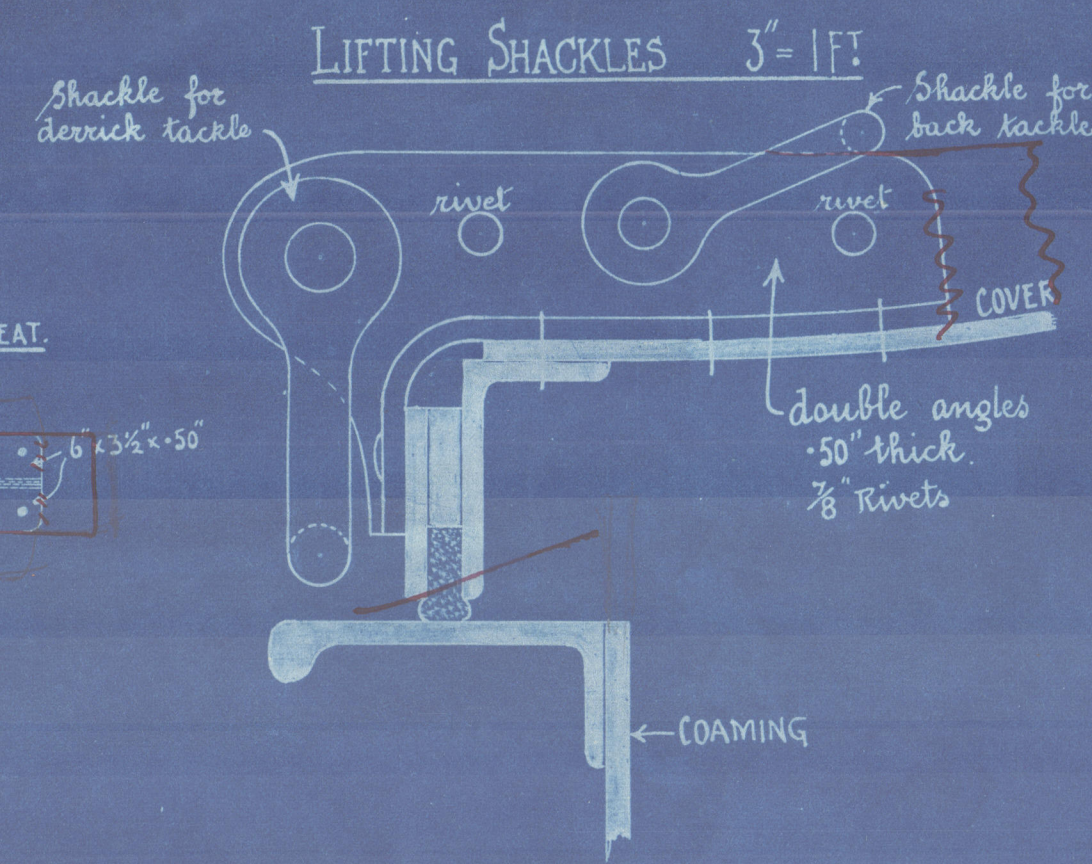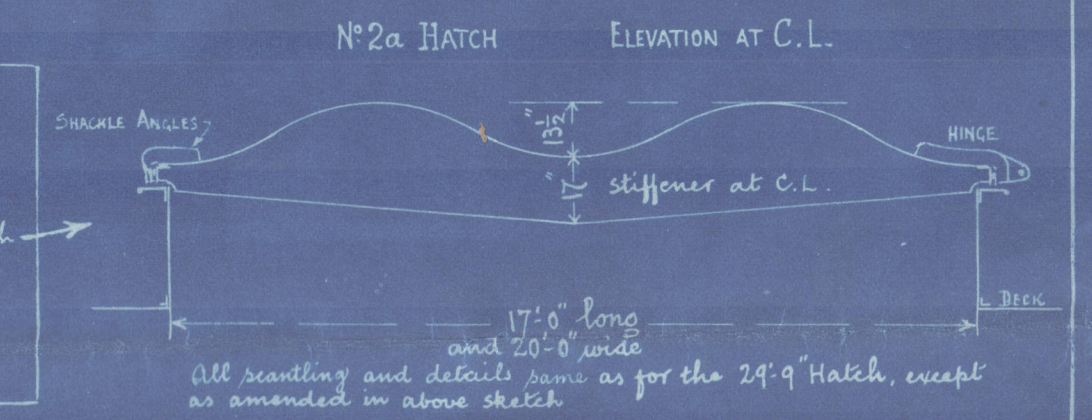


ELEVATION AT SIDE COAMING - from inside.

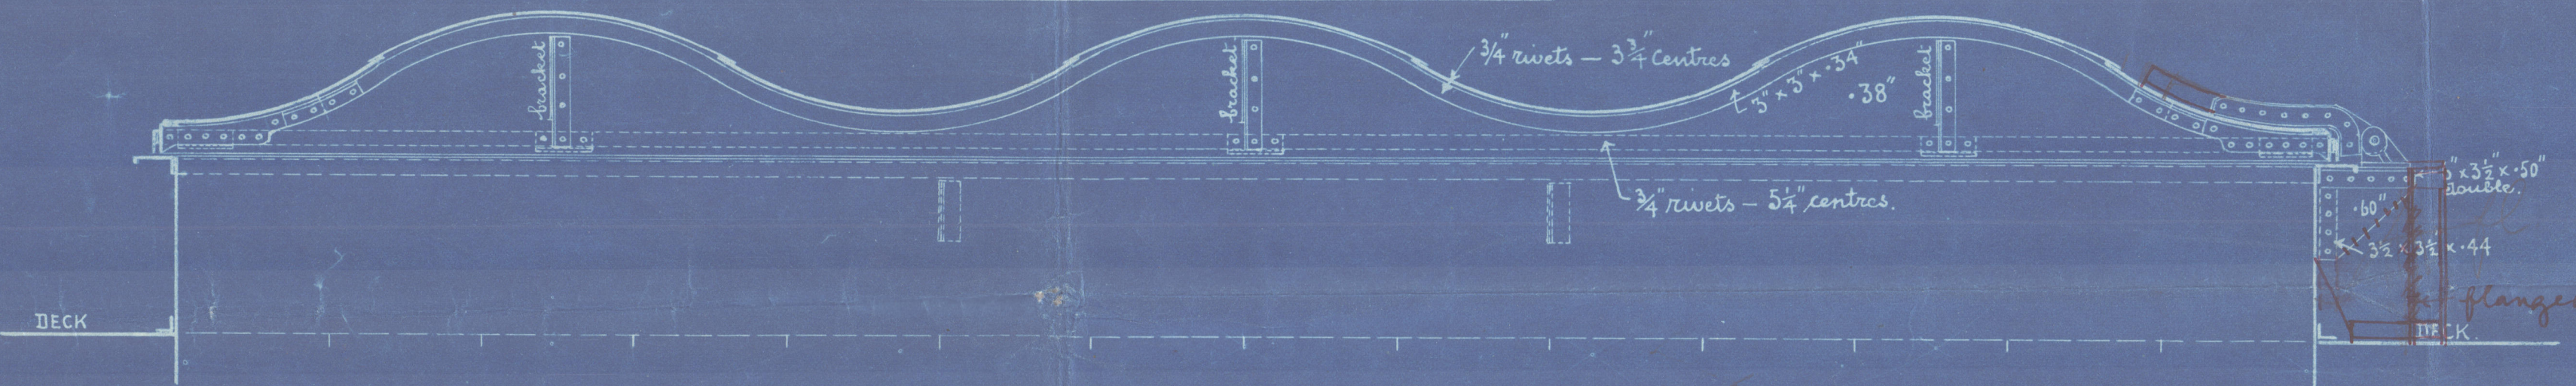


ELEVATION AT CENTRE LINE - showing STIFFENER.

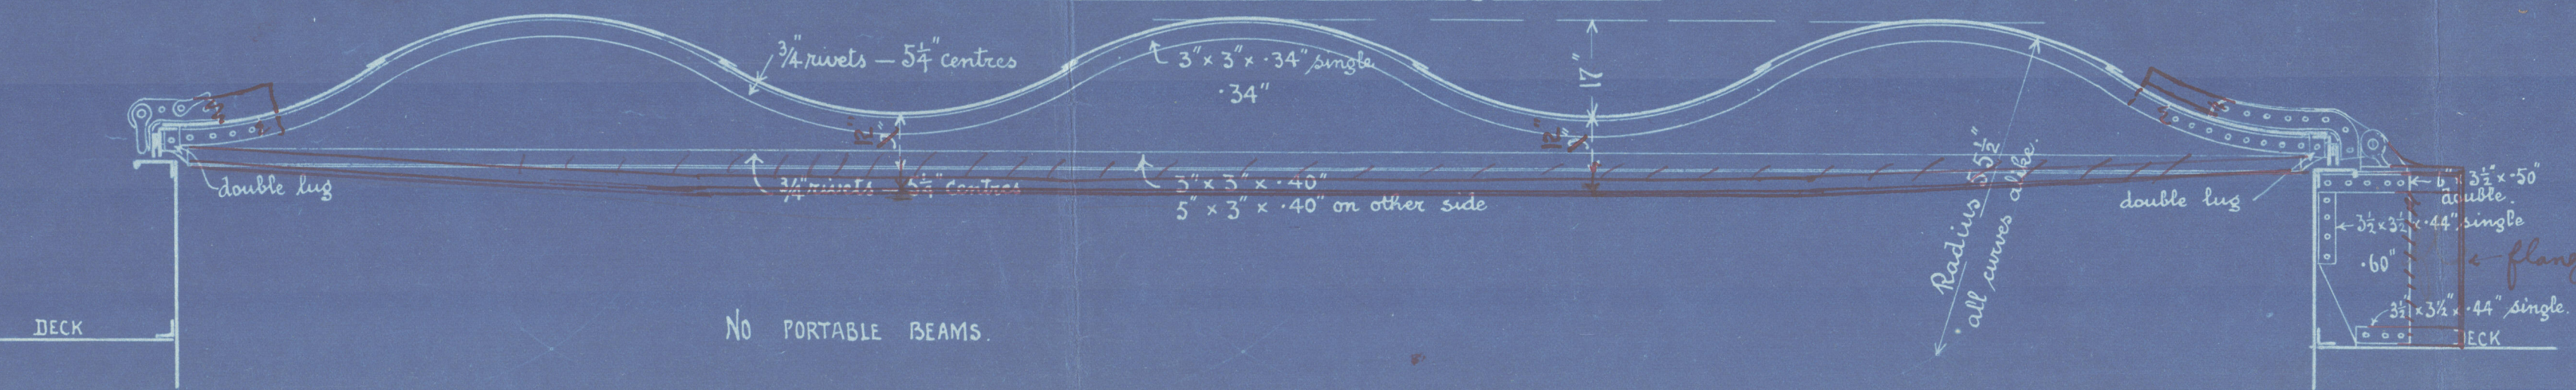

END ELEVATION - SECTION.

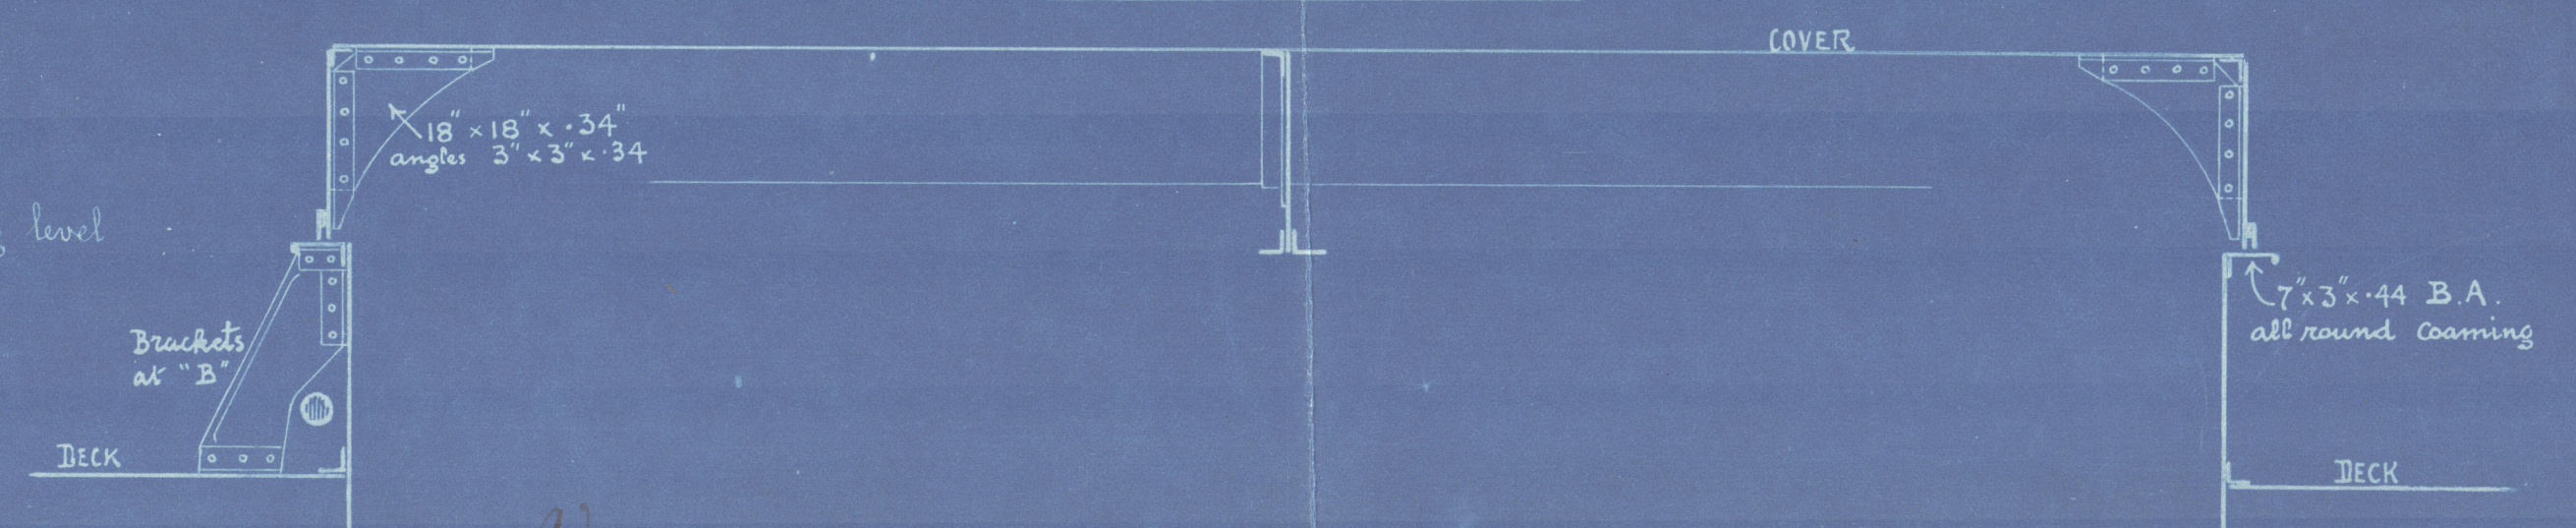

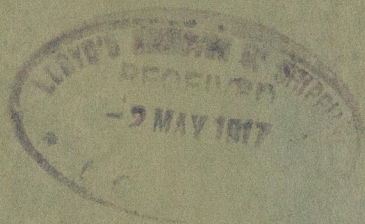

Northumberland's No 244

29 9 ✓ 20 0

17 0 ✓ —

34 0 ✓ —

Stitch cover:

CLAN Macvicar

Now "DOVER HILL".

© 1882.

Lloyd's Register
Foundation

W173-0160