
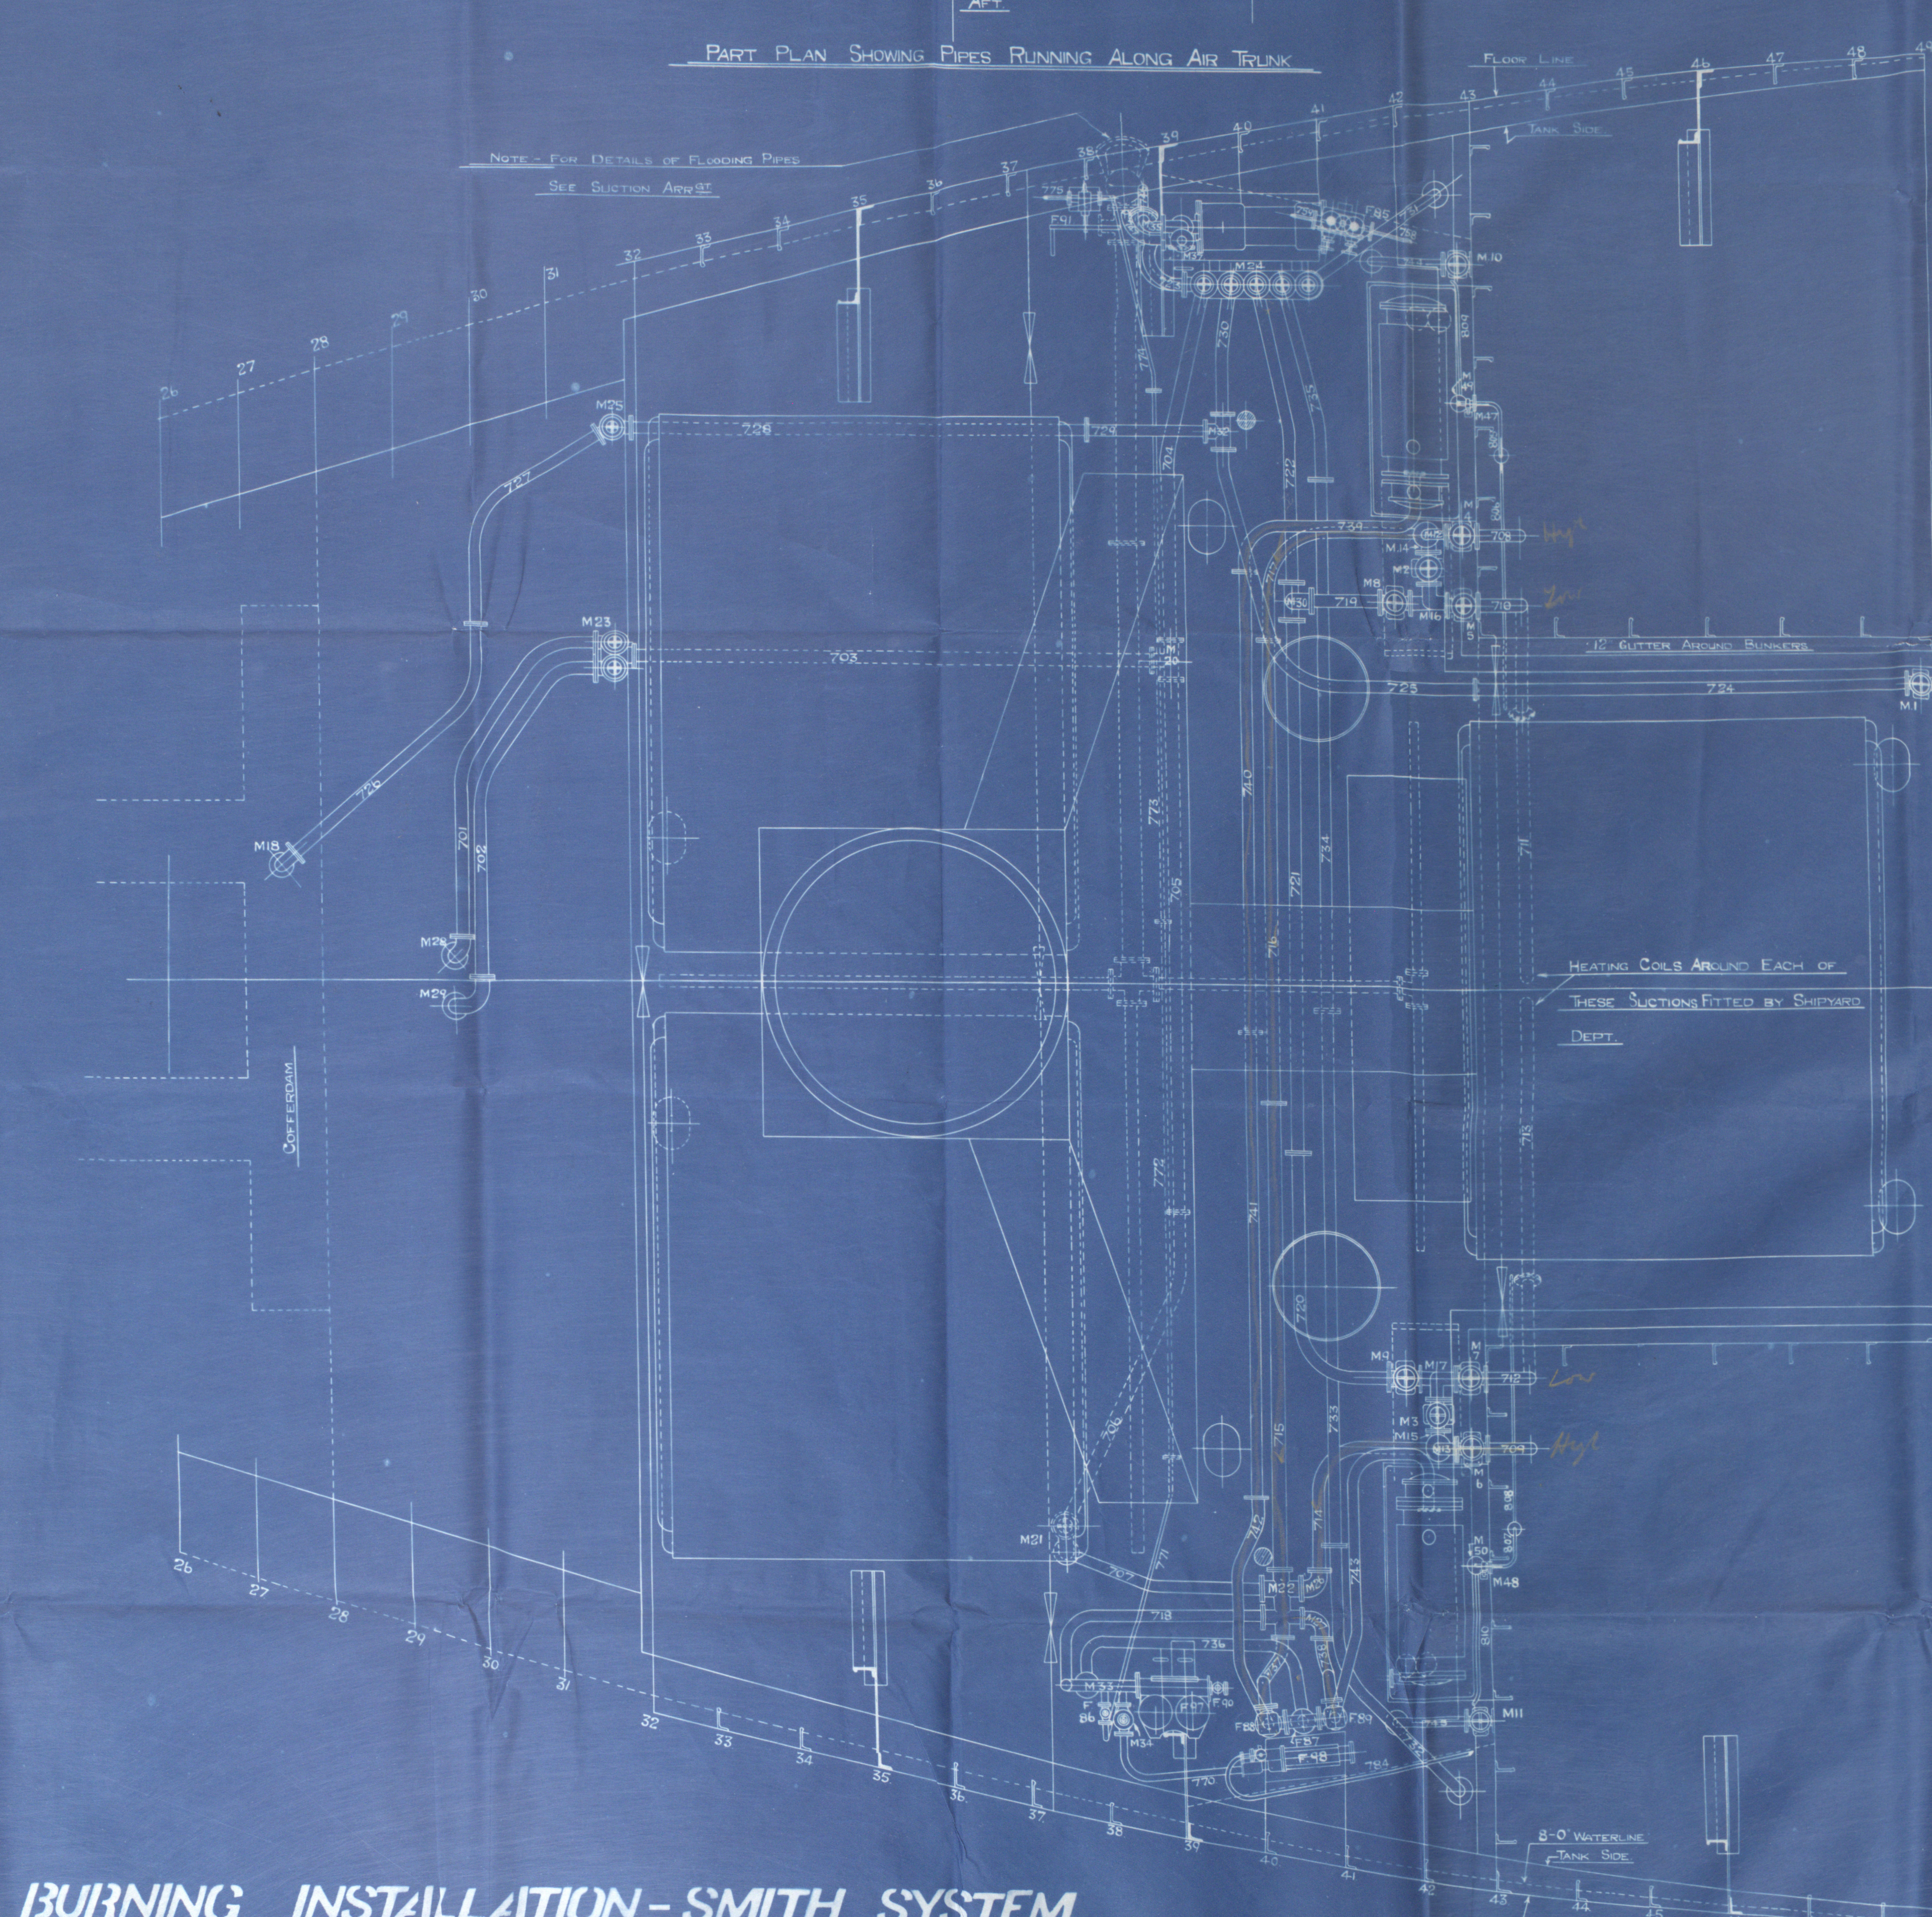
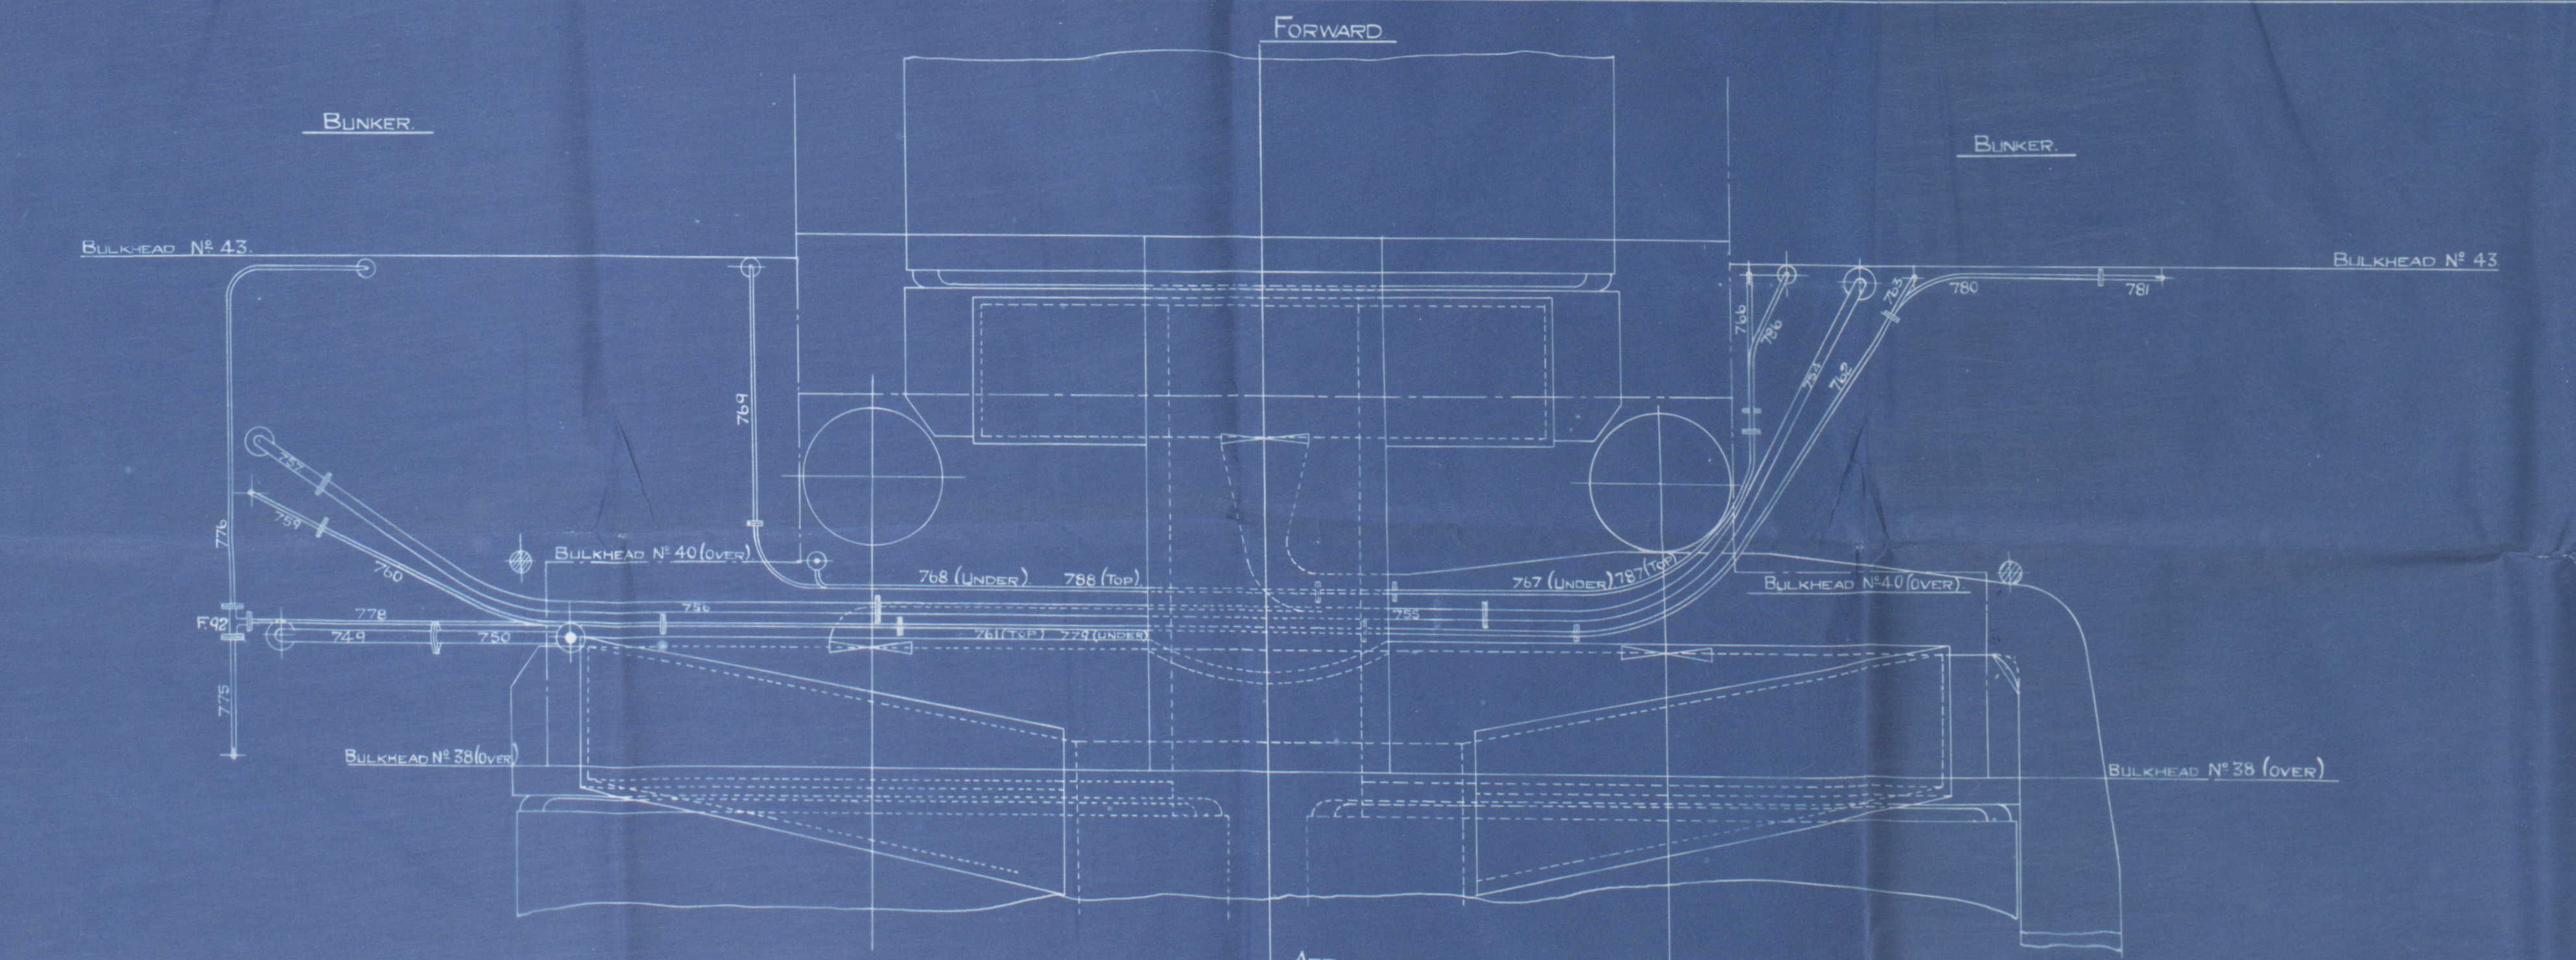


184122

FOR FURTHER PARTICULARS OF OBSERVATION
TANK SEE STEAM & EXHAUST DIAG. I

FOR FURTHER PARTICULARS OF OBSERVATION
TANK SEE STEAM & EXHAUST DIAG. I

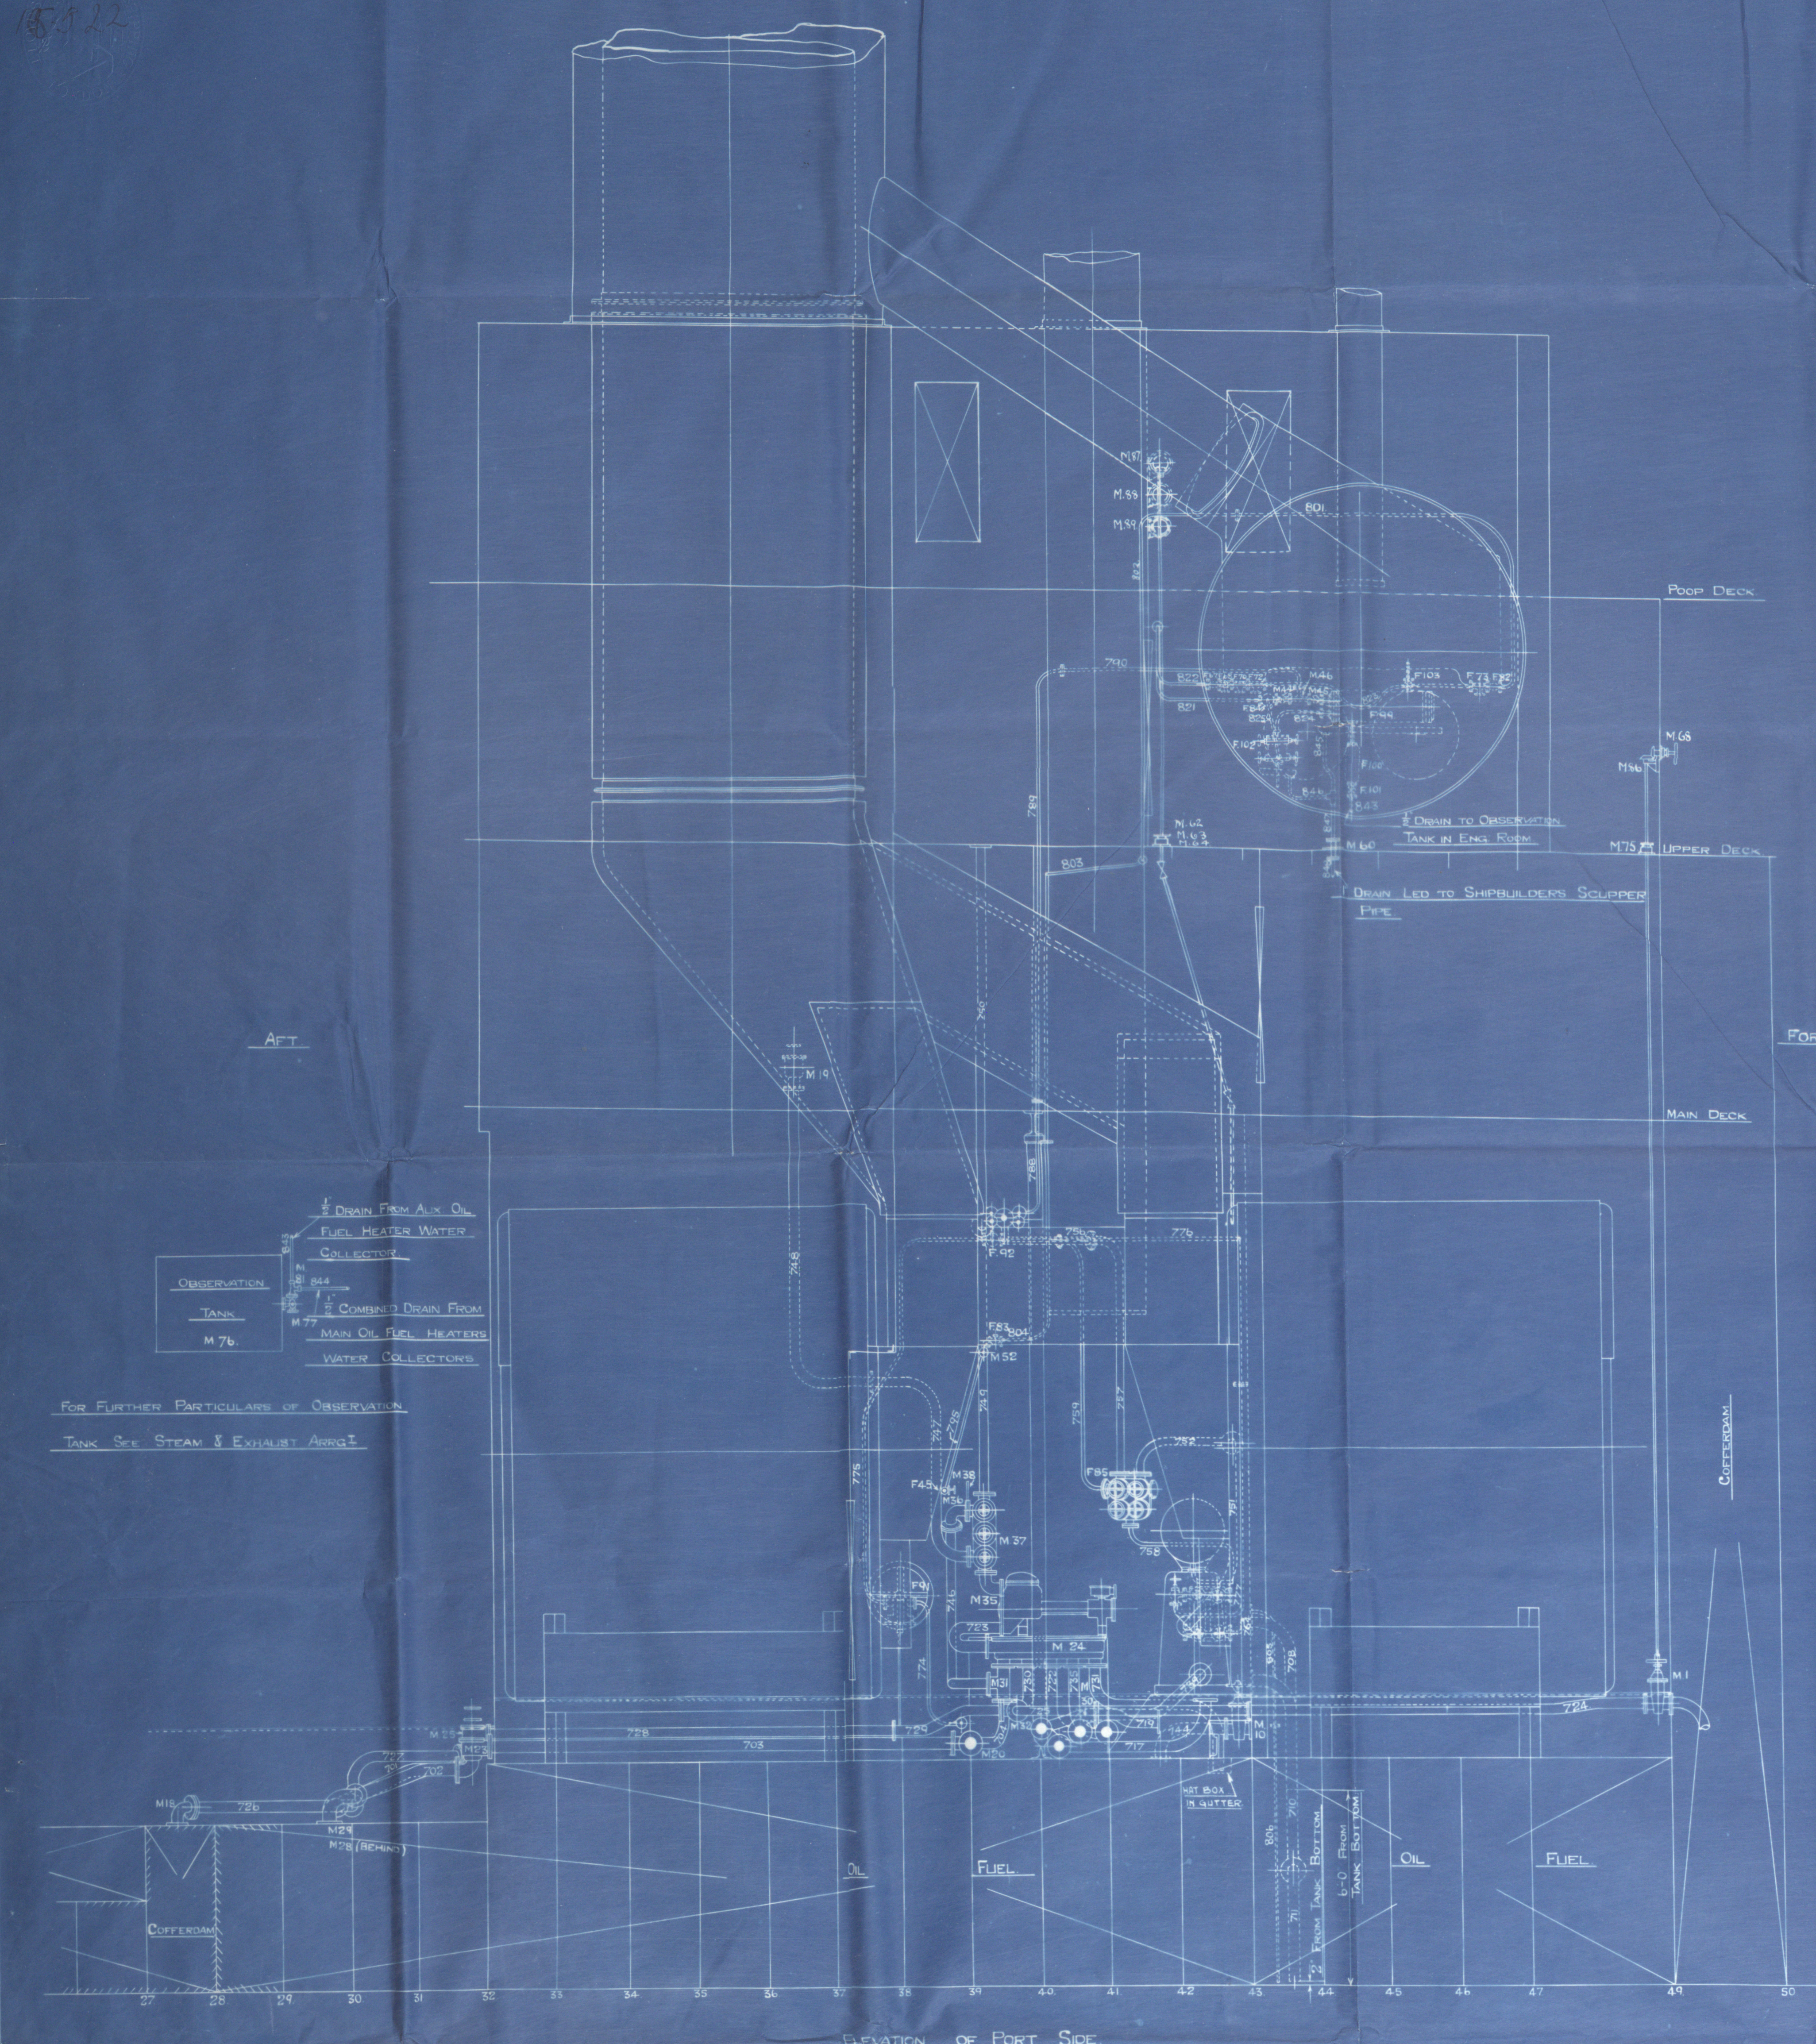

ARRANGEMENT OF OIL BURNING INSTALLATION-SMITH SYSTEM
IN 2 SHEETS
SHEET NO. 1

SCALE - 1/4" = 1 FOOT

THE FLAME POINT OF THE OIL FUEL TO BE
ABOVE 100° AND THE REMAINING FIGURE
RATES OF SECTION 41 OF THE RULES TO
BE COMPLIED WITH.

1/100

1/100

Nº 105-931

Nº 28492

102-0033

ENG Nº 93-71

Calmer Co Ltd

No 931


Oil burning installation

[Signature]

C/o BRITISH PERCEANT.

NEWCASTLE ON TYNE.

Report No. 45051

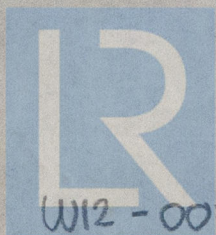

© 2021

Lloyd's Register

W12-0033 Foundation