



COCHRAN PATENT VERTICAL MULTITUBULAR BOILER.

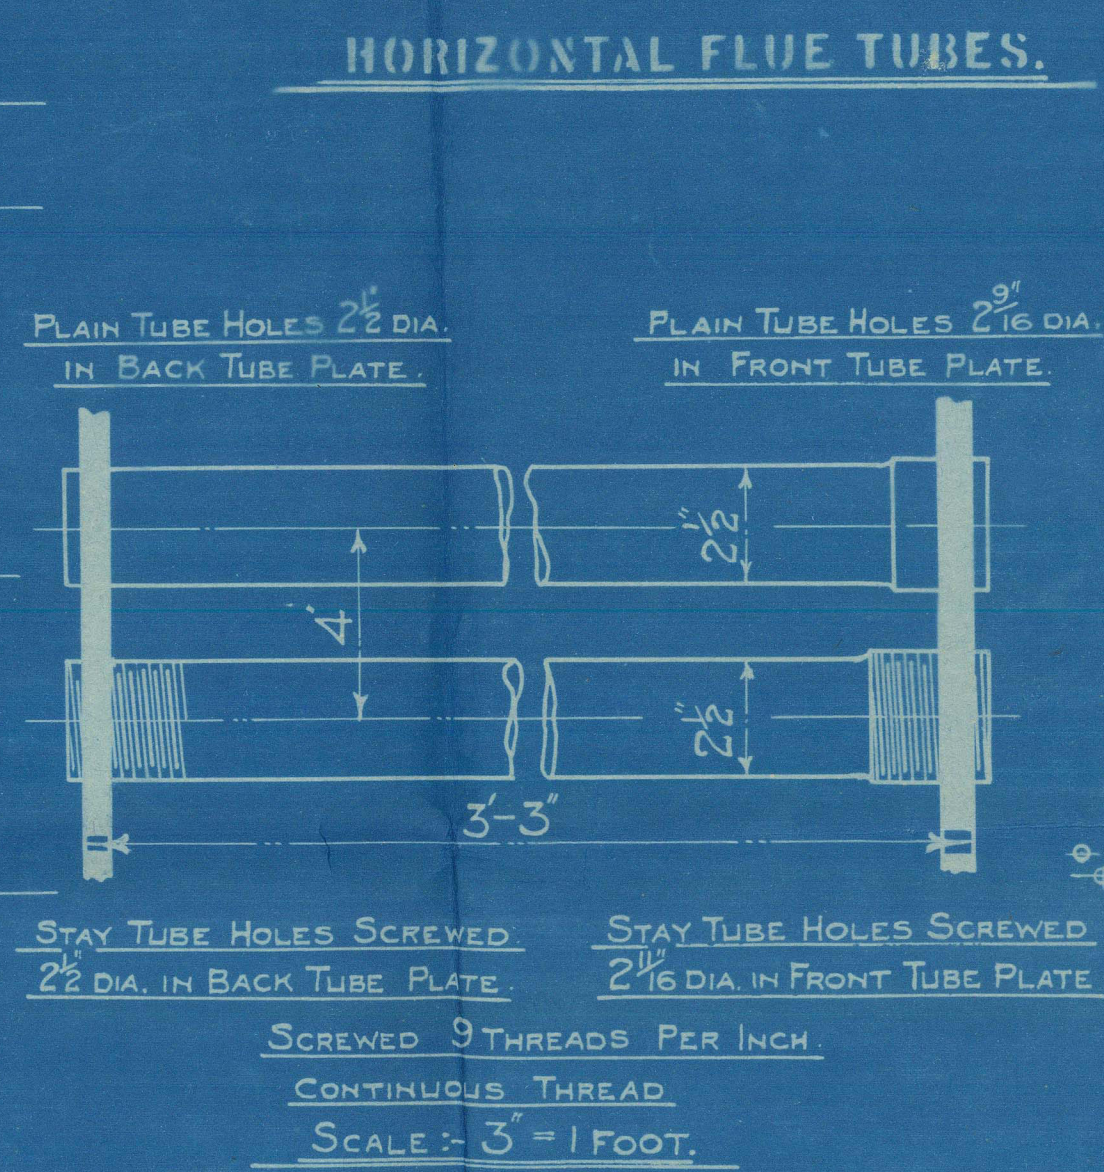

COCHRAN & CO. ANNAN LTD.
ENGINEERS & BOILERMAKERS
ANNAN, SCOTLAND.

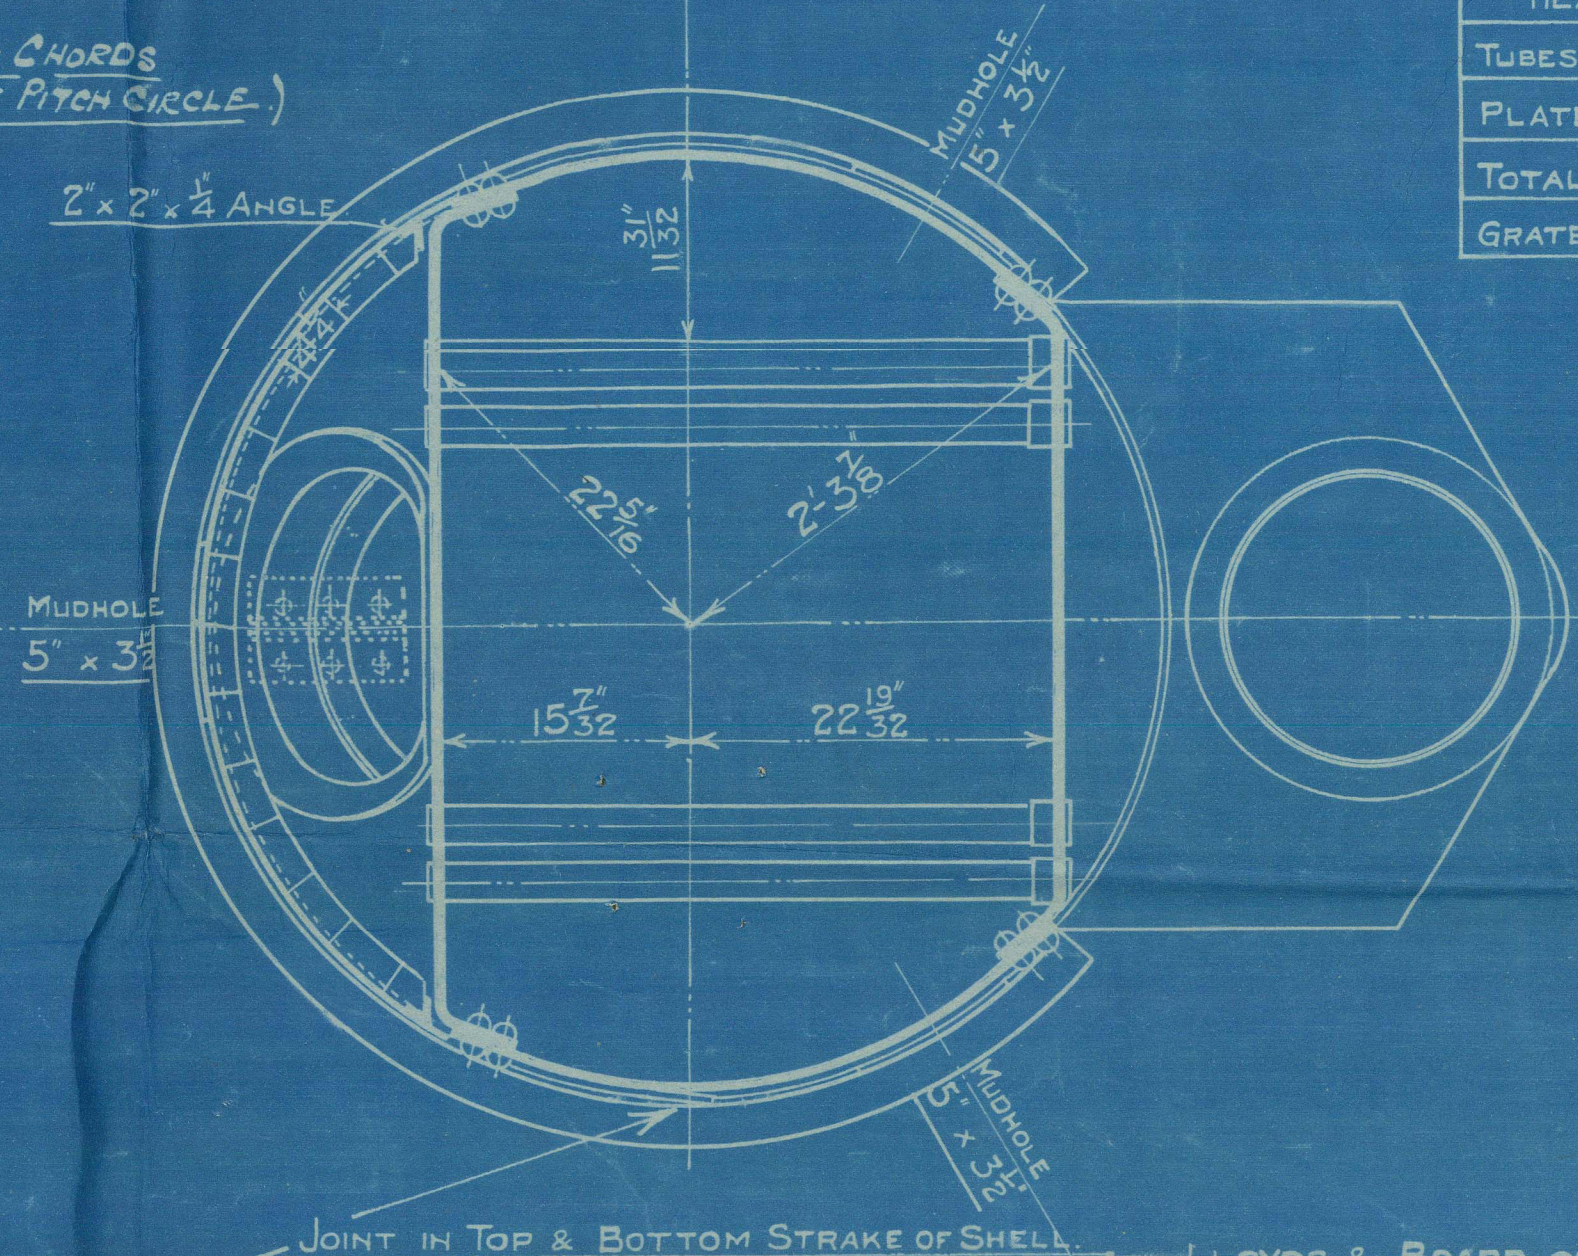

similar to Drawing No. 12835 approved 29. 8. 21. for Boilers No. 8851 & 8852.
craft Different width of cockpit opening & Manhole on opposite quarter.

PATENT BOILER N^o 8787.
5'-0" x 13'-0" x 220⁰ x 100_r LBS. W.P.

N.R.

SURVEY:- LLOYDS & BOARD OF TRADE.

PLAN OF SHELL CROWN JOINTS.

001207-0047 DRAWING № 12747.



Lloyd's Register
Foundation

COCHRAN & CO., ANNAN, LD.

Boiler No. 8987

Drawing No. 12747

100 lbs per sq inch

Similar to Drawing No
12835 except ash pit etc.

GLASGOW REPORT No. 41505

Dumman's

RETAIN



© 2021

Lloyd's Register
Foundation

W1207 0047