


15.6.04

S.S. No. 71.
ELEVATION
DIMS. 116'-8" B.P. x 21'-0" x 12'-6" MLD
SCALE $\frac{1}{4}$ " = 1 FT.

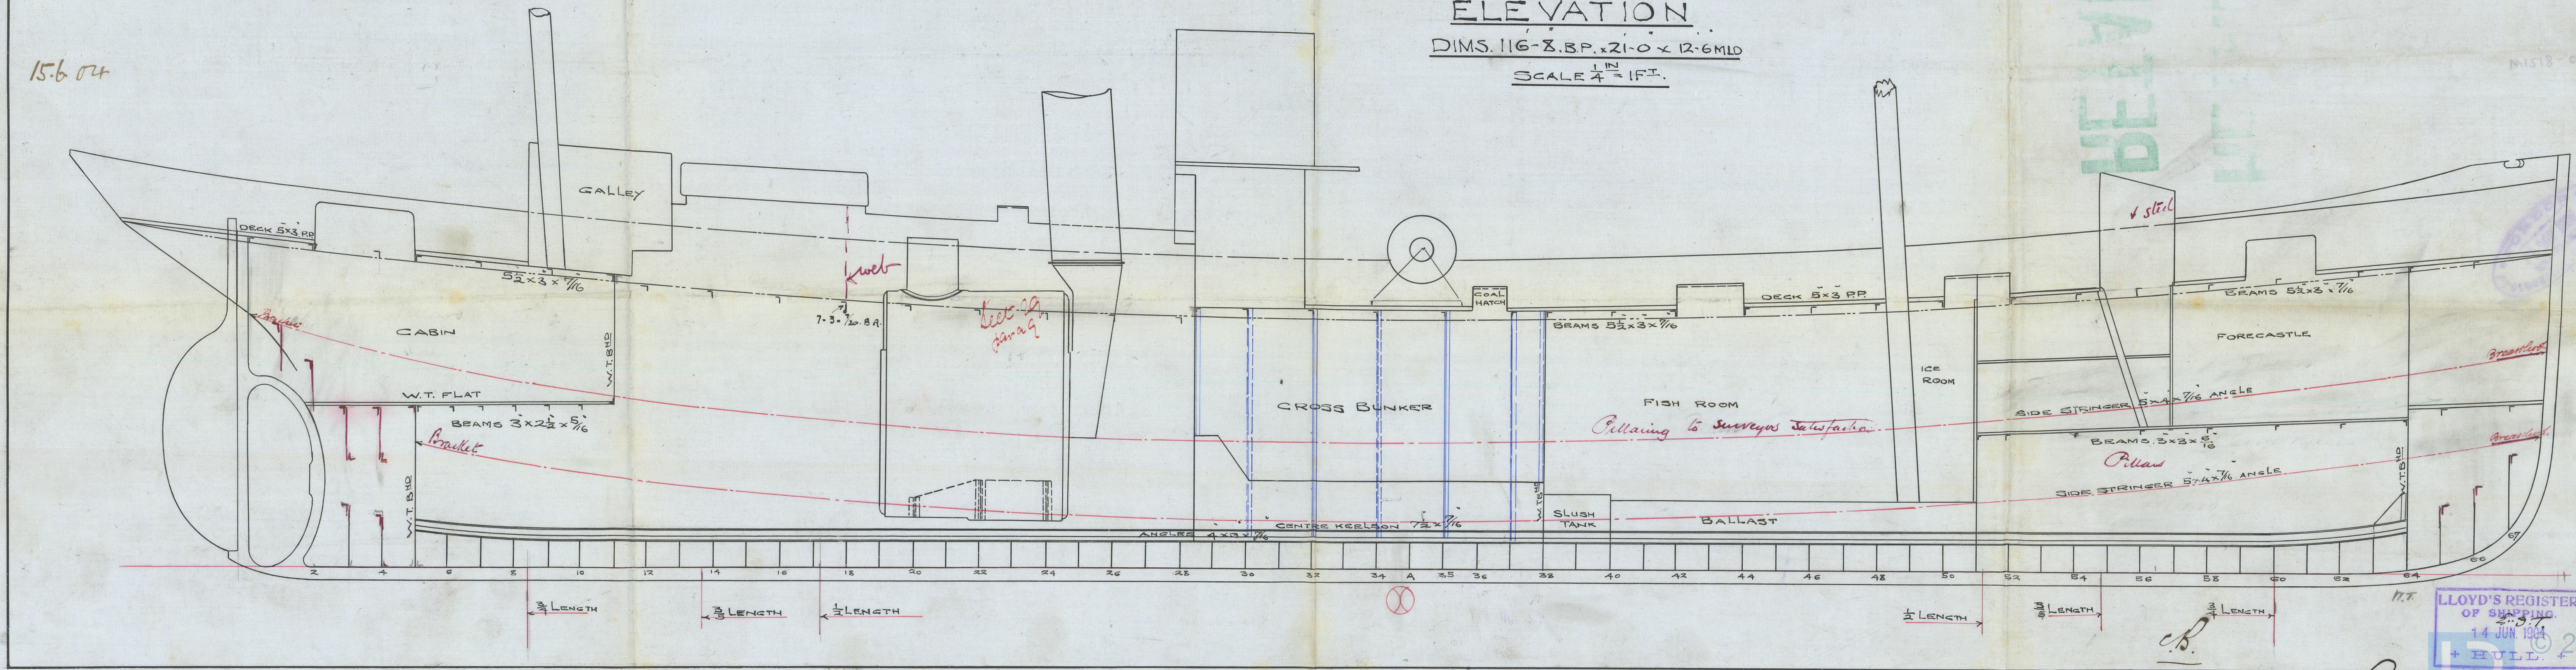

LLOYD'S REGISTER
OF SHIPPING
14 JUN 1904
HULL

Good Shipbuilding
Repairing Co Ltd

W1218-0069

- Profile
Goole S B & Co

No 71

S/S City of York

Null Report No. 16460

W1218-0069

RECEIVED



© 2019

Lloyd's Register
Foundation