



Donkey Boiler.

Heating surface = 180 sq. feet.
Grating " " = 29 sq. feet.
Boiler pressure = 100 lbs.



Minimum tensile strength of Material.

Shell plates 20 Tons.
Shell crown plate 24 "
Furnace 24 "
Furnace 24 "
Cross tubes 24 "

6.4.04
14.4.04

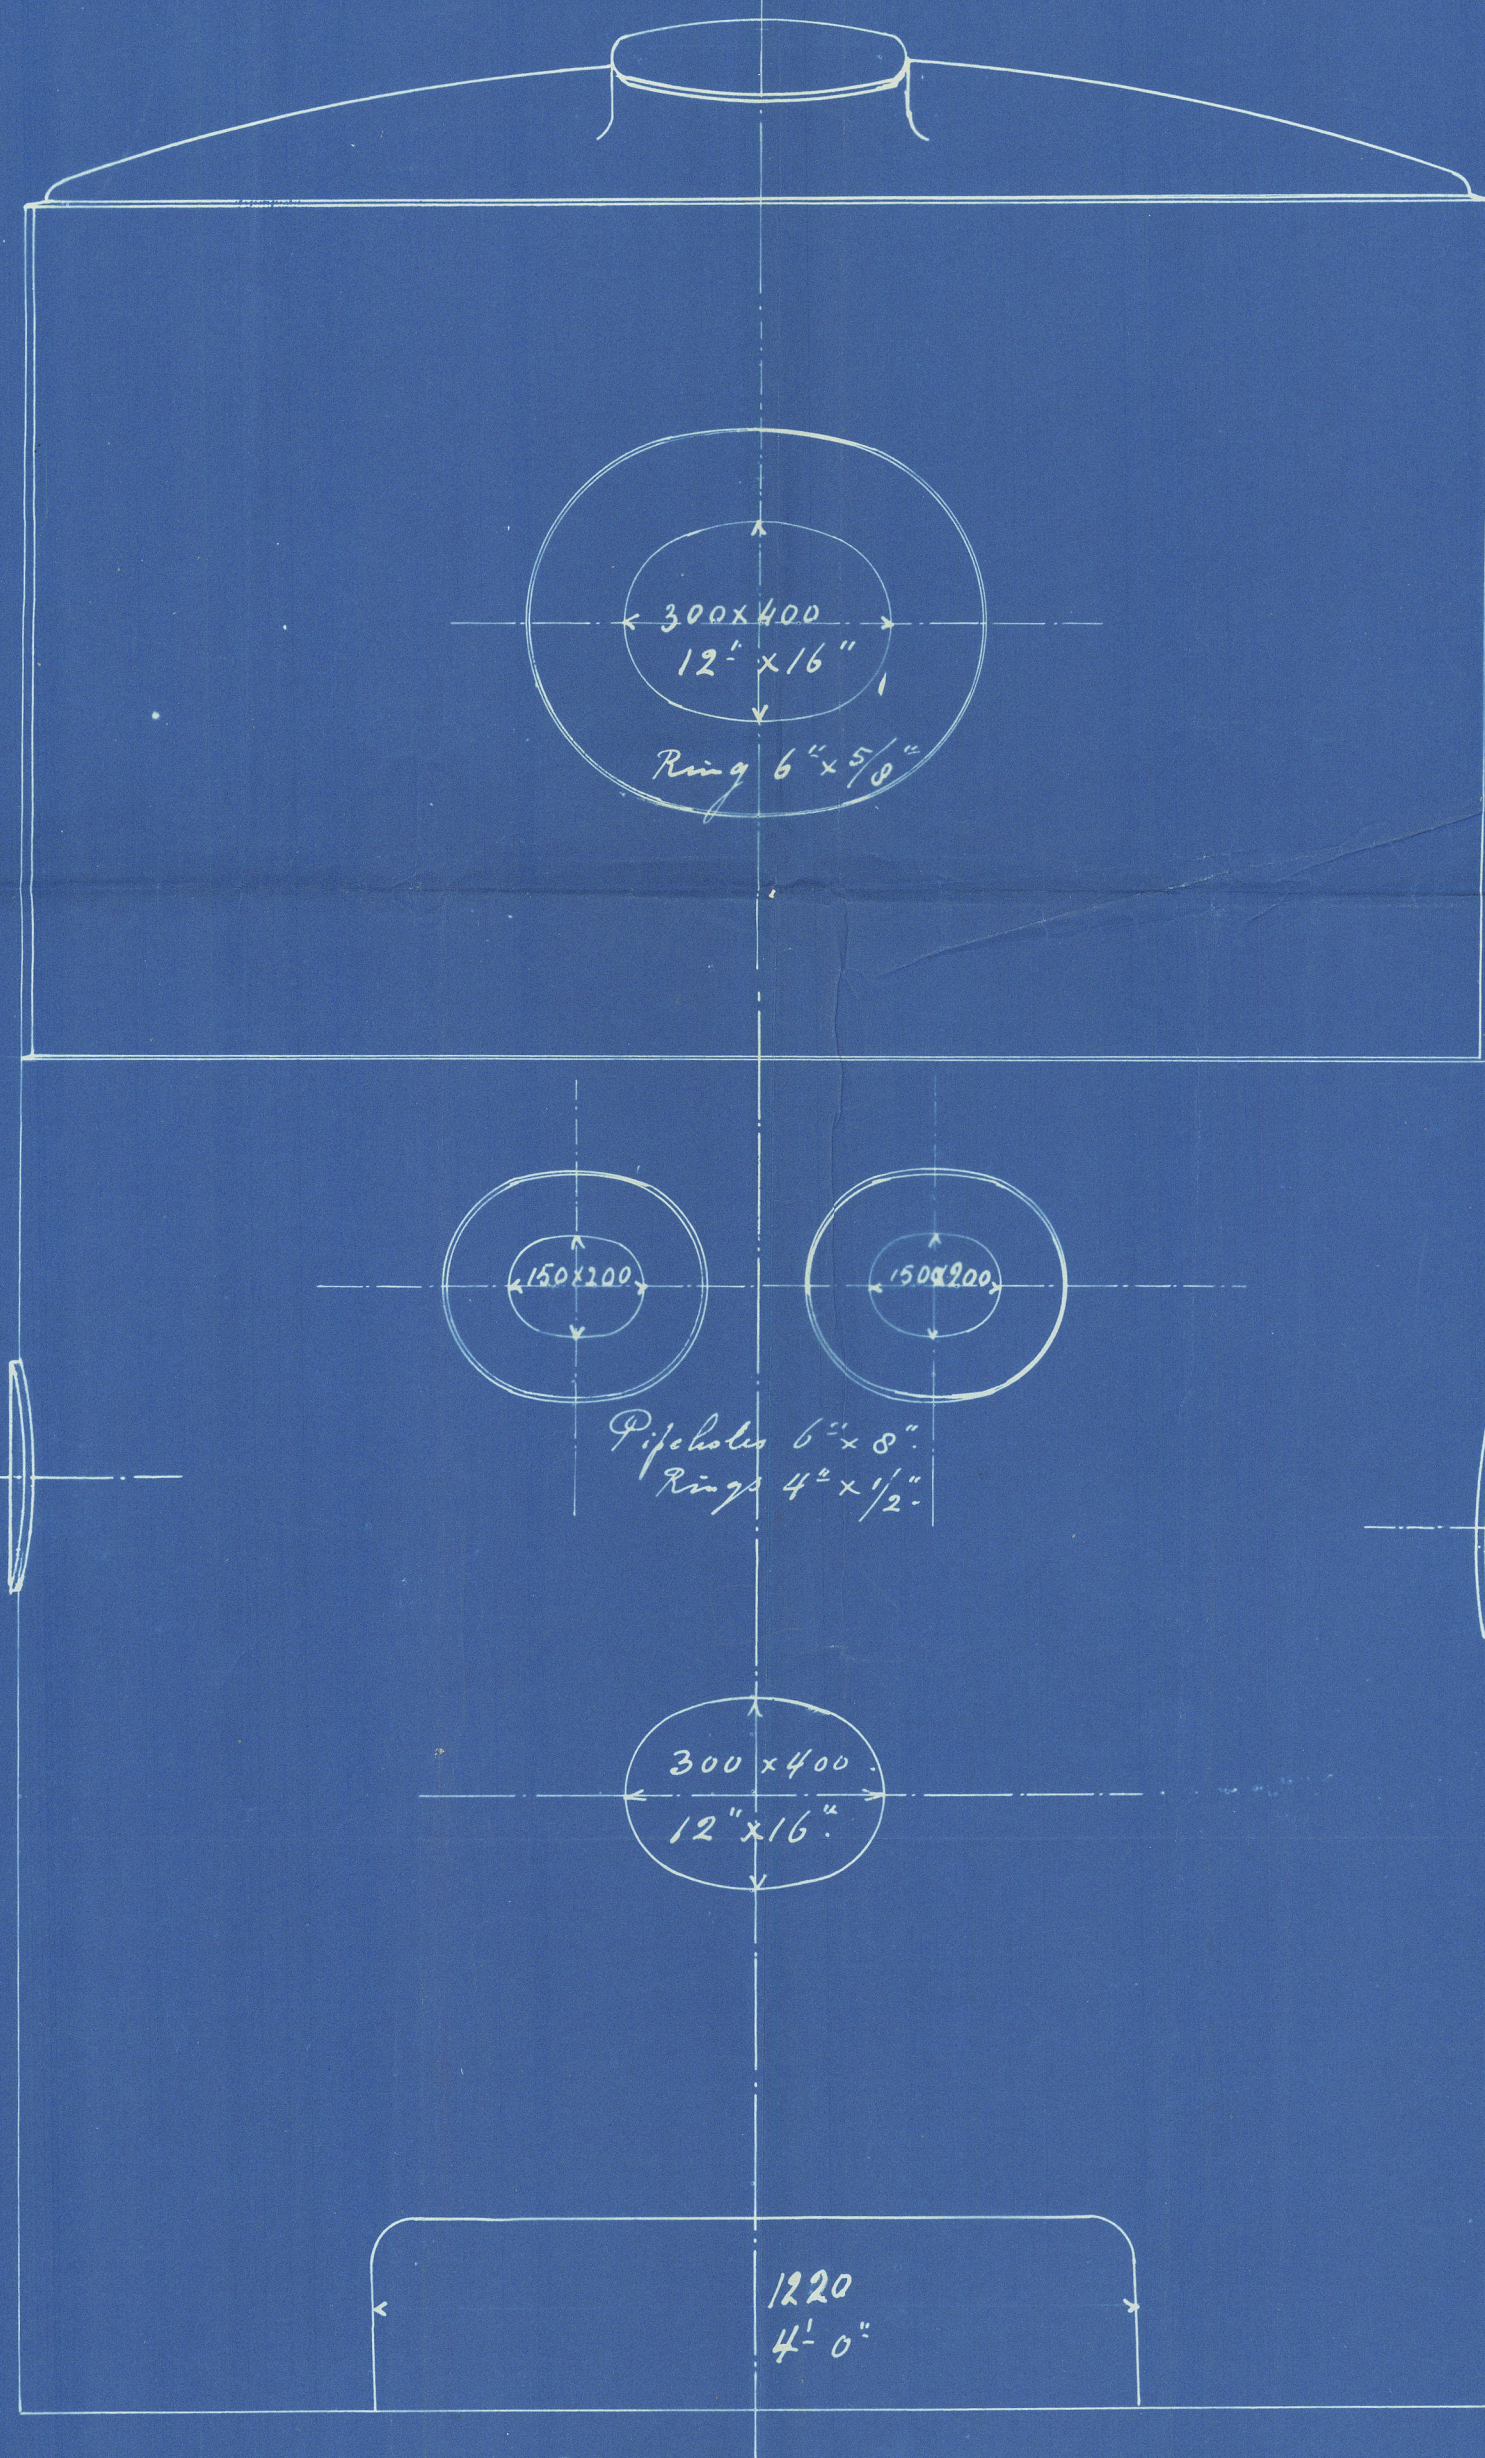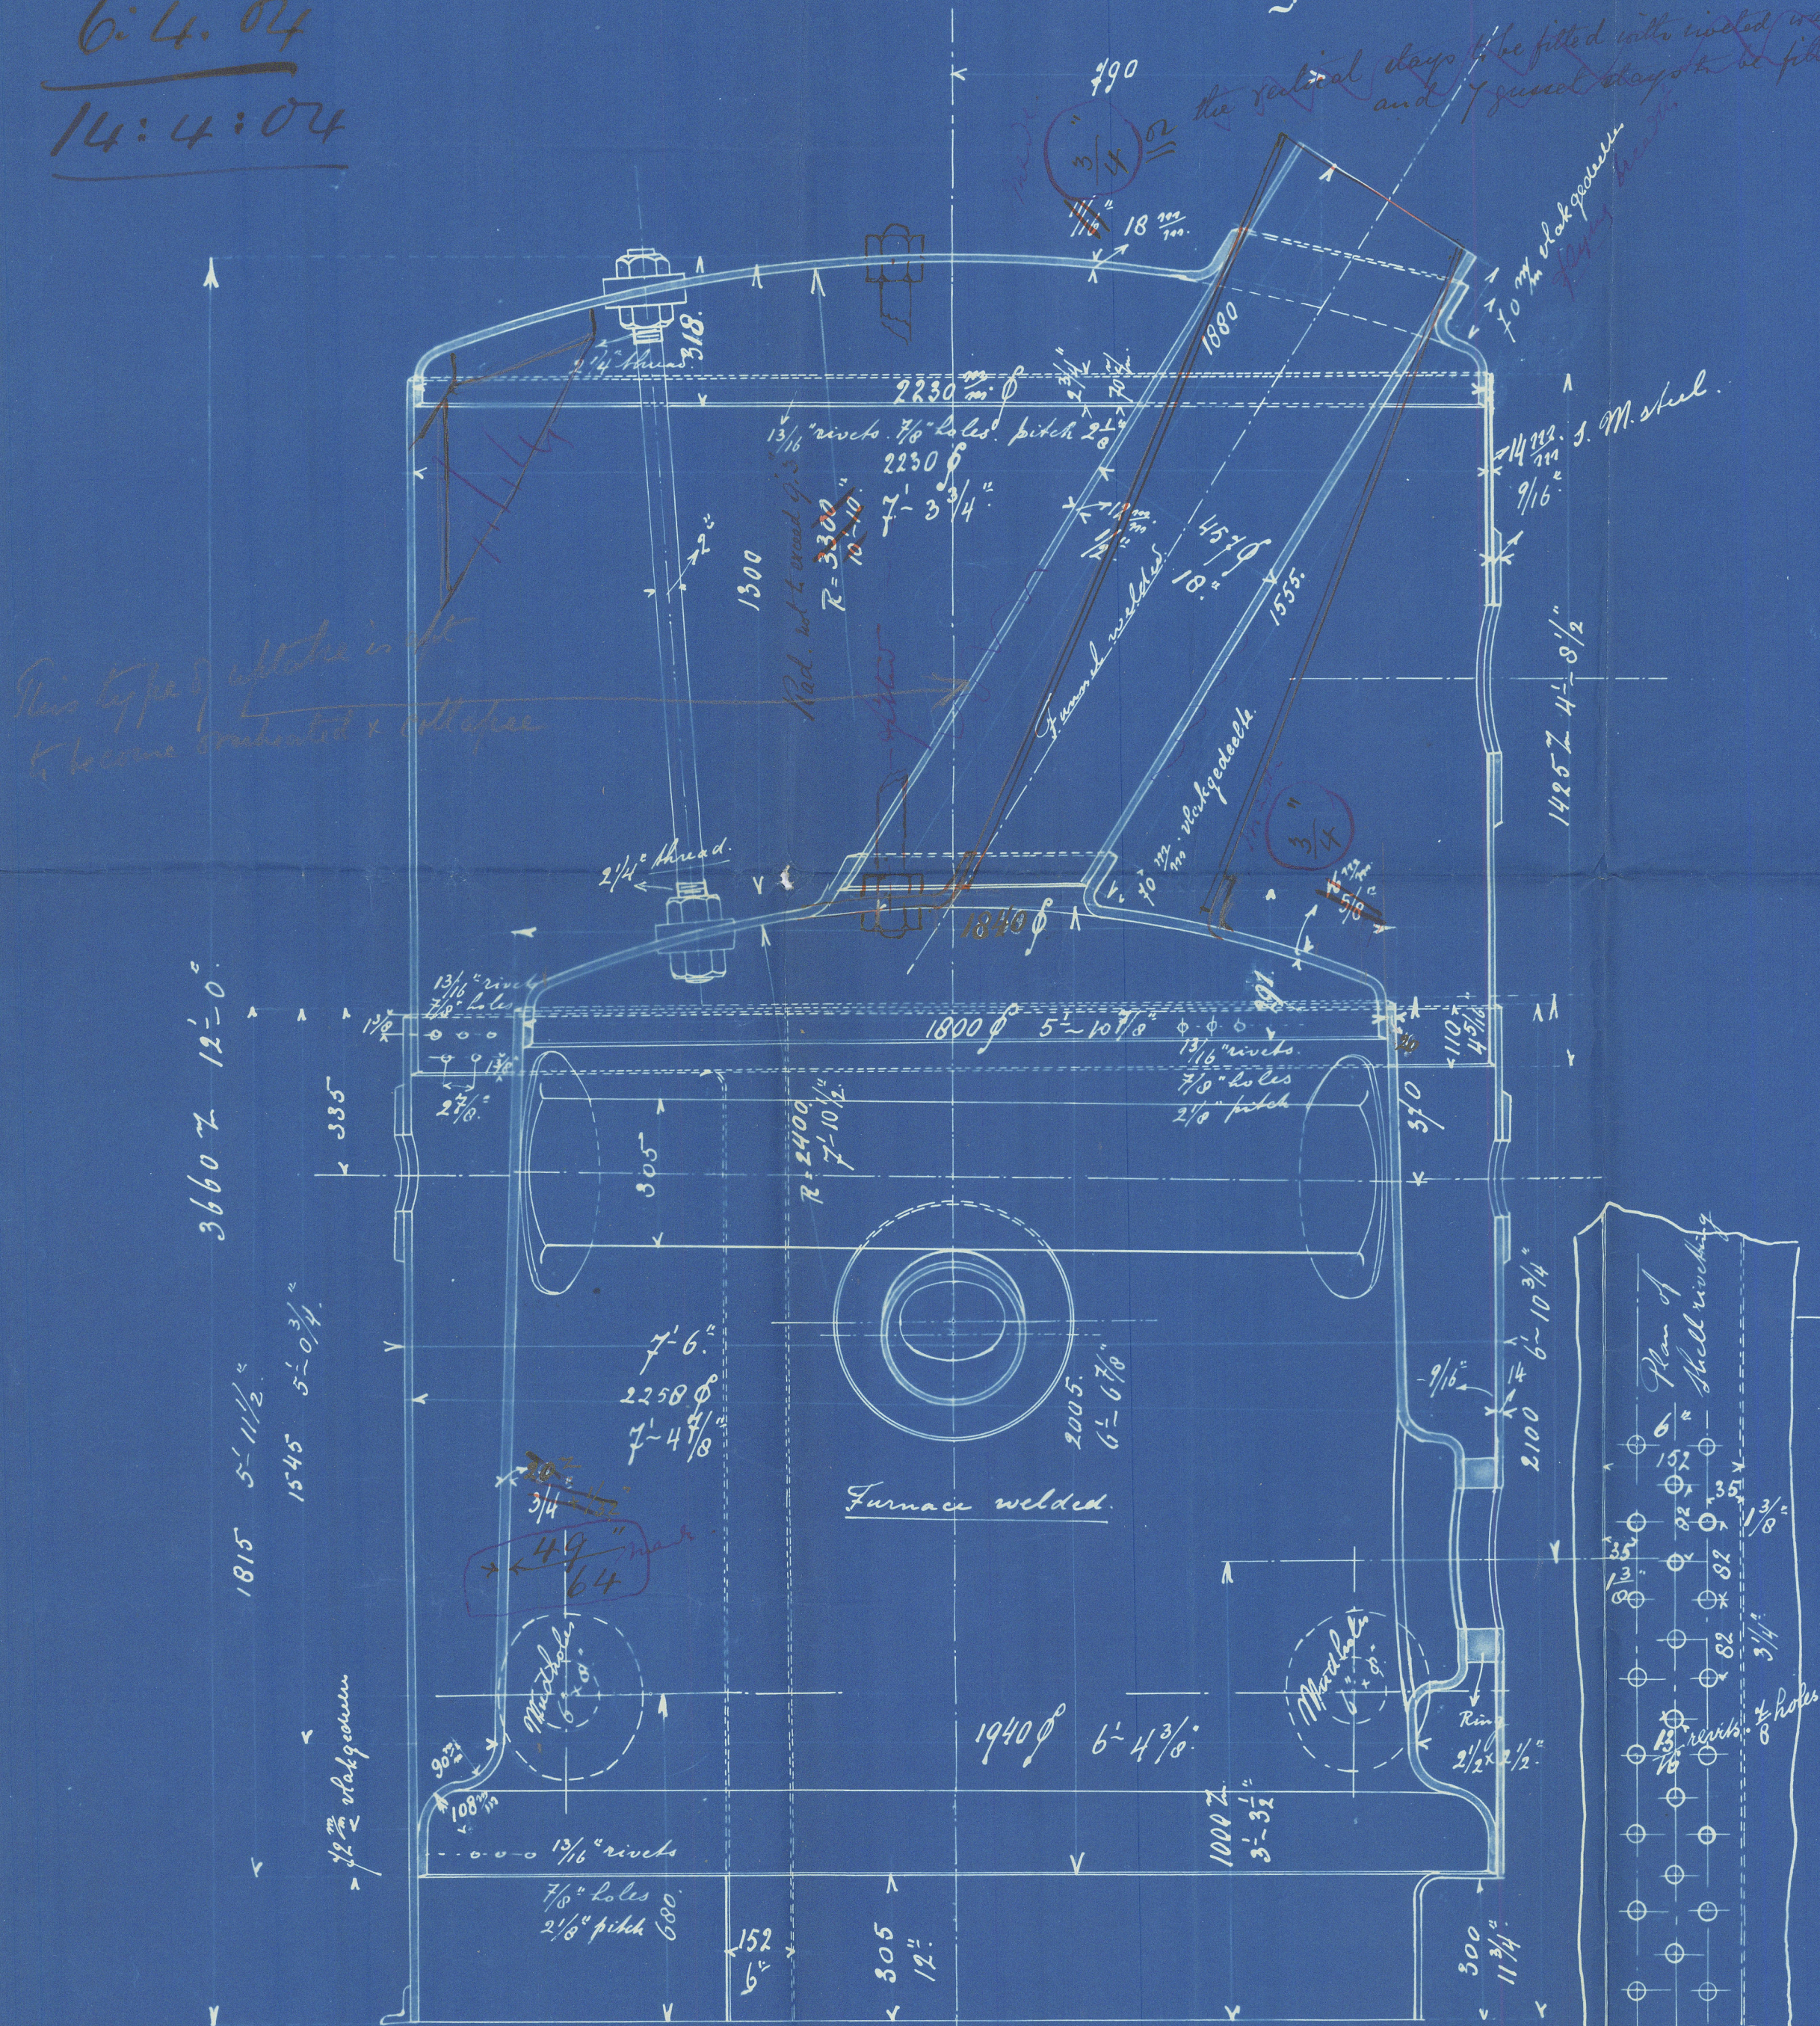


All holes are drilled.

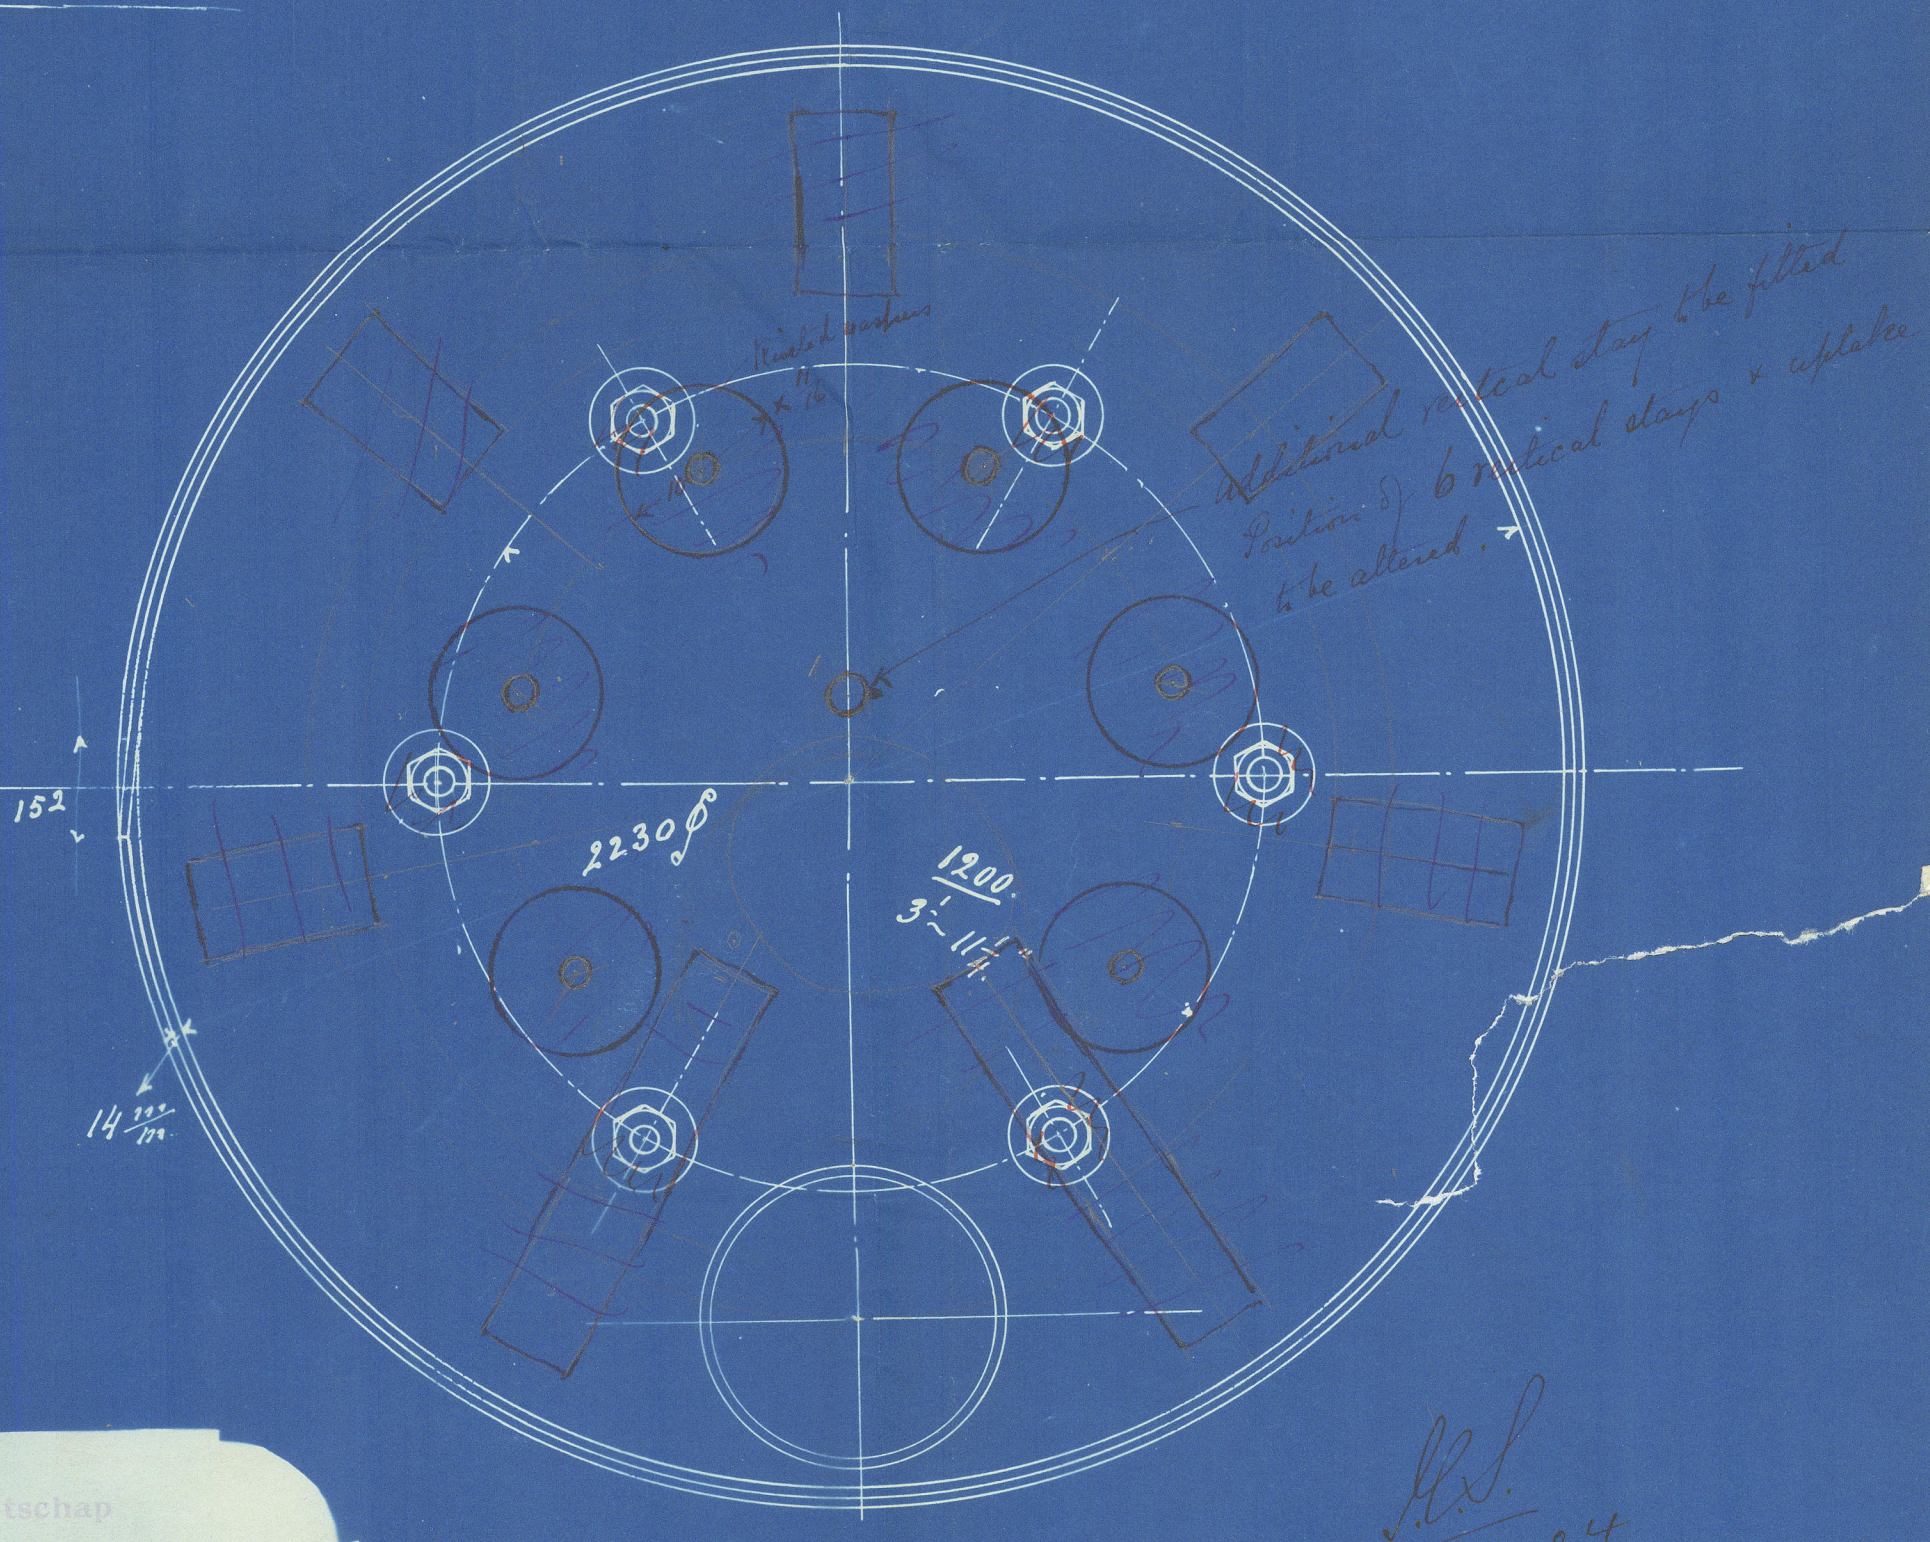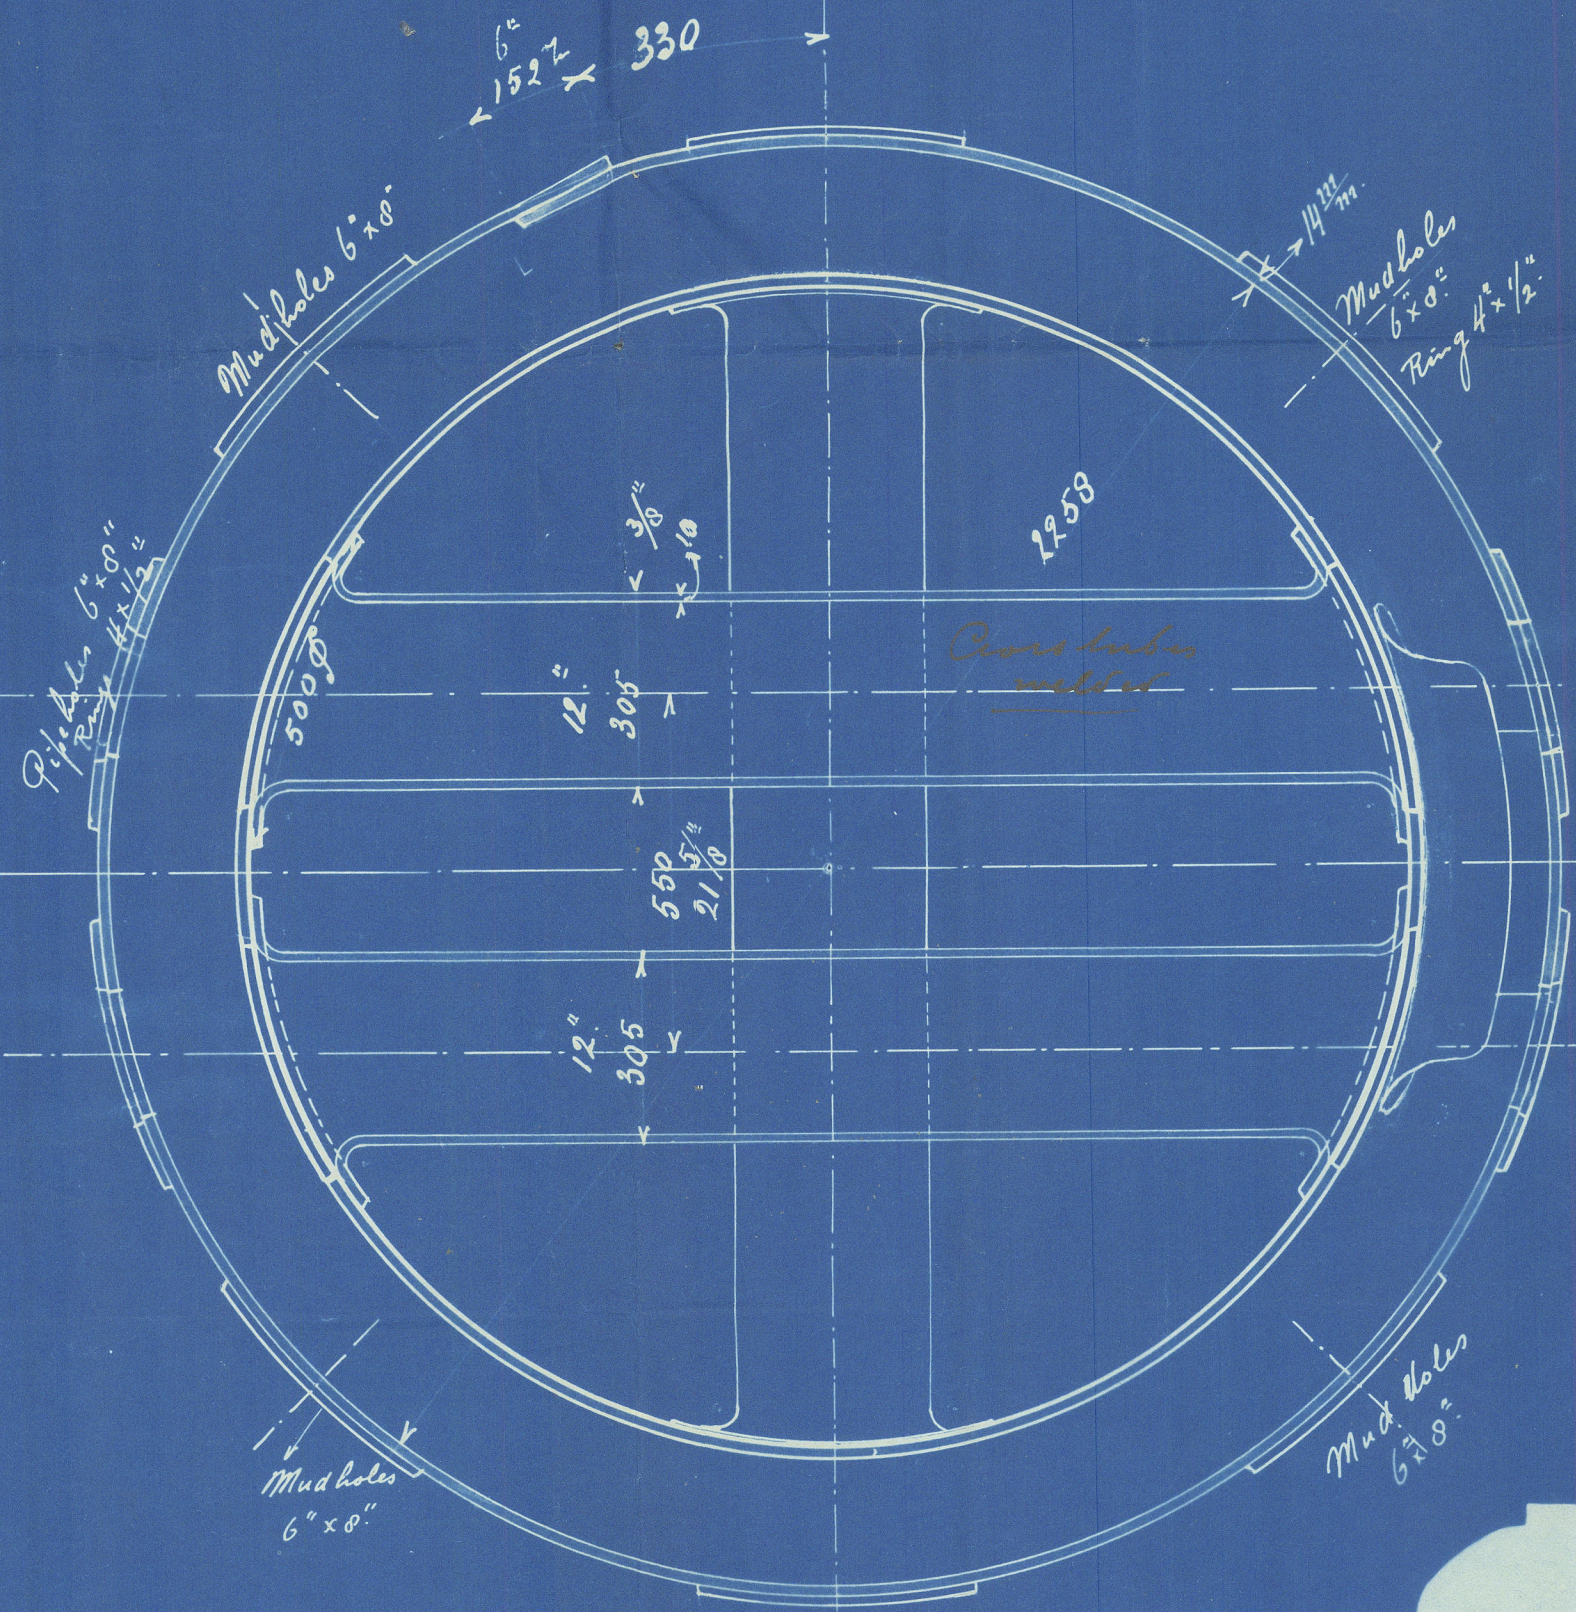


Naamloze Vennootschap
Albassersche Machinefabriek
Albasserdam
Date: 25 Maart '04.
Comp. No. 100 en 101.
Recht No.
Gezien: R. J.

6.4.04


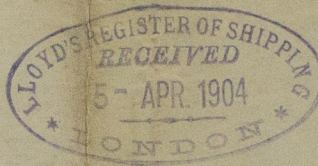


REMAIN

Dist. on 1st.
88. Kingwood
2/1000 report.
4/100.

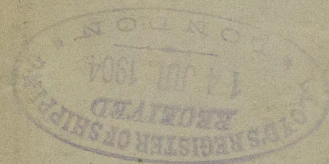

J.S. Greenwood.
Kingwood
Staking brick
Port of birth den
Report No 4030
3

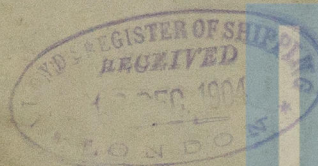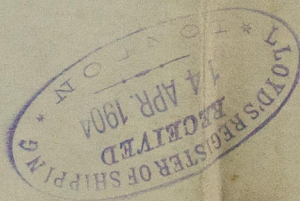

© 2020

Lloyd's Register
Foundation

W1230-0155