
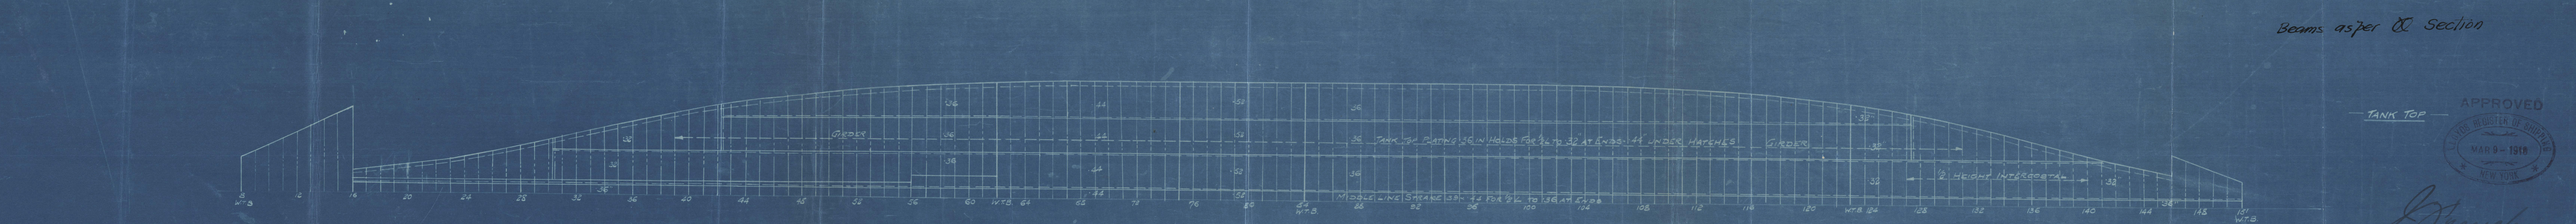
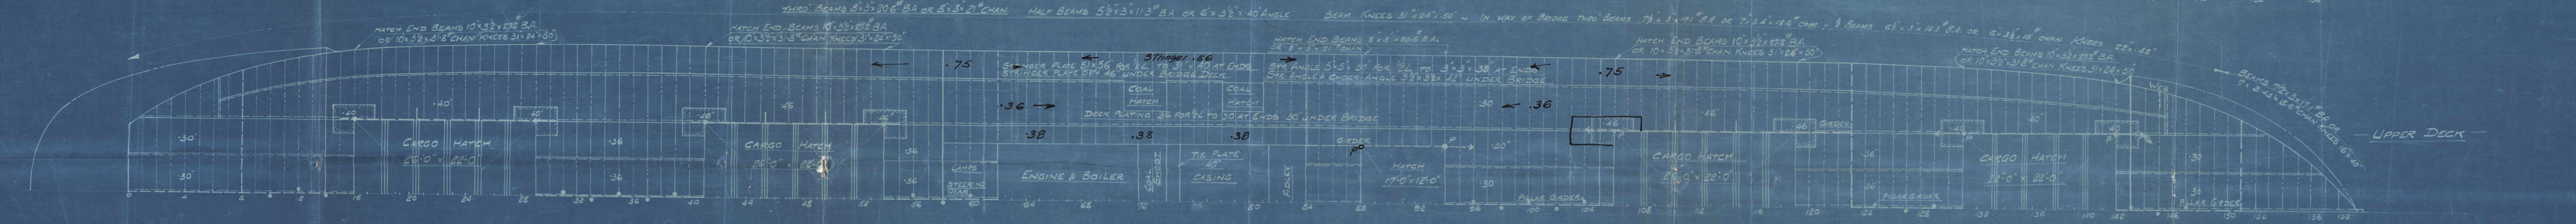
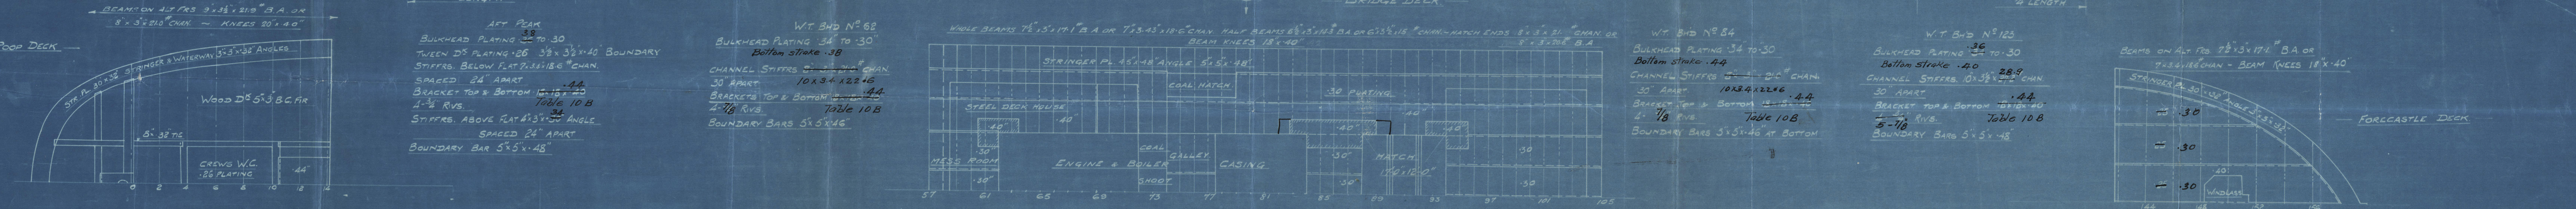
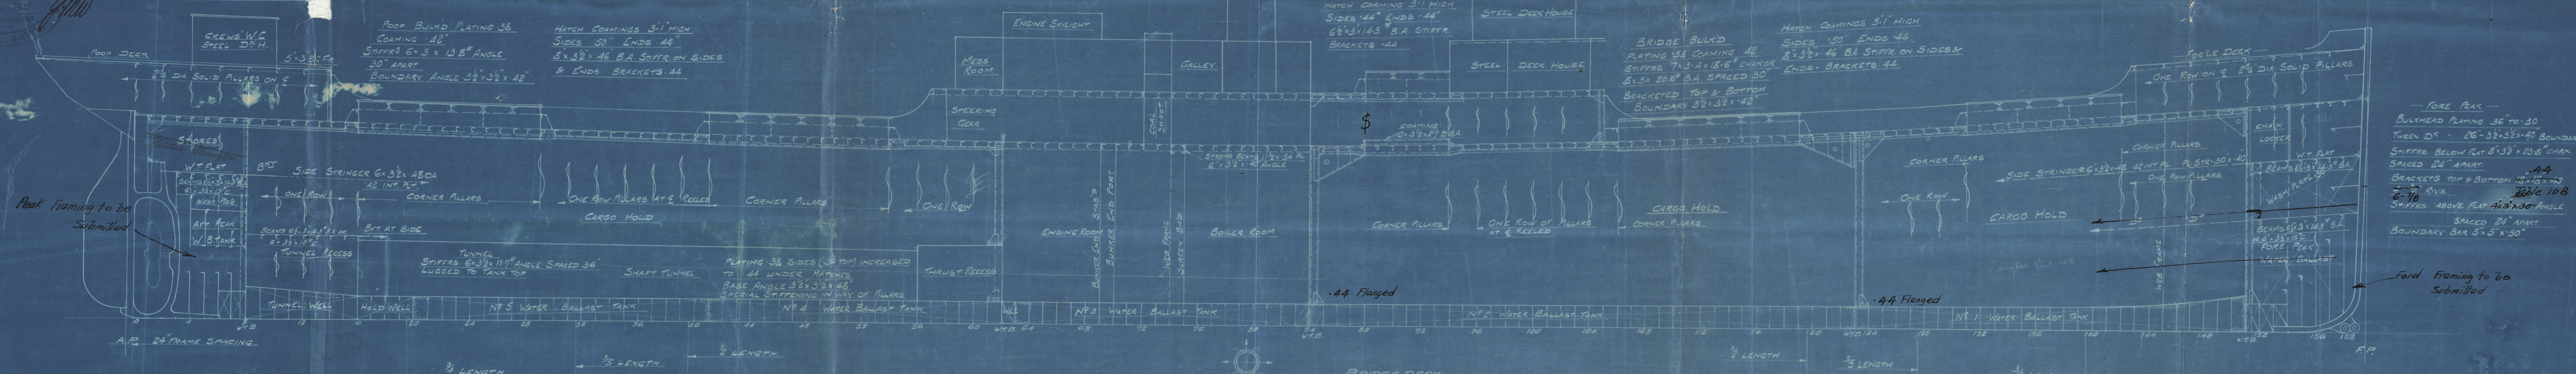


SHIP NO. 100
PLAN NO. 3

STEEL SCREW CARGO STEAMER SINGLE DECK TYPE

The William H. Wood
Tank & Shipbuilding Co.

LENGTH = 320'-0" B.P.
BREADTH = 44'-0" M.D.
DEPTH = 25'-0" M.D.

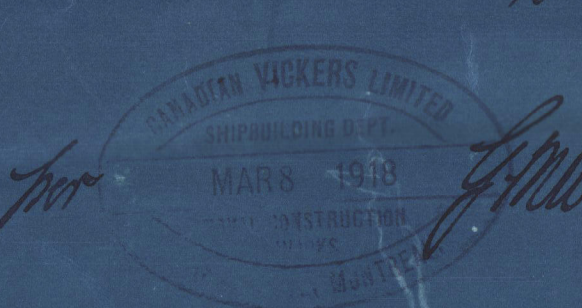

Beams as per Section

TANK TOP
APPROVED
MAR 9 - 1919
NEW YORK

J. H. Wood

Wallace Shipyard
Steel Screw Single deck Steamer
No 100

Approved March 8th 1918.

Profile & Deck Plan

W1245-0091




© 2020

Lloyd's Register
Foundation

Wallace Shipyards Ltd.
Vessel No. 106
Canadian Trooper"
Profile & Deck Plan.

Ver. 751

RETAILED

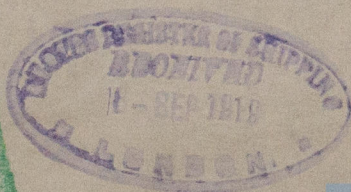

© 2020

Lloyd's Register
Foundation

W1295004