

28344
No. 12684

Lloyd's Register of British & Foreign Shipping

SURVEYS FOR FREEBOARD.—STEAM SHIPS.

JUE. FEB. 15 1921

PARTICULARS RELATING TO ALL STEAM SHIPS EITHER FLUSH DECKED, OR WITH TOP GALLANT FORECASTLES, SHORT POOPS AND BRIDGE HOUSES DISCONNECTED, OR WITH TOP GALLANT FORECASTLES HAVING LONG POOPS, OR RAISED QUARTER DECKS CONNECTED WITH BRIDGE HOUSES, OR OTHERWISE.

Fro QUEEN GRANDE *Buenos Aires*

Ship's Name.

SCOTSTOUN HEAD.

Number in Register Book

Port of Registry
and Nationality.Leith
BritishOfficial
Number.

145551

Gross
Tonnage.410
437.59

Date of Build.

1921.

Port of Survey

Aberdeen

Date of Survey

While building

Name of Surveyor

Ridley Youell

Particulars of Classification.

100 A1 (Contemplated)

Registered dimensions from Ship's Register.	Length.	Breadth.	Depth.	Under Deck Tonnage.
	150.9	24.1	9.3 6 <i>inner bottom</i>	282.3
Length on N.E.	150.0	Frame Depth 4 ft Rule "2 x 1/4"	Mean Ceiling fitted Sheer + .56	Peak Included Tanks Tank top to ordy level. - 5.66
TED IONS.	150. ✓	23.94	9.849	246.64 ✓

$$\text{icient of fineness} \dots \frac{276.64 \times 100}{150 \times 23.94 \times 9.869} = .488$$

$$\text{modification necessary } \dots \text{ara. 4 (a) to (e)]*} \dots .02 \checkmark$$

$$\text{icient as corrected} \dots .46 \checkmark$$

$$\begin{aligned} \text{Stem} & 62.25 \\ \text{Sternpost} & 23.5 \quad \left\{ \frac{89.45}{2} = 44.845 \right. \text{Mean} \quad \frac{45.25}{25.0} \\ & 23.5 \quad \left\{ \frac{89.45}{2} = 44.845 \right. \text{Mean} \quad \frac{36}{20.23} \\ \text{at } \frac{1}{2} \text{ of the length from Stem} & 35.0 \quad \left\{ \frac{49.45}{2} = 24.845 \right. \text{Mean} \quad + .56 \\ \text{Sternpost} & 14.35 \quad \left\{ \frac{49.45}{2} = 24.845 \right. \text{Mean} \quad \div .55 \\ \text{usual mean Sheer} & 45.05 \quad \left\{ \frac{45.05}{2} = 45.23 \right. \text{Mean} \\ \text{standard mean Sheer [Table, Para. 18]} & 25.0 \quad \text{Correction} \\ \text{Difference} & 20.05 \quad \left\{ \frac{20.05}{4} = 5.01 \right. \text{Mean} \\ \text{limited as Para. 18 (f)} & \dots \quad \dots \quad - 5" \checkmark \end{aligned}$$

she in Sheer { At front of bridge house ✓
in amidships { At amidships ✓
Para. 18 (e) { At after end of forecastle ✓

all in Sheer { $\div 2 =$ ✓
Para. 18 (d) {
length uncovered Correction

ALLOWANCE FOR DECK ERECTIONS:

$$\begin{aligned} \text{board, Table C} & 337 \quad 3\frac{1}{4} \checkmark \\ \text{ection for Length, if required (Para. 12, 13, and 14)} & \checkmark \\ \text{board by Table A, corrected for sheer, and for length, if required (Para. 12, 13, and 14)} & \left\{ \frac{1-3-11}{1-3-11} \quad \frac{1\frac{1}{2}}{1\frac{1}{4}} \right. \checkmark \\ \text{ference} & 11.74 \quad 11\frac{3}{4} \checkmark \\ \text{percentage as below} & 66.2\% \\ & \quad - 4.44 \checkmark \end{aligned}$$

$$\begin{aligned} \text{ection for R. Q. Dk. if engine and boiler openings not covered by bridge house (Para. 11)} & \left\{ \frac{.13}{4.64} \right. \checkmark \\ \text{vance for Deck Erections} & \left. - 3\frac{1}{2} \right. \checkmark \end{aligned}$$

	Length.	Length allowed.	Height.
castle. <i>Closed</i>	16.5	19.35	6' 6"
castle. <i>Open</i>	3.5		
ge House	12.25	12.25	4' 0"
ised Qr. Dk.	84.5	84.5	4' 0" ✓
Total	110.45 ✓	116.10 ✓	- 4.44 ✓
length of Ship	150.0 ✓	150.0	

corresponding percentage
(Para. 11, 12, 13, or 14) 66.2%

FREEBOARD recommended amidships from centre of Disc to top of Statutory Deck Line, Wood (Iron) Deck:

Fresh Water Line	above centre of Disc
Indian Summer Line	"	"	"
Winter Line	below	"	"
Winter North Atlantic Line	"	"	"

If the frames, skin planking, or ceiling are of unusual thickness the breadth of vessel to inside of ceiling should be reported if possible.
In vessels obtaining an allowance for deck erections under Para. 11 where the sheer drops abaft amidships the height of the R.Q.D. is to be taken from the level of the top of the amidships beam.
In flush-decked vessels the total standard mean sheer means the sheer measured at the stem and stern-post. In vessels having poops and forecastles, it means the sheer measured at points distant one eighth of the vessel's length from stem and stern-post.

State dimensions of freeing port area on back of this form.

The Surveyor should state whether the fall in sheer as reported is measured relatively to the straight line of keel or to the water line. If measured relatively to water line the vessel's draft at time of survey, and also the usual load draft forward and aft should be reported.

MARKING REPORT

RECEIVED 2 MAY 1927

MARKING REPORT

RECEIVED 3 JUN 1927

I.P.T.O.

JUN 1927

W1282-003

W1282-004

W1282-004

Do all the Frames extend to the top height in the Poop? ✓ Raised Quarter Deck? yes. Bridge House yes. Forecastle? yes.
 To what height do the Reverse Frames extend?
 Has the Poop or Raised Quarter Deck an efficient Iron Bulkhead at the fore end? yes.
 Give particulars of the means for closing the openings in Bulkhead no openings.
 Is the Poop or Raised Quarter Deck connected with the Bridge House? yes. Has the Bridge House an efficient Bulkhead at the fore end? yes.
 Give particulars of the means for closing the openings in Bulkhead no openings.
 What is the thickness of the Bridge Front plating? .28 and Coaming plate? .28
 Give scantlings and spacing of the Stiffeners angles. 5" x 3" x .40 spaced 24"
 Are bracket plates fitted at each end of the Stiffeners? yes. Are hor'l. brackets fitted connecting Bridge Bulk'd. with Bulwarks? yes.
 Has the Bridge House an efficient Iron Bulkhead at the after end? yes.
 How are the openings closed? no openings.
 Is the Forecastle at least as high as the main or top-gallant rail? yes. Has the Forecastle an efficient Iron or Wood Bulk'd. at after end? yes.
 Are the Engine and Boiler openings covered by a Bridge, Poop, Raised Quarter Deck, & enclosed by a Strong Iron or Steel Deckhouse? yes.
 If the openings are not so protected are the exposed parts of the Casings efficiently constructed? yes.
 Give thickness of plating; scantlings and spacing of Stiffeners .30 + .28
 What is the height of the exposed Casings? 6' 6". Are suitable means provided for closing all openings in them in bad weather? strong st.

Position and Size.	No. IN WELL 24'-0" x 13'-6"		No. QUARTER DECK, 22'-9" x 13'-6"							
Item.	Ship.	Rule.	Ship.	Rule.	Ship.	Rule.	Ship.	Rule.	Ship.	Rule.
COAMING. Thickness { Sides.....	42"	42"	33"	33"						
Thickness { Ends.....	.50	.50	.44	.44						
SHIFTING BEAMS OR WEB PLATES. { Number	FIVE.	FIVE	FIVE.	FIVE						
SHIFTING BEAMS OR WEB PLATES. { Section and Scantlings	11" deck 3x3x40	3x3x40	3x3x40	3x3x40						
SHIFTING BEAMS OR WEB PLATES. { Material										
* FORE AND AFTERS. { Number										
* FORE AND AFTERS. { Section and Scantlings										
* FORE AND AFTERS. { Material										
HATCHES Thickness	3"	3"	3"	3"						
Remarks.....	WW. SOLID	WW. SOLID	WW. SOLID	WW. SOLID						

* When the Fore and Afters are of wood the depth should be stated from the underside of the hatches.

(If the sill of the lowest side scuttle will be less than 6 inches above the Indian Summer Load Line if assigned under the tables, state vertical distance from top of deck at side amidships to lower edge of lowest side scuttle.)

The following information is to be given in all Cases of vessels dealt with under Paras. 11, 12 (under 15 feet Moulded depth) and under Shelter Deck Rule
What is the thickness of the Bridge Sheerstrake? .28 Strake between Main and Bridge Sheerstrakes? .38

Delete the words { The Crew are not, berthed in the bridge house.
that do not apply { The arrangements to enable them to get backwards and forwards from their quarters are, are not satisfactory.


Length of Bulwarks in well 33 ft 3 ins. = 9.82 Sq. ft.

Area of Freeing Ports required by Para. 11 (e) each side of vessel = 10.013 Sq. ft.

Ft. Tenth. Ft. Tenth. No. 10.013 = 10.01 Sq. ft.

2.166 x 1.541 x 3 ✓ x ✓ x ✓ Freeing Ports (each side of vessel) = 9.842 Sq. ft.

Total deficiency or excess = .19 .022 - .171 Sq. ft.

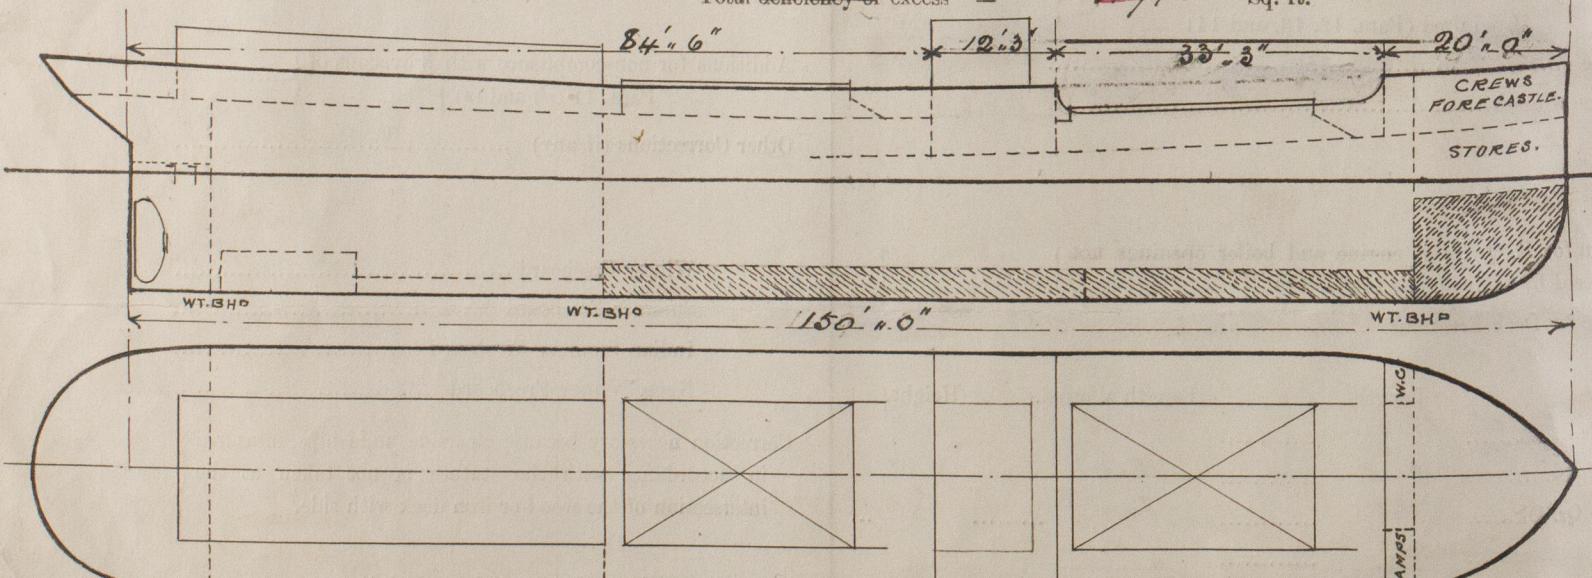

Show hereon line of Floors or Tank Top with position of any Breaks in same; also height of Peak Tank tops, &c., &c.

State any special features in the construction of the Vessel. This vessel has no wood upper deck laid.

Midship section and Profile plans forwarded herewith for reference.

Owners Messrs A. Y. Henry & MacGregor Ltd.

, Address 11 Dock Place - Leith.

Fee £ 3 : ✓ : ✓ Received by me



© 2020

Lloyd's Register
Foundation