

- MIDSHIP SECTION - - STEEL SCREW CARGO STEAMER -

- LLOYDS NUMERALS -

BREADTH MLD - 24.00
DEPTH MLD - 11.33
TRANSVERSE NO - 35.33
LENGTH B.P. - 150.00
LONGITUDINAL NO - 5299.50
DEPTHS TO LENGTH - 13.24 TO MAIN DK.
DEPTHS TO LENGTH - 0.75 TO QR. DECK
d = 8.85 TO MAIN DECK IN WAY OF DOUBLE BOTTOM
d = 12.85 TO QR. DECK IN WAY OF DOUBLE BOTTOM
d = 14.00 TO QR. DECK IN WAY OF ORDINARY FLOORS

- CLASS 100 A.I. LLOYDS -

- DIMS:- 150'-0" B.P. x 24'-0" MLD x 11'-4" MLD -

- SHIP NOS. 583 + 585 -


- EQUIPMENT NUMERAL -

LONGITUDINAL NO = 5299.50
RAISED Q8 DECK 84.5x4.0 = 338.00
BRIDGE DECK 12.25 x 7.0x3/4 = 64.31
FORECASTLE DECK 20.5 x 6.5x3/4 = 99.94
CASING 47.0 x 6.5 x 1/2 = 152.75
EQUIPMENT NO = 5954.50

EQUIPMENT

2 BOWER ANCHORS 9 CWTs STOCKLESS
1 STREAM ANCHOR 3 CWTs EX STOCK
1 KEDGE ANCHOR 1/4 CWTs EX STOCK
165 FATHOMS 1" STUD LINK CABLE
45 " 2 1/4" STEEL WIRE IN LIEU OF STREAM CHAIN
75 " 2 1/2 " " TOWLINE
90 " 5 1/2" HAWSER

ALEX HALL & CO. LTD.
SHIPBUILDERS, ENGINEERS & BOILERMAKERS
ABERDEEN.

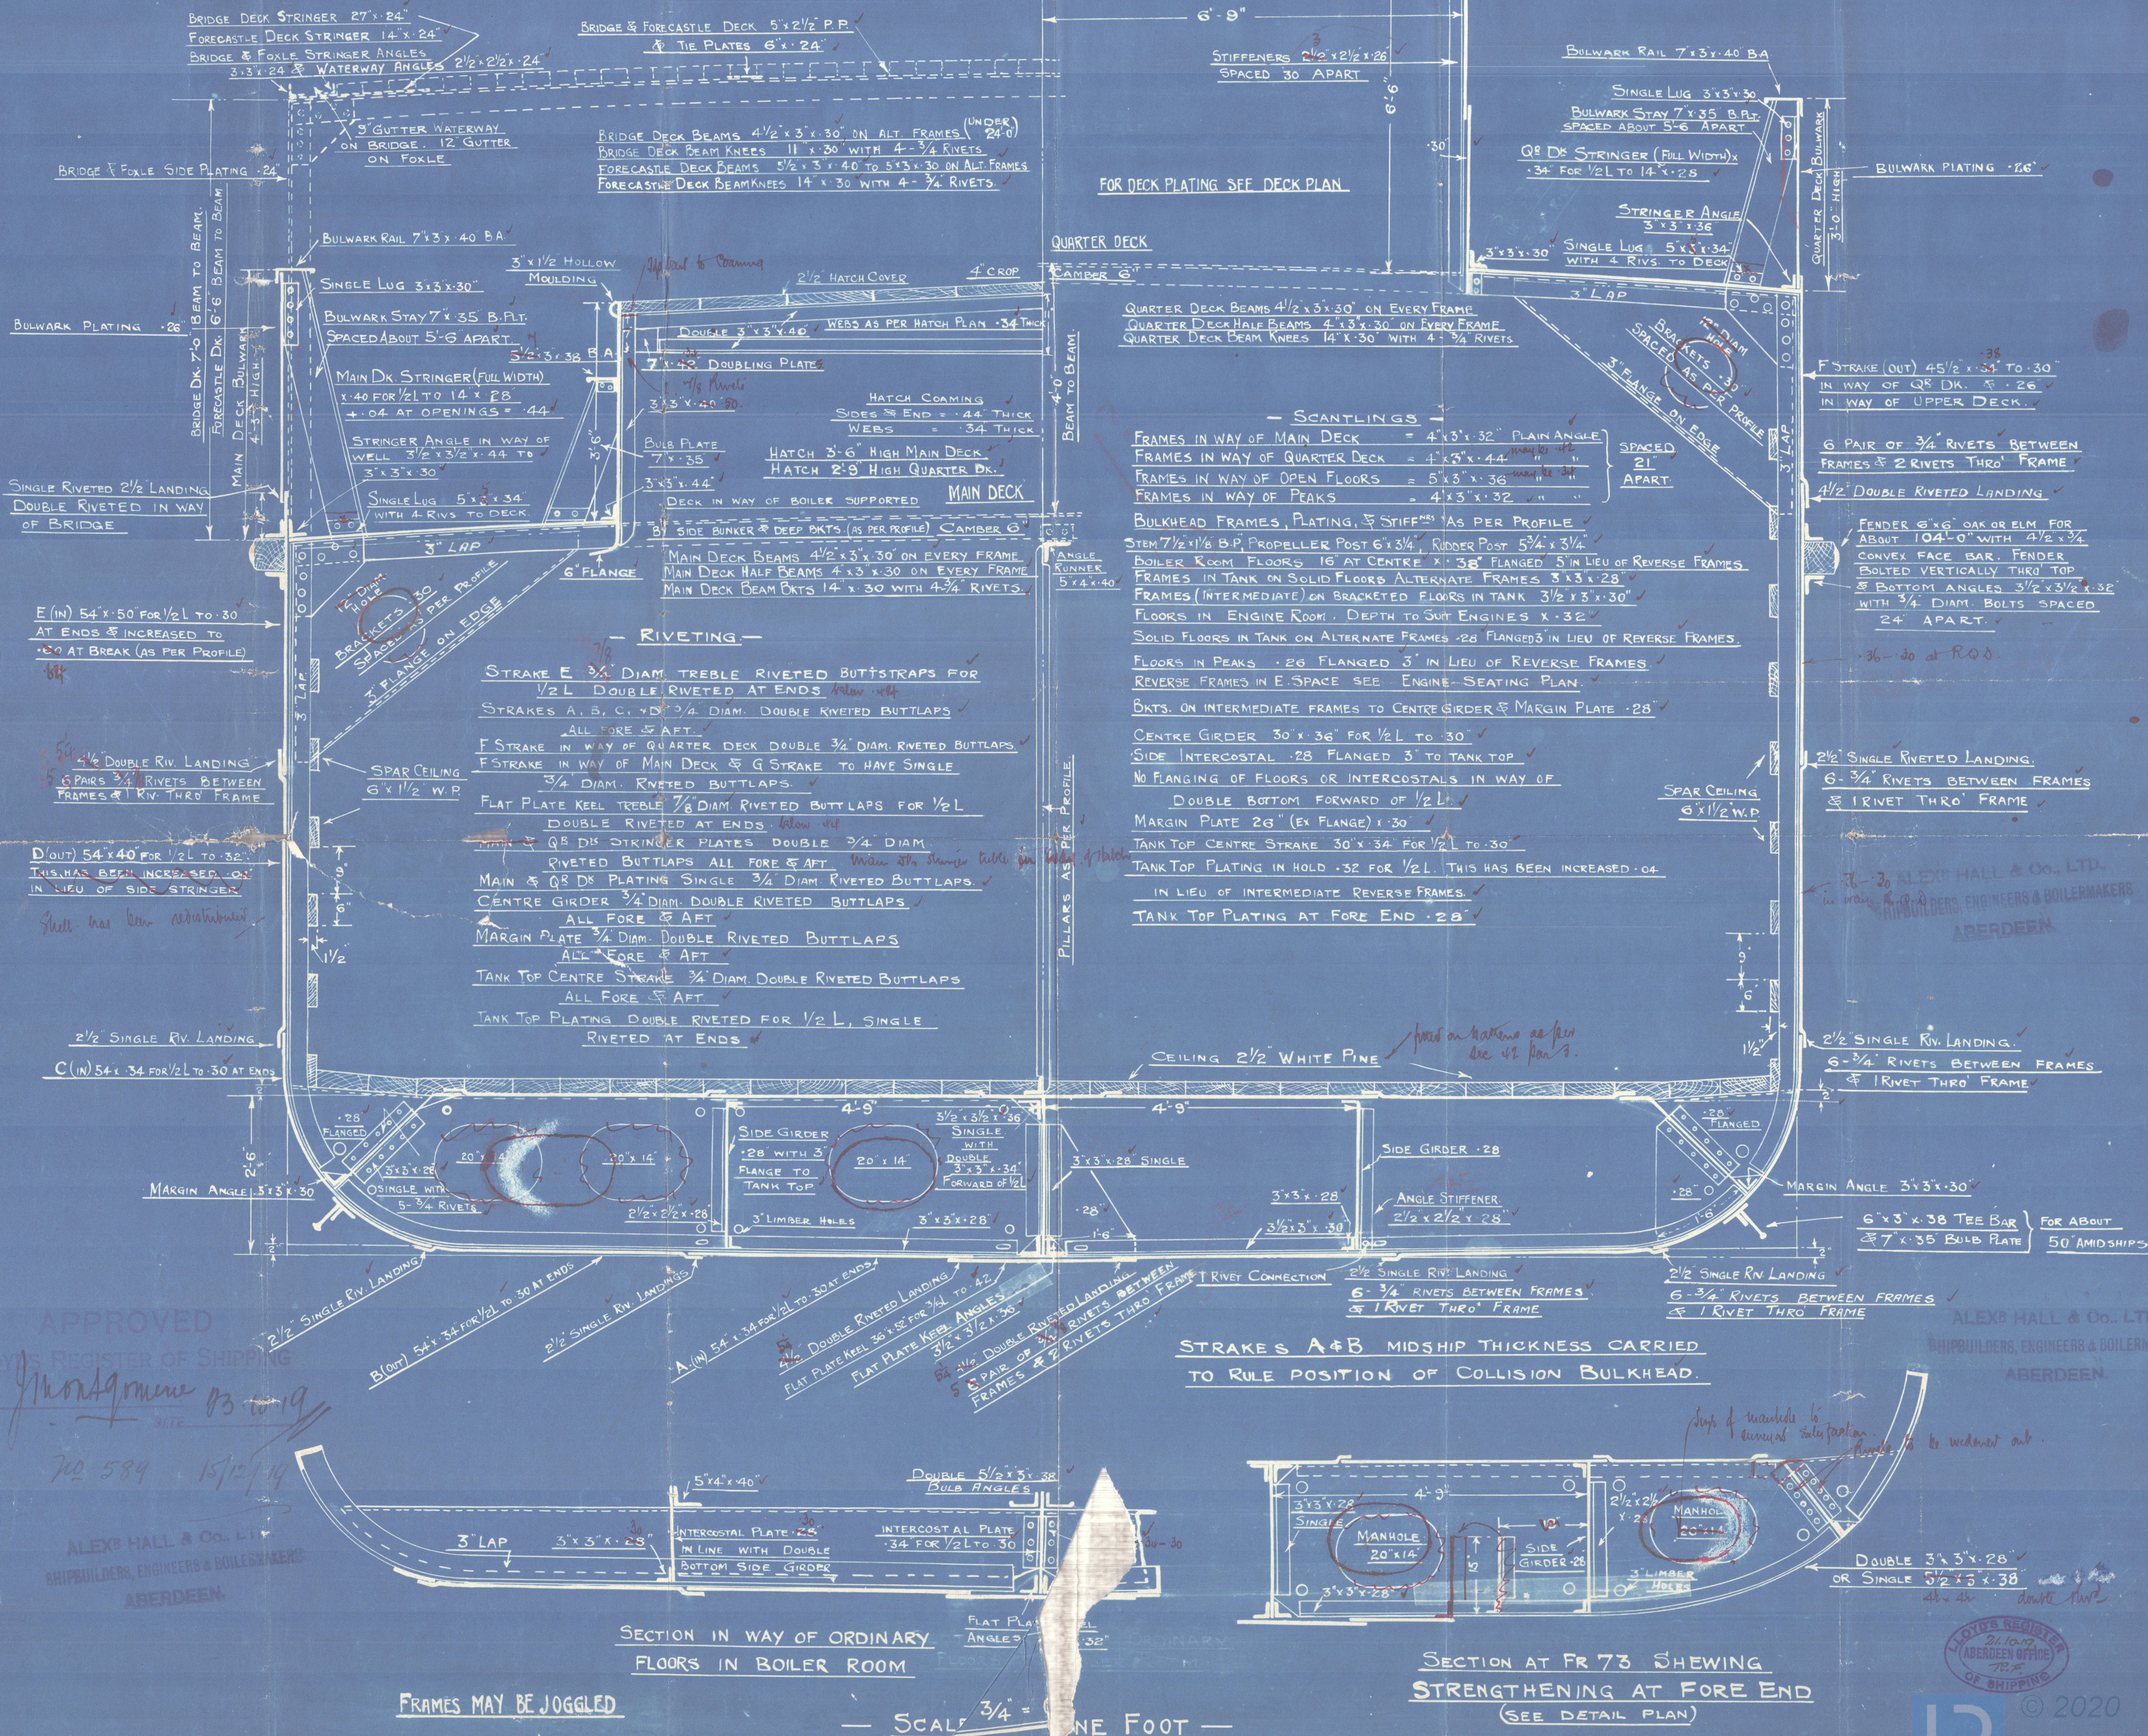

ALEX HALL & CO. LTD.
SHIPBUILDERS, ENGINEERS & BOILERMAKERS
ABERDEEN.

ALEX HALL & CO. LTD.
SHIPBUILDERS, ENGINEERS & BOILERMAKERS
ABERDEEN.

LLOYD'S REGISTER
21.10.19
ABERDEEN OFFICE
72.1
OF SHIPPING

A Hall & Co. Ltd.

No. 583 & 584

Midship Section.

583.

S. S. "Scotstoun Head".

Abn FE Rept. No. 12499.

585.

S. S. "Koss Head".

Abn FE Rept No. 12819.

589.

Cancelled.

Rio Quequen Grande

D. 147



Lloyd's Register
Foundation

W1282-0045