


ALEXS HALL & Co., LTD.  
SHIPBUILDERS, ENGINEERS & BOILERMAKERS  
ABERDEEN.

ALEXS HALL & Co., LTD.  
SHIPBUILDERS, ENGINEERS & BOILERMAKERS  
ABERDEEN.

-BRIDGE-  
STRINGER PLATES - 27"x24"  
TIE PLATES - 6"x24"  
STRINGER ANGLE - 3"x3"x24"  
GUTTER ANGLE - 22"x22"x24"  
BEAMS - 42"x3"x30"  
BRIDGE 7'-0" HIGH AT CENTRE.

*Subpoin under mark, & increases to  
to normal satisfaction.*

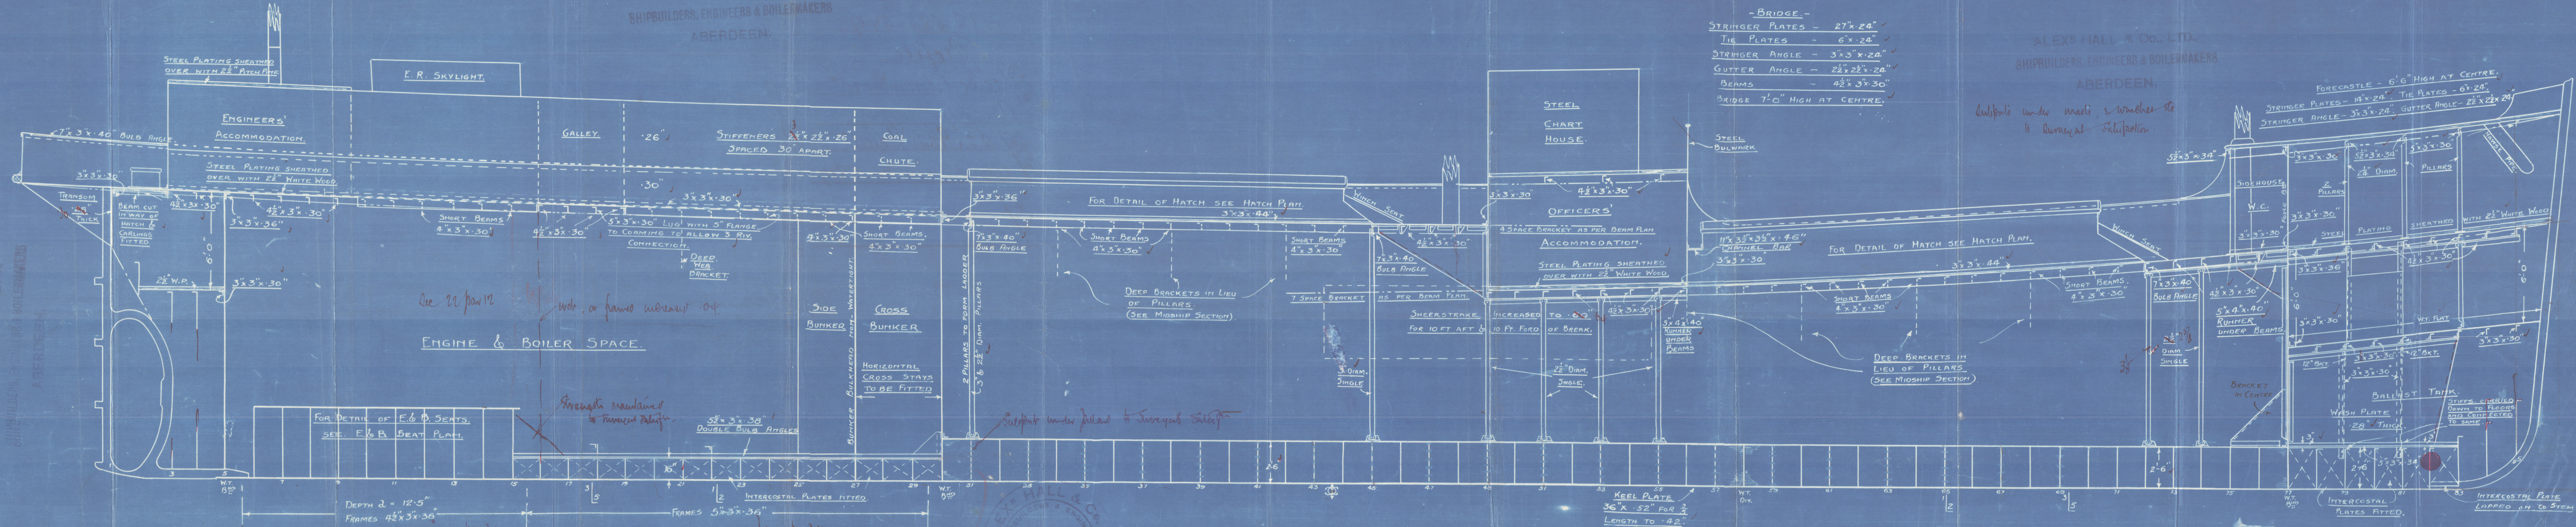

LONGITUDINAL SECTION  
YARD N<sup>o</sup> 583 & 585.  
SCALE 1/4" = ONE FOOT.

APPROVED  
LLOYD'S REGISTER OF SHIPPING  
*Montgomery*  
DATE 13.10.19  
No 589 13/12/19



ALEXS HALL & Co., LTD.  
SHIPBUILDERS, ENGINEERS & BOILERMAKERS  
ABERDEEN.



YARD N<sup>o</sup> 583 & 585.



A Wall & Cy Id.

N<sup>o</sup> 583 + 548.

Profile.

583/ S.S. "Scotstoun Head".

Abn. F.E. Rept. No. 12499.

585/ S.S. "Noss Head"

Abn. F.E. Rept. No. 12819

589/ Cancelled.



© 2019

Lloyd's Register  
Foundation

W1282-0046