

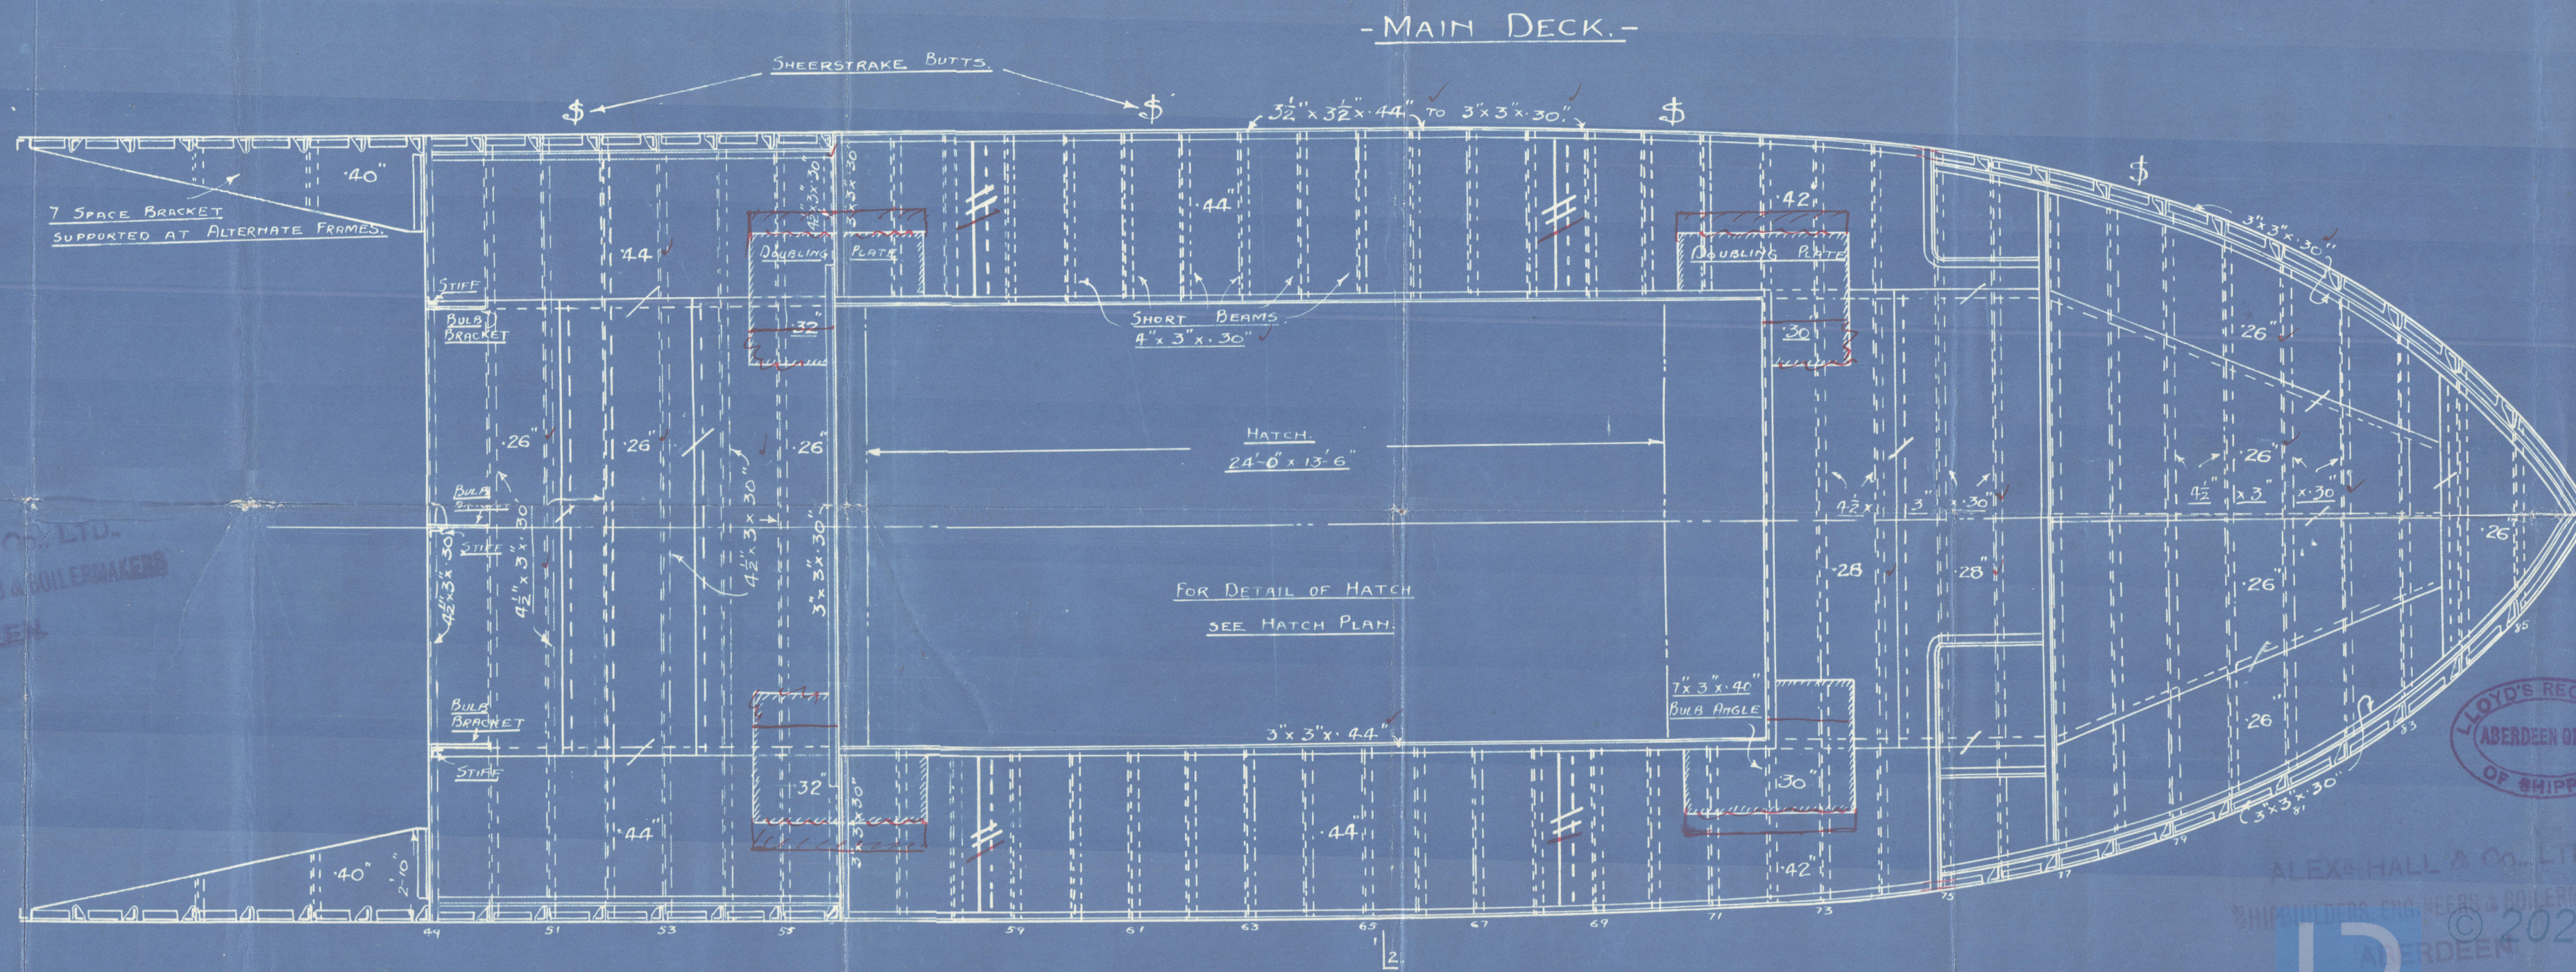
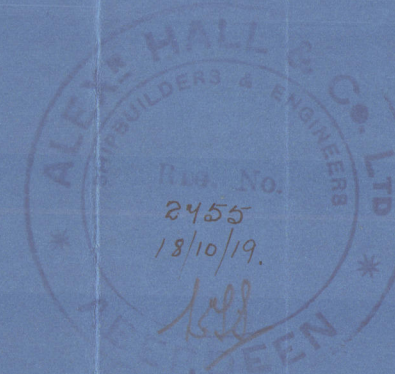



-BEAM PLAN.-
YARD Nos 583 & 585.
SCALE 1/4" = ONE FOOT.

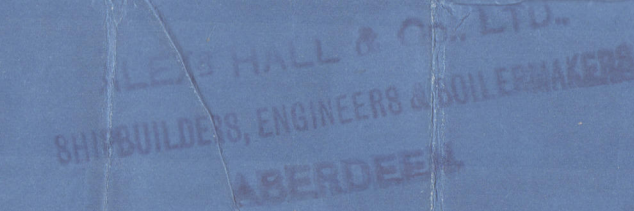

-MAIN DECK.-

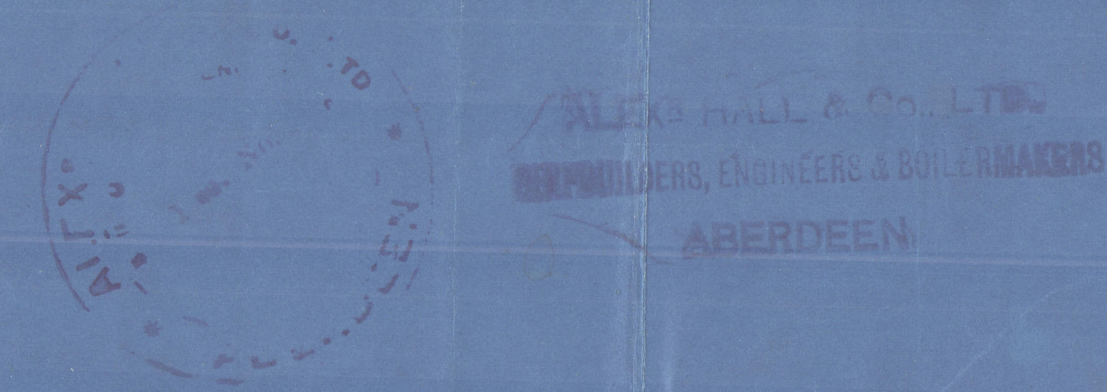

APPROVED
LLOYD'S REGISTER OF SHIPPING
Montgomerie
DATE 23.10.19
No. 589 15/10/19

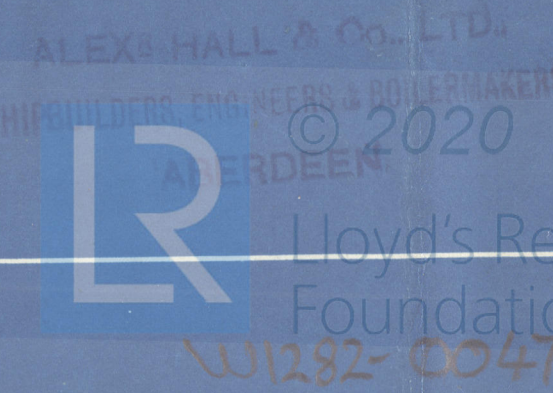

A Hall & Co. Ltd.

No. 583 & 5. & 4.

Deck plan.

583.


S.S. "Scotstoun Head"

U.K. Rep. No. 12499.

585.

S.S. "Noss Head".

U.K. Rep. No. 12819.

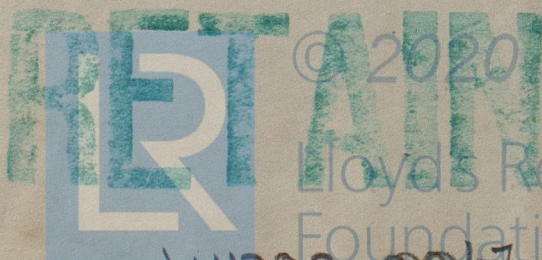

© 2020

Lloyds Register
Foundation

W1282-0047