


Attachments at heads and heels of fillers to be reinforced to surveyors satisfaction.
Tanks to be either full or empty.
Requirements of Section 20 & 20A. to be complied with.
See letter re loading of Oil fuel in double bottom.

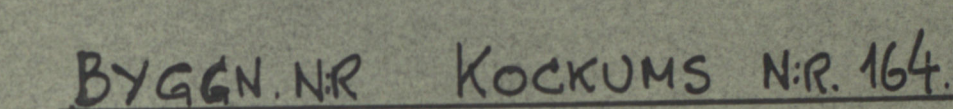

F 163 / 8