

REEL 47" x 100' 00" / 16
TO 70 ATENDS
BUTTS QUADRUPLE RIVETED
4 THREE OVER 76. REMAINDER THREE
RIVETS 18 THREE OVER 98
REMAINDER 1"

29.7.18

Most Craig Day for Clark


Nº 199.

Mid: Dec:

as built.

Sp Wan Kistrel.

Mid report Nº 10173

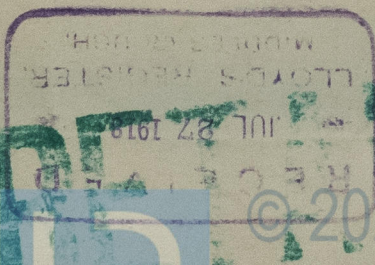

© 2021

Lloyd's Register
Foundation

W1293-0221