
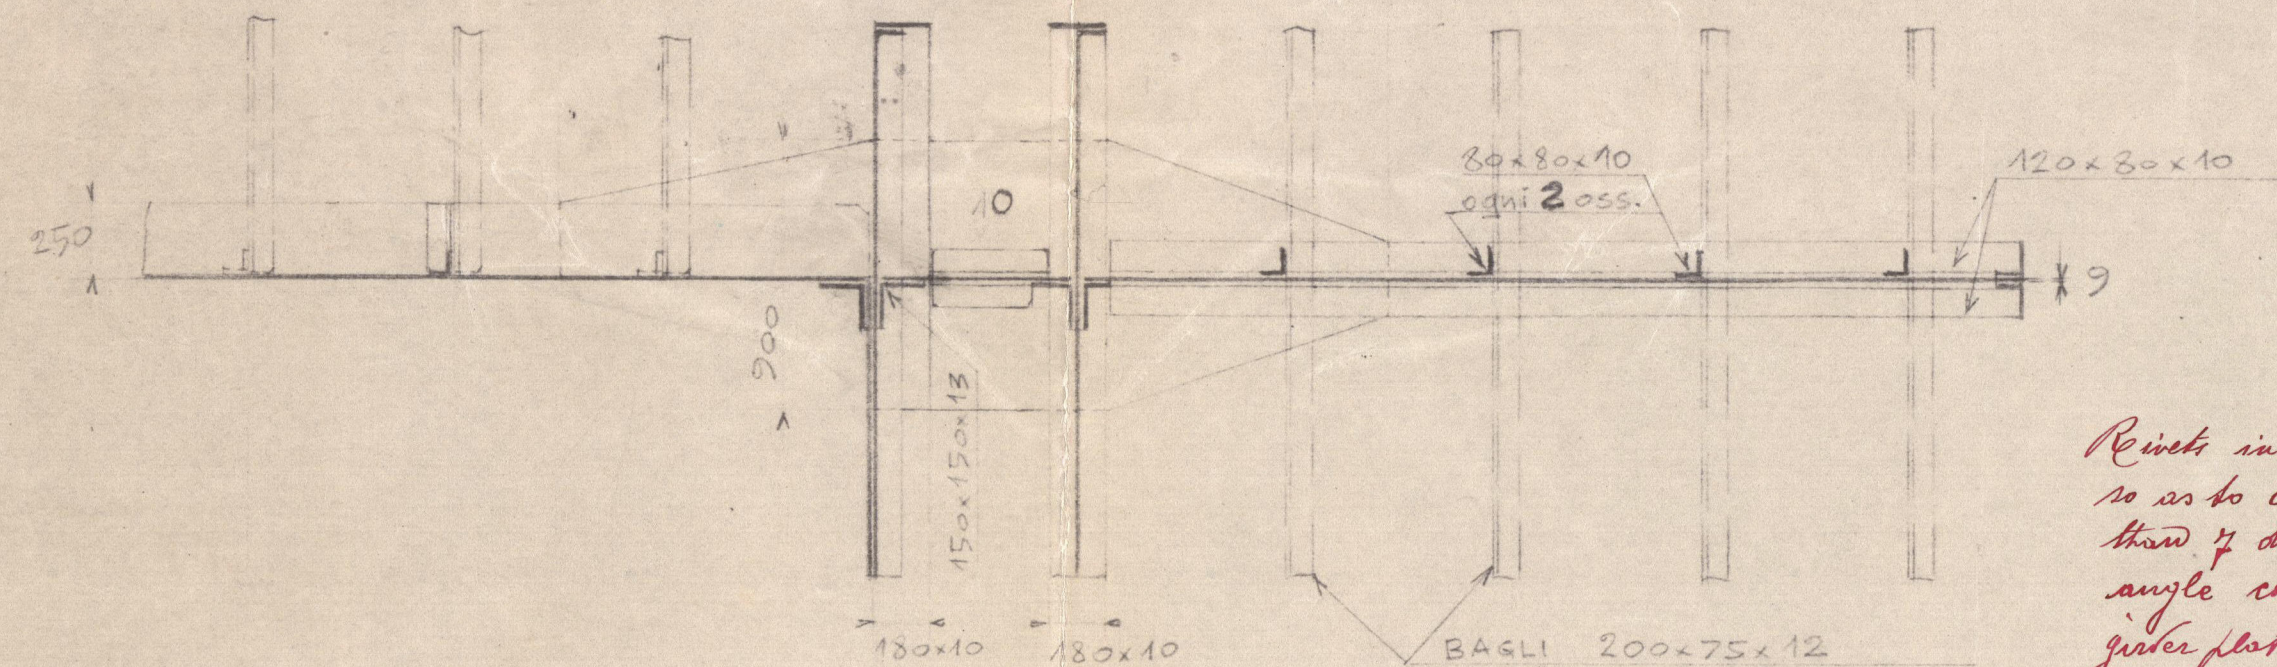




PIROSCAFO "VEJO"

PARTICOLARI DELLE ANGUILLE IN CORRISPONDENZA DELLE BOCCAPORTE

SCALA 1:25

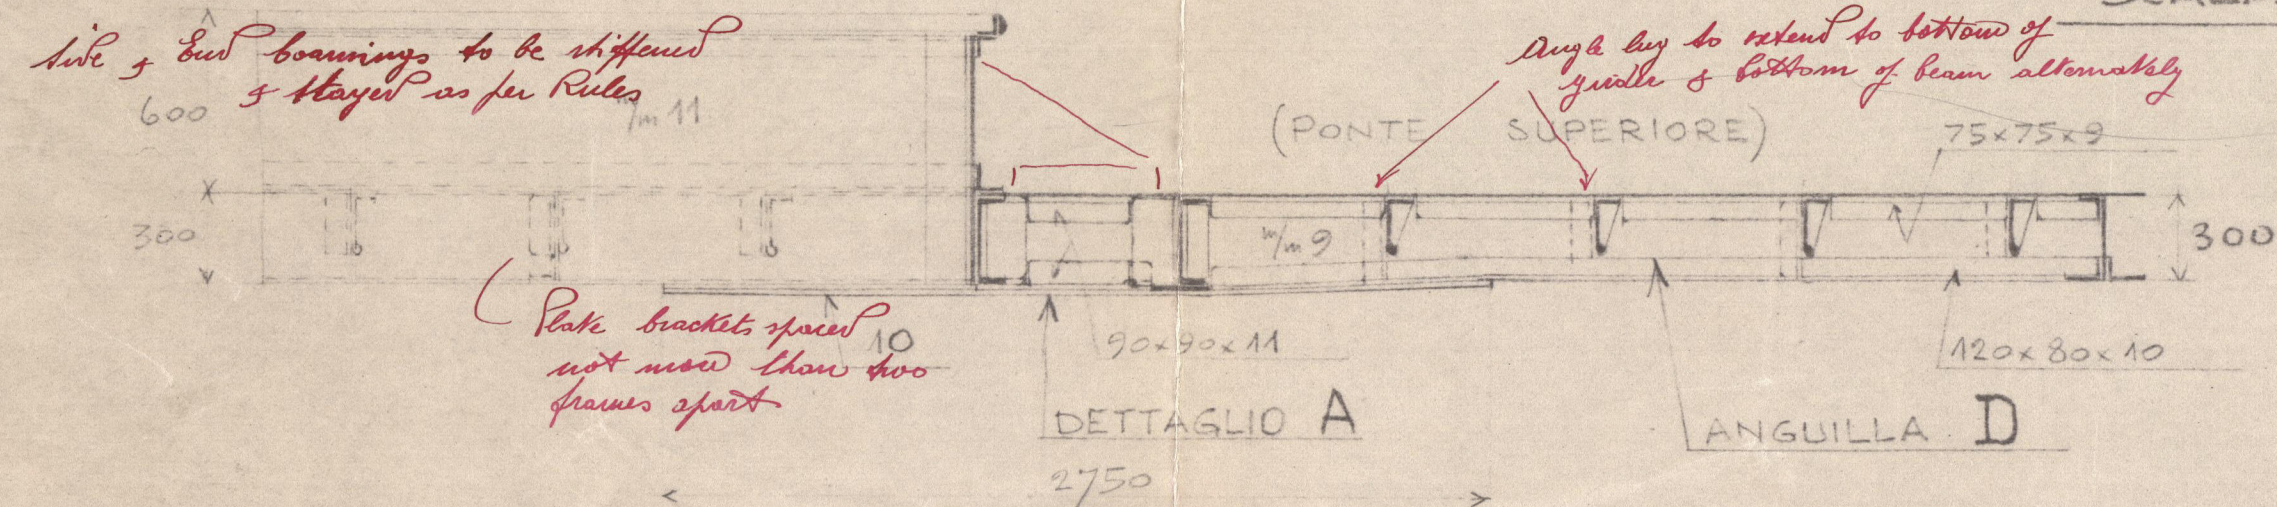


Rivets in back girders to be spaced so as to close work efficiently & not more than 7 diameters - rivets in intermediate angle connecting back girder to deck and to girder plate spaced not more than 5 diameters.

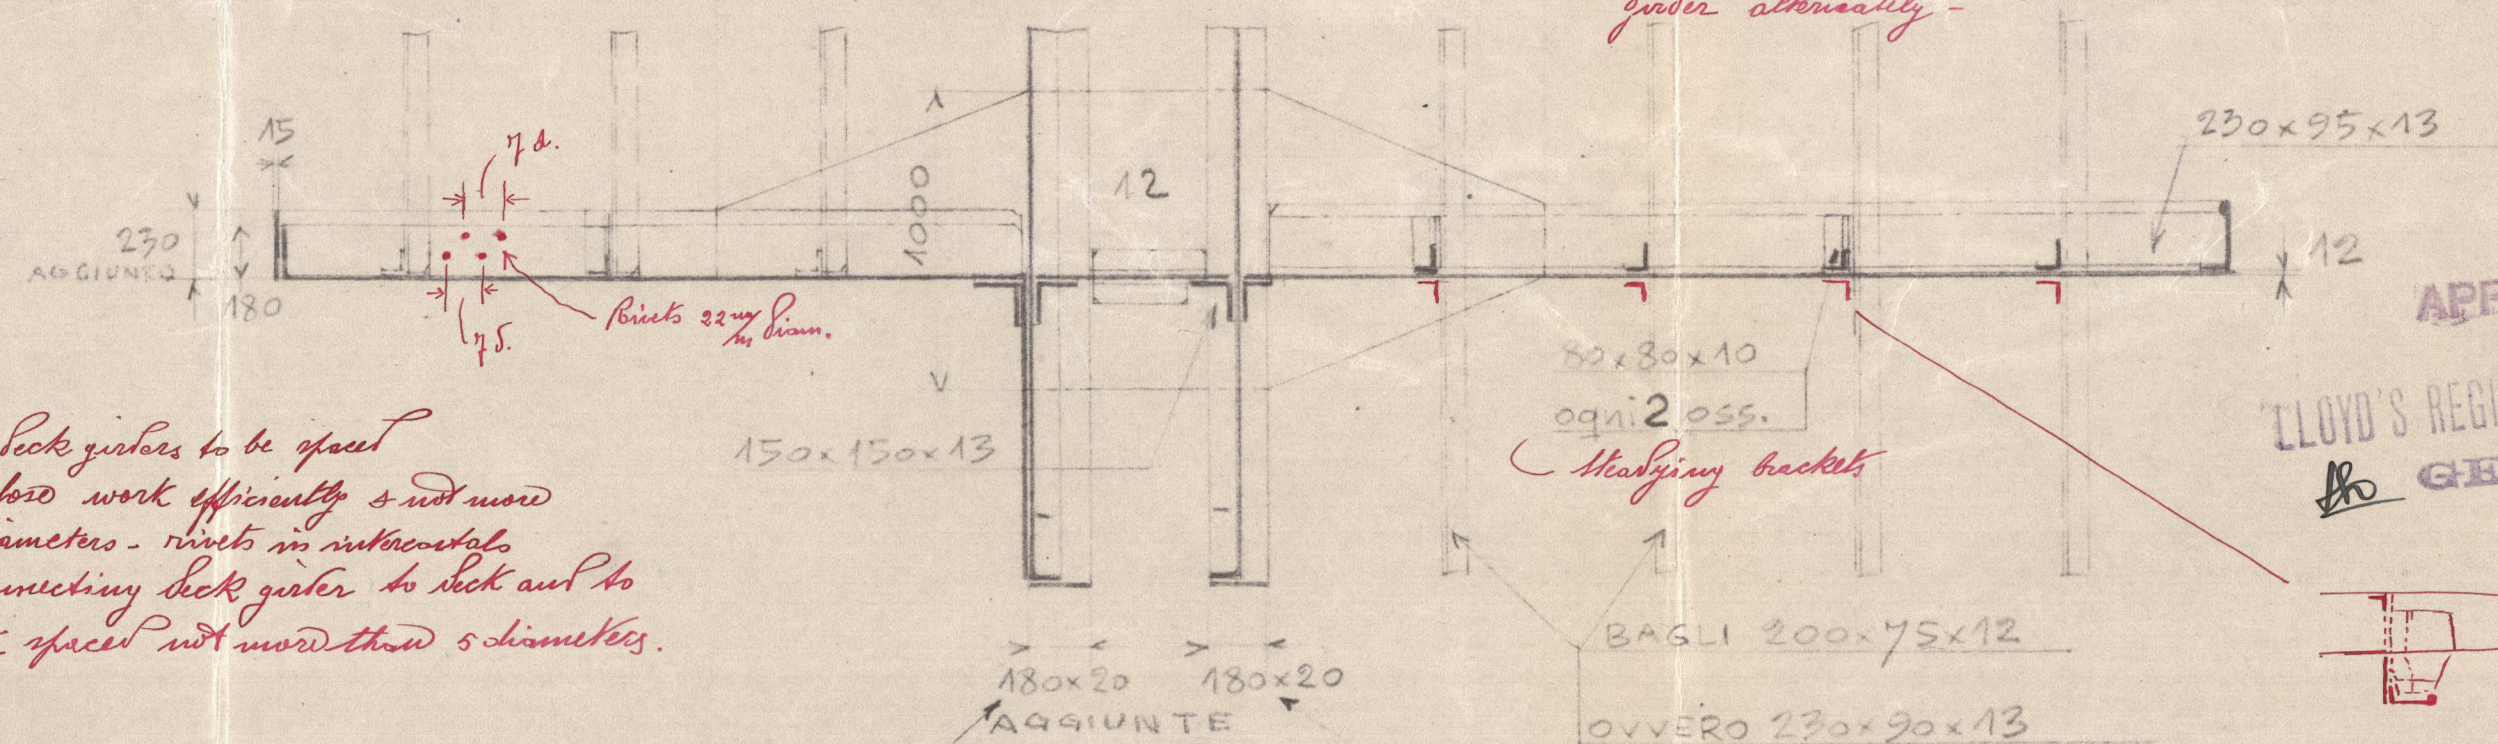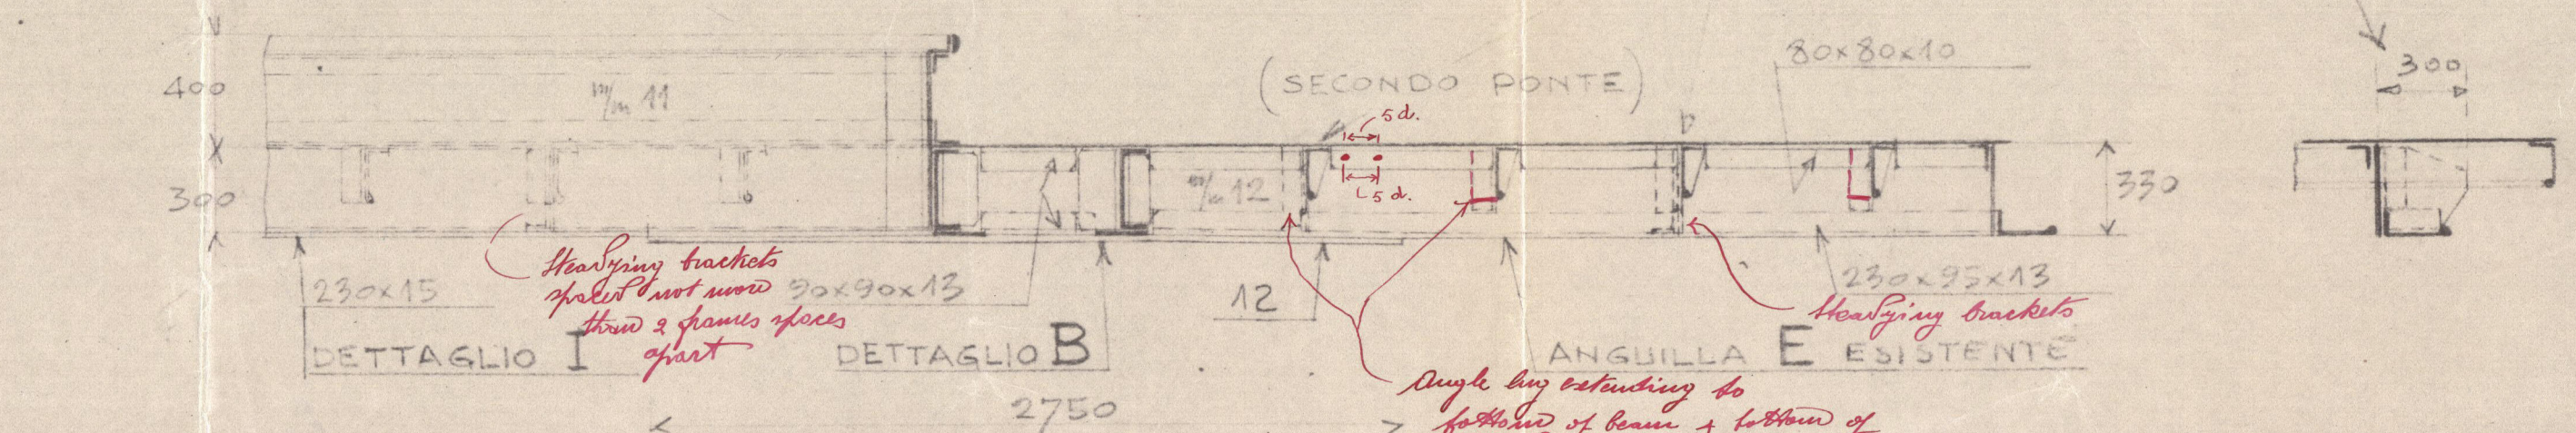

Diaphragm plates to be fitted between beam hatch and deep channel beams at suitable intervals to surveyors satisfaction.

APPROVATO
12/3/29
LLOYD'S REGISTER OF SHIPPING
GENOVA

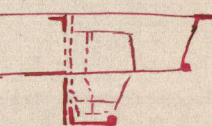

© 2020
Lloyd's Register
Foundation

V11302-0243

Graden d. Helden name

Hatcl and Bean

W1302-0243



© 2020

Lloyd's Register
Foundation