

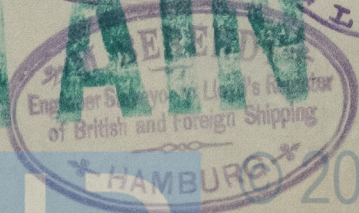


S. S. "Melbourne"
Ham. Regt. No 12476.

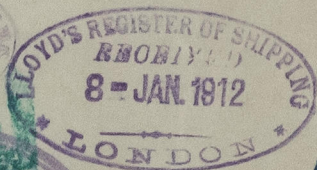

Plan
of Main Boilers
for
S. S. No 315
to be built and engineered
by
Henschel & Schiffbau-
Gesellschaft
of
Hamburg.

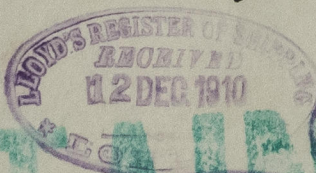

RETAINED
2021

W1307-0257

Lloyd's Register
Foundation