


—PROFILE & DECK PLAN. N° 271.—

—400.0 B.P. x 92.0. BR. MLD. 26.11. DEPTH MLD.—

SCALE 3" = 1 FOOT.

*Note: Windows & Windows to be submitted to surveyors satisfaction
Second plan of Hatch & Bulkheads to be submitted.*

Tween Decks 8' 6".

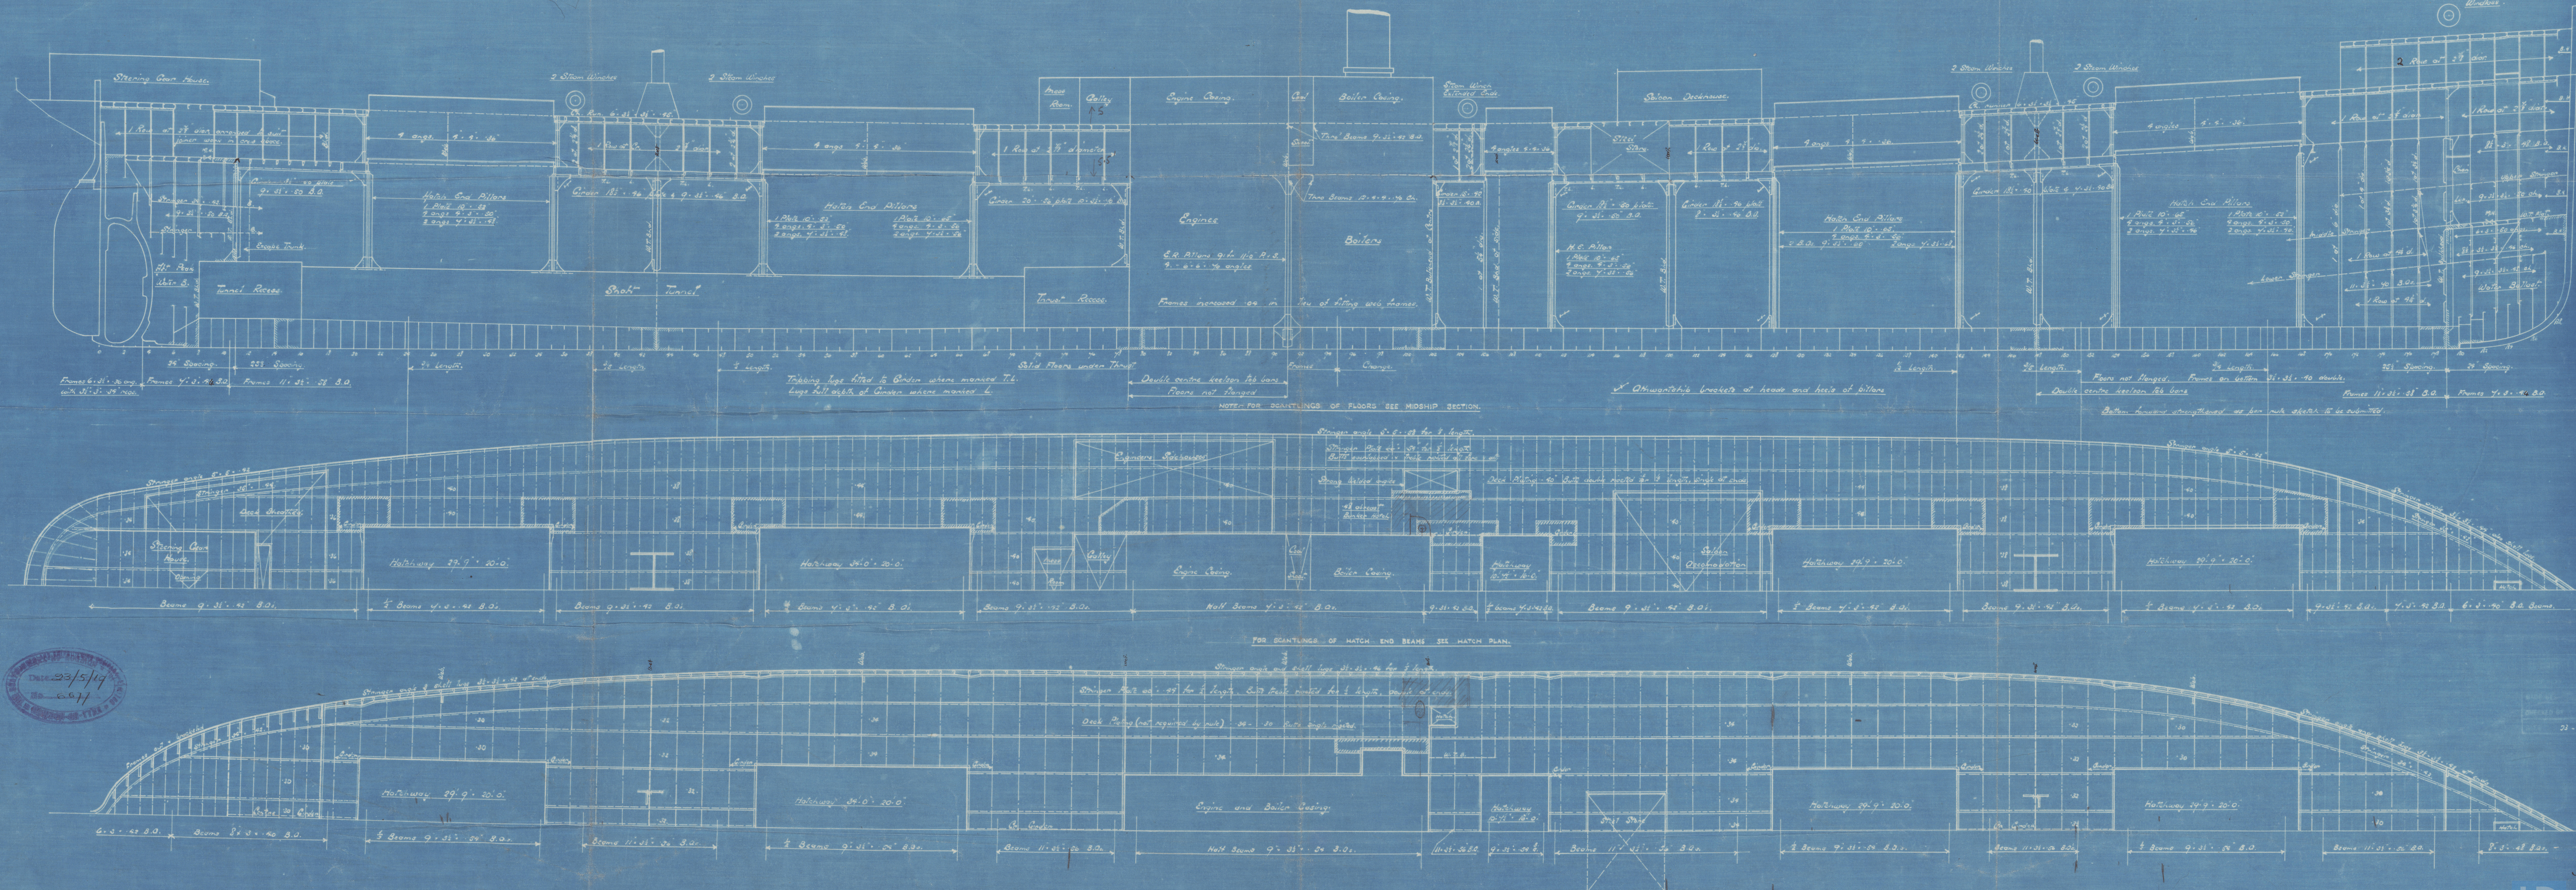

March 27

Northumberland S Co Ltd

SS 271

W1318-0295

Profile and Deck

S.S. "WAITEMATA"
NEWCASTLE ON TYNE.

Report No. 71907



Now.

YUKI. MARU -

D. 171.

RETAIN



© 2021

Lloyd's Register
W1318-0295
Foundation