

Rpt. 6.

For the information of Surveyors and the Committee only.

Received at

Office,

1912

Lloyd's Register of British and Foreign Shipping.

(Report on Vessel No. 208 Port Boston Mass.)

No. 99.

SHIP FORGINGS OR CASTINGS.

I have to report that the undermentioned Iron or Steel Forgings or Castings, manufactured by *Jore River Shipbuilding Company* of *Quincy* for the Vessel No. 208, being built by *Jore River Shipbuilding Co. of Quincy* have been inspected by me as set forth below, and found to be, so far as can be seen, after having been subjected to tensile and bend tests as set forth in the Rules to be sound and free from defects.

Forgings.

Lloyd's

99.

12.12.

75%.

Blissworth Thompson
December 12. 1912

STERN FRAME.


RUDDER FRAME.

Rudder Stem

	STERN FRAME.	RUDDER FRAME.	Rudder Stem
al*	Open heart	Open heart.	Open heart.
ade	Forged	Forged	Forged.
sions	To approved drawing	To approved drawing	10" dia
ss on Inspection	Forged, forged & finished	Forged & finished	Forged & finished
hen Inspected	June 18. July 8. July 23 rd	Aug. 13. 29. June 6.	Aug. 13. 29.

ETCHES OF FRAMES SHOWING POSITION AND DESCRIPTION OF WELDS OF FORGINGS, OR PARTICULARS OF TESTS APPLIED TO CASTINGS.

satisfactory tensile and
bend tests were taken from
the forgings.

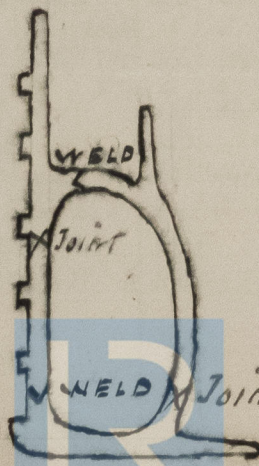

e (if any chargeable) £

To be paid at

* If of Iron, state whether scrap or puddled Iron.

W1334-0046