


15-12-26

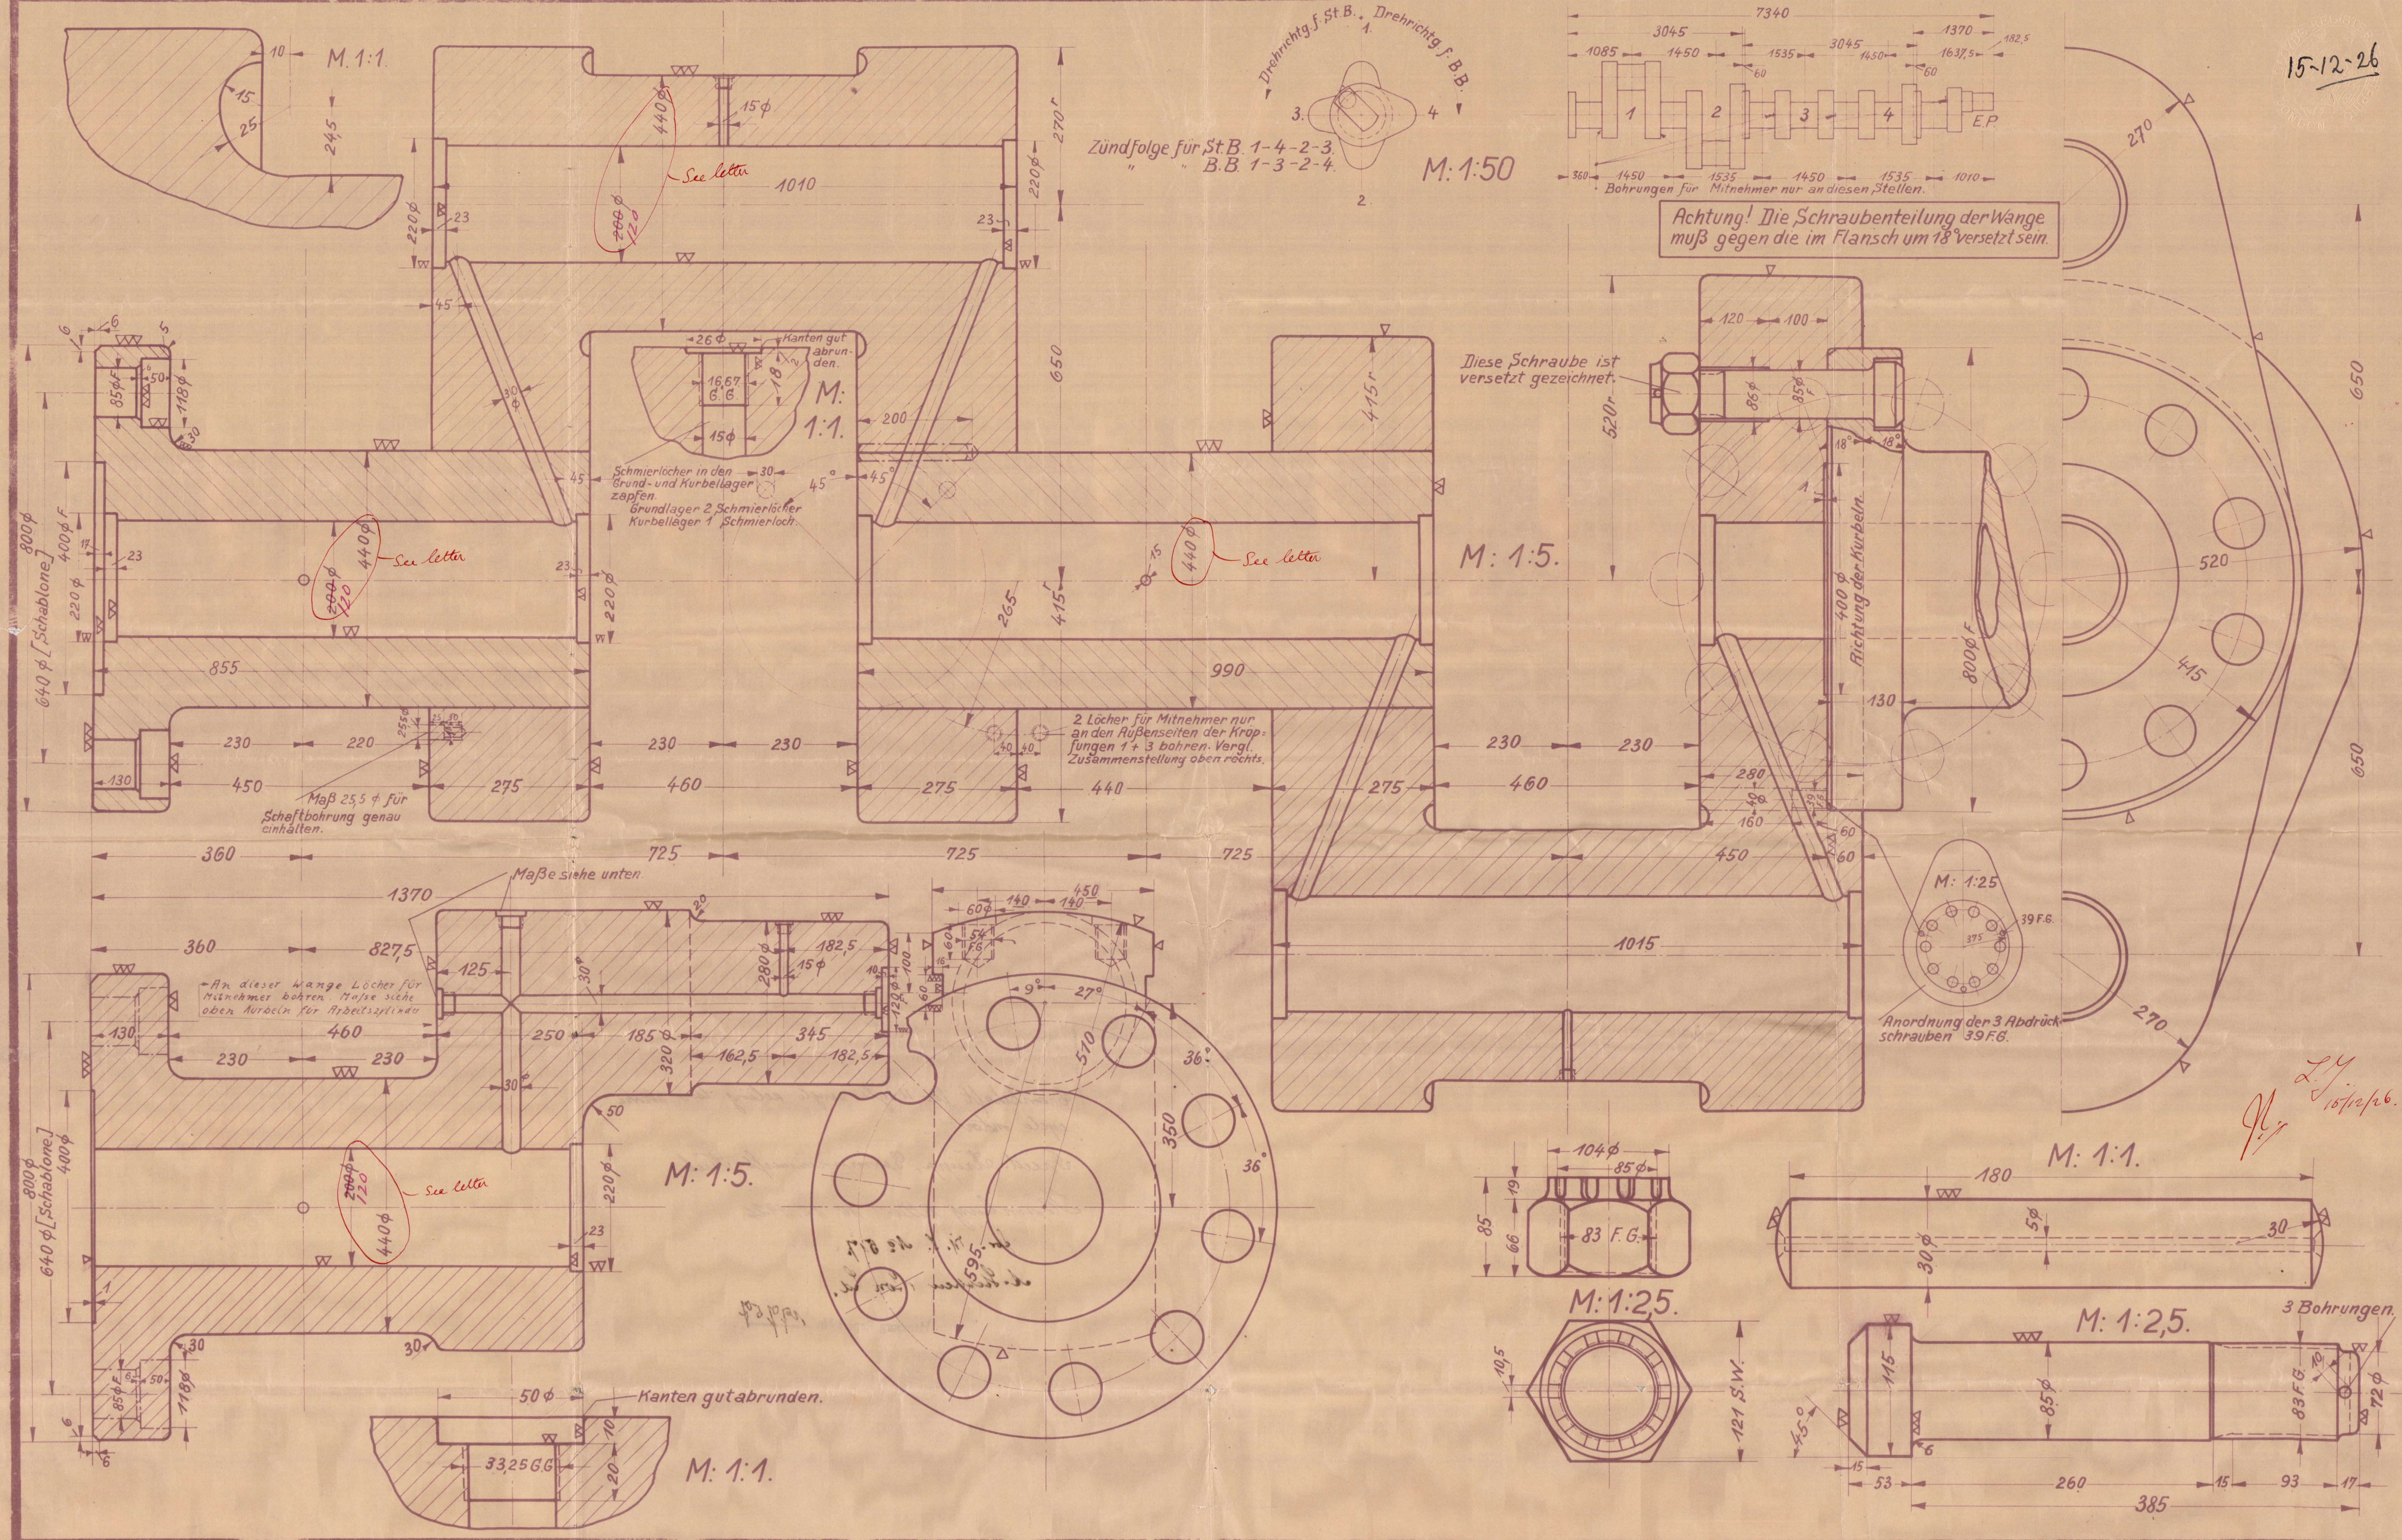

Kurbelwelle für 4 Zyl. Motor.

Crankschaft for 4 cyl. single acting two stroke
cycle motor

Fried. Krupp, Germaniaerft, Kiel

Hamburg letter 10. 12. 1926

for N. S. No 517.

A. Stephen & Son Ltd.

Hamburg Report Nr. 19759.

"Violante"

Des 47740

W134-0026 © 2019



Lloyd's Register
Foundation