


15-1-17
27-1-17

SS No 328
PROFILE & DECK PLANS.

SCALE 1/8" = 1 FT





LENGTH 290' 0" BREADTH 42' 4" DEPTH 21' 2"
TO CLASS 100 A.I. AT LLOYD'S.

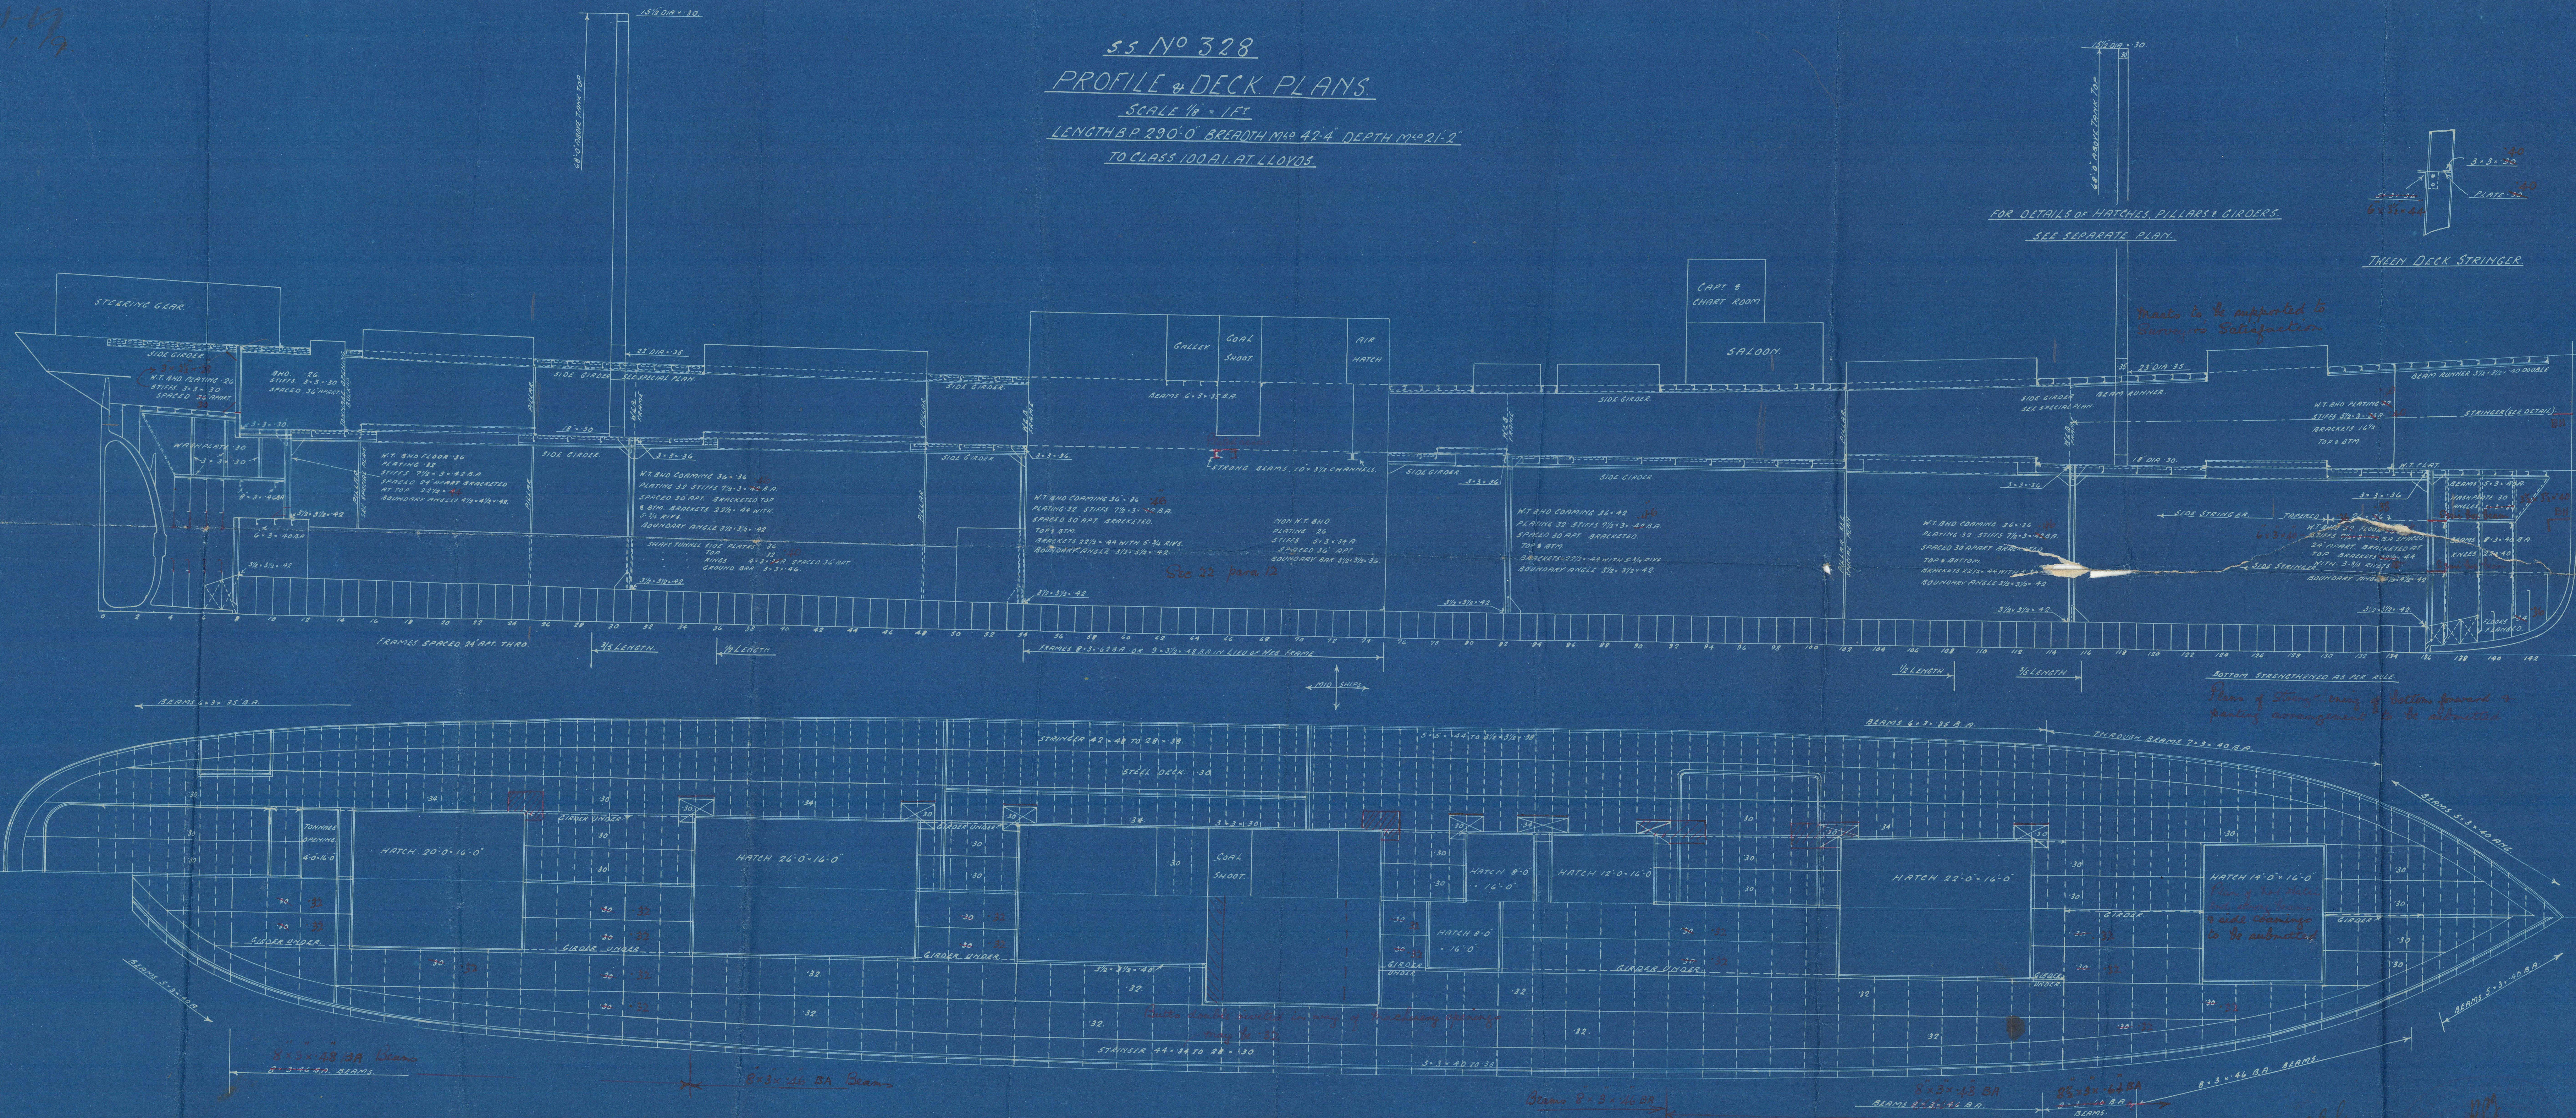

Profile and Deck Plans
Messrs The Clyde S.S. & Eng Co^{ltd}
No 328

S.S. "Sea Victory"

Greenock Rpt. No 17680

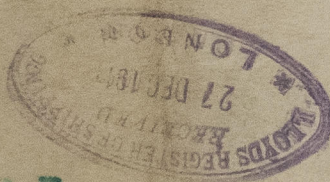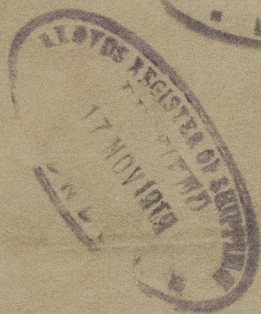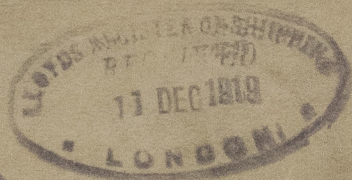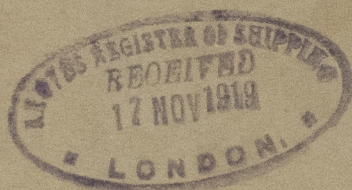

RETAIN

WB46-0150



© 2021

Lloyd's Register
Foundation