

28 - RIVETS

MANHOLE COMPENSATING RING

5/16" THICK


1 3/8" RIVET HOLES

BOILER NO 418

" " 419

LR

*UNION 1/4/26
all work*

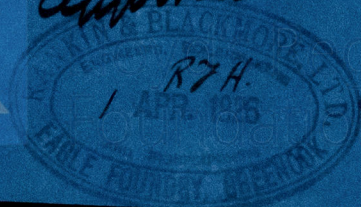

W1359-0055