

17.5.15
9.6.15
30.6.15
1.7.16
18.9.16

PROFILE & DECK PLANS

No 558

LENGTH 87' 0" BREADTH 21' 5" 6" DEPTH 30' 6" (UPPER 0')

Scale 1/4" = 1' 0"



Class 100 A 1 Lloyd

Plan of hatchways to be submitted
Details of pillars & girders to be submitted

All hatchway end pillars on Shelter Deck
to have flat heads & heels

Detailed sketch of
fastening arrangements
to be submitted

Bottom strengthened forward as per Rule
Detailed sketch to be submitted

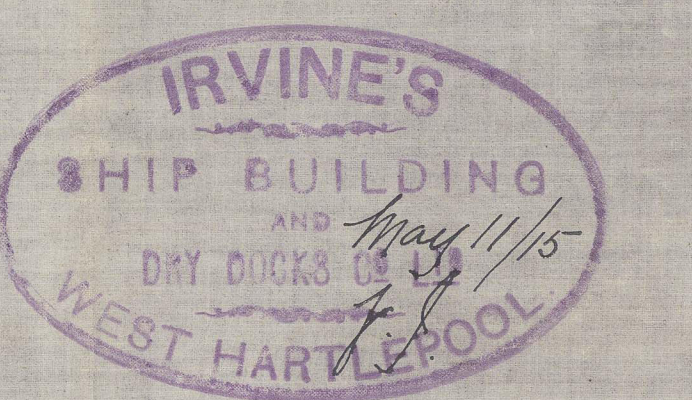 


No 558


Irving S. B. & D. D. C. Ltd.
S.S. No 558

PROFILE & DECK PLANS.

s/s. "Thistlemore"
West Hartlepool Report
No 15417

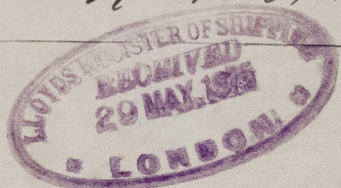


D. 218. Sec 3

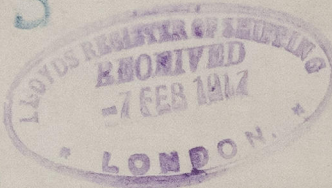

Now
URSULA RICKMERS-

D. 218. Sec. 3

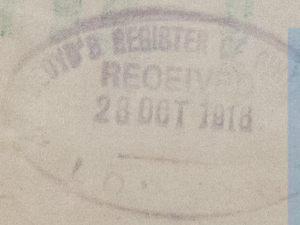

2020
Lloyd's Register
Foundation

W1359-0157