



Length B.P. 285'0 Breadth Mld. 41'9 Depth Mld. 21'2½

Lloyds Classification

Scale 1/8" = 1 Foot

237-8

Loan Battery No. 238

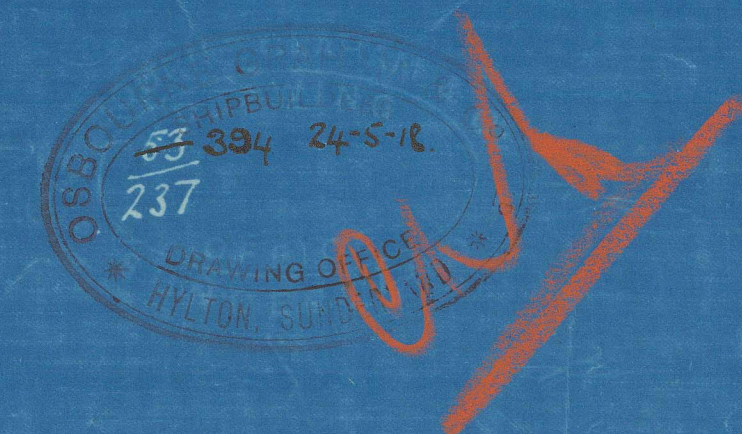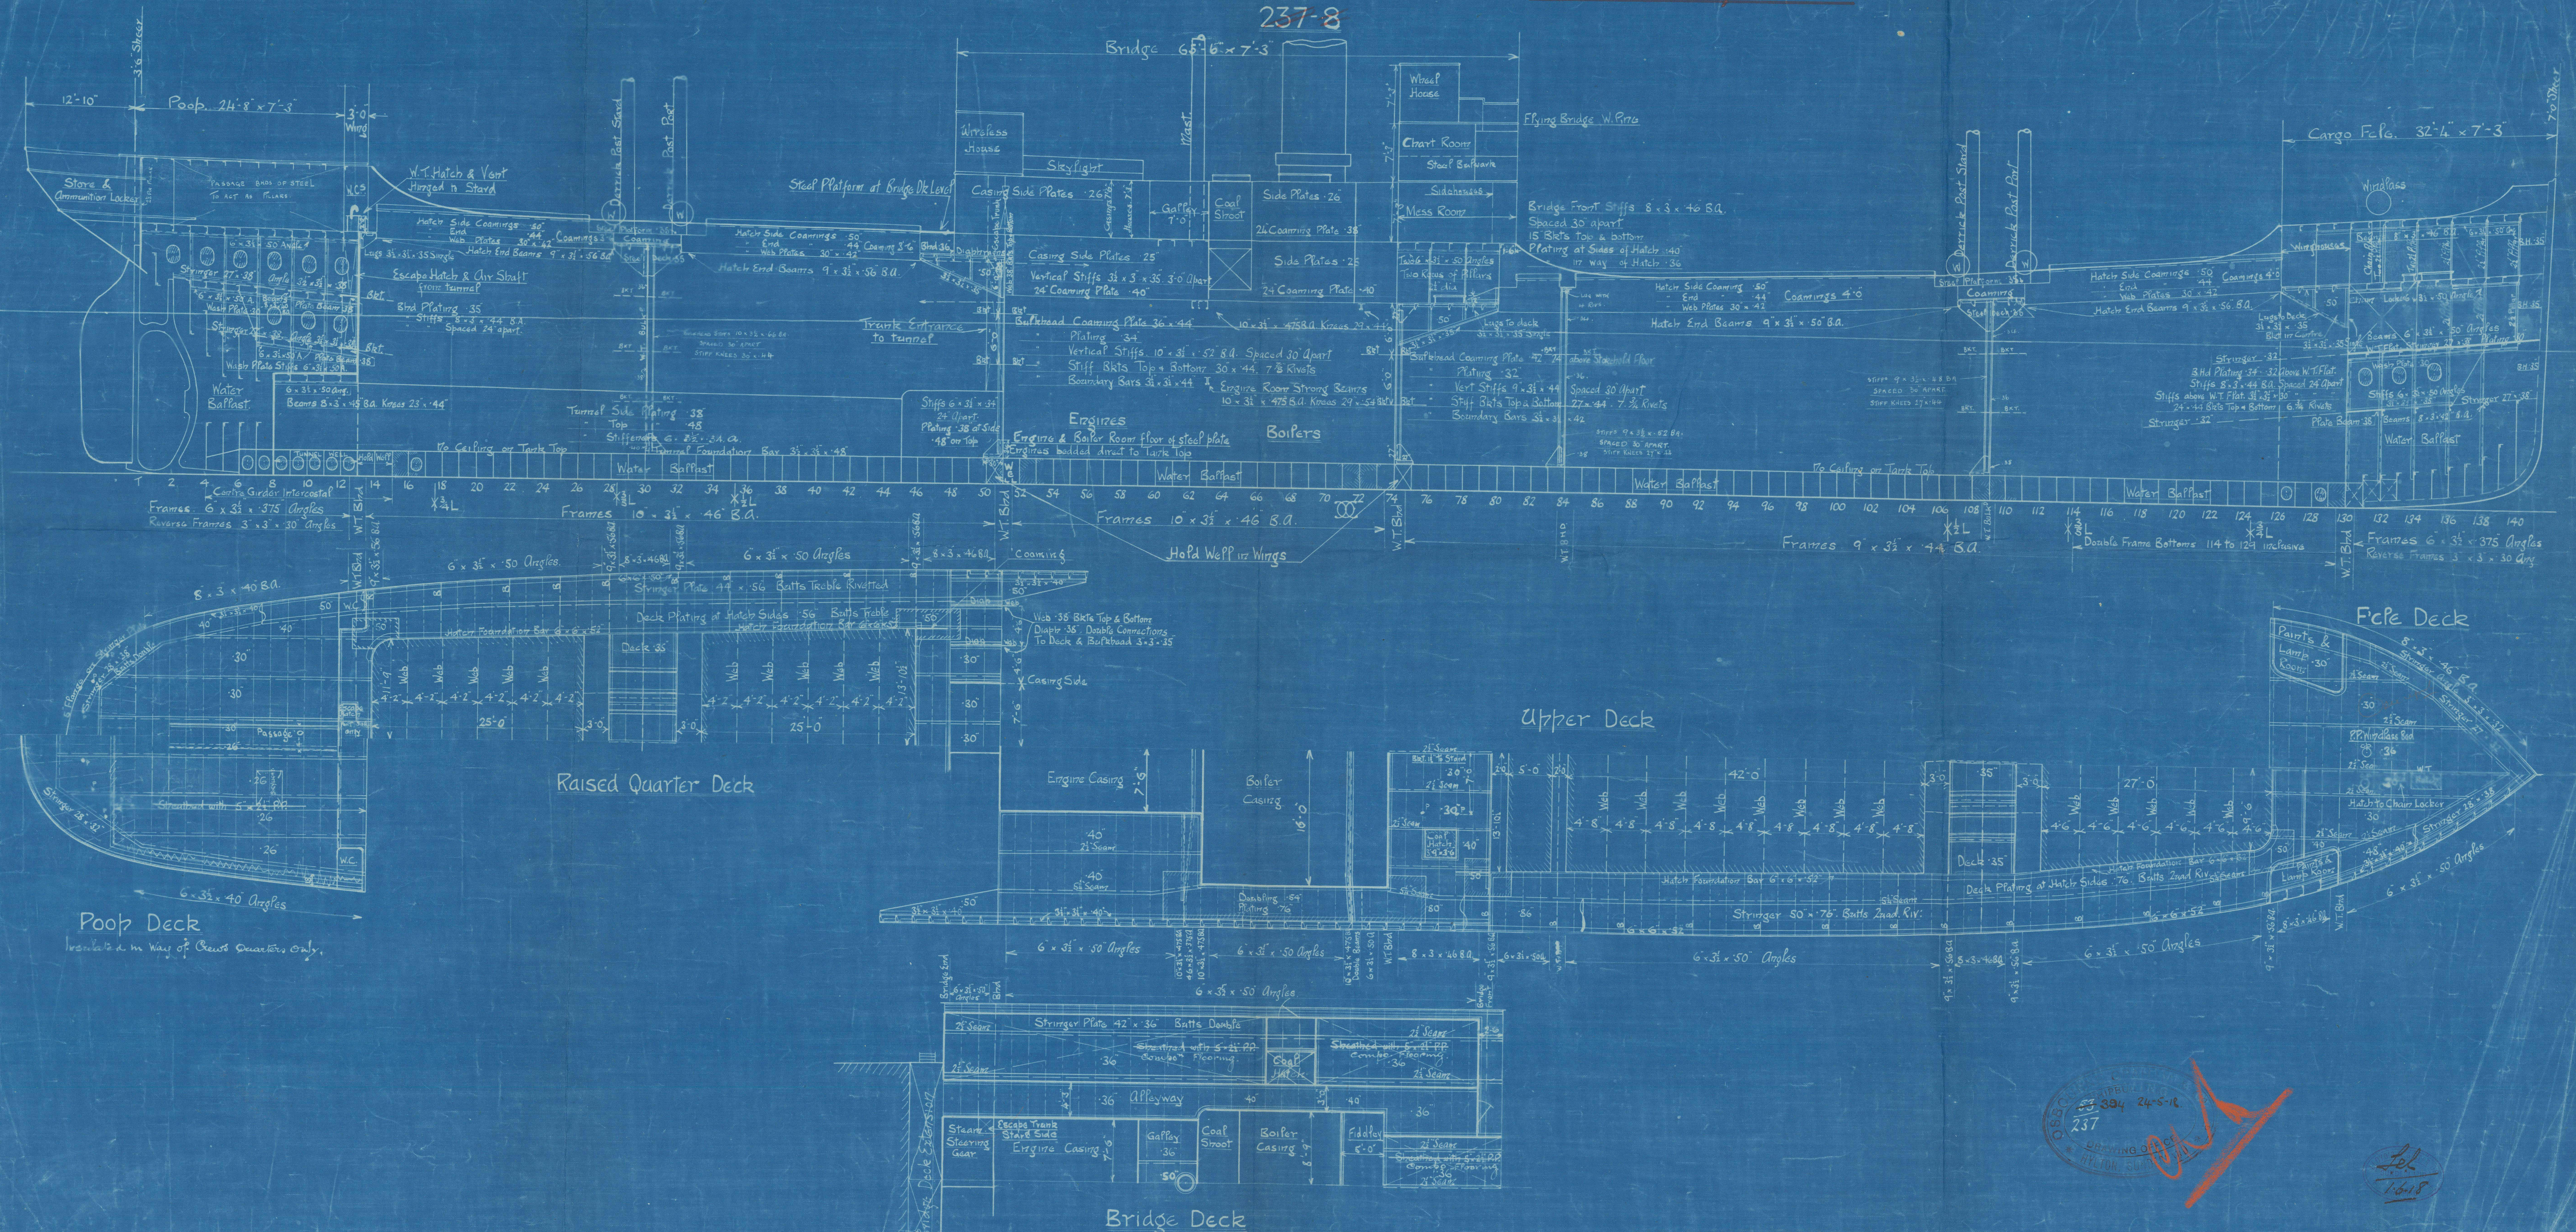



SUNDERLAND

Messrs OSBOURNE GRAMM & Co

PROFILE & DECK PLANS

No. 238

P.S. "WAR BATTERY"

See REPORT No 27246

REMAIN



© 2021

Lloyd's Register  
W1397-0042  
Foundation