


Working press - 140 lbs to Board of Trade & Lloyds.


Scale 1" = 1 Foot.

2 BOILERS PER No.

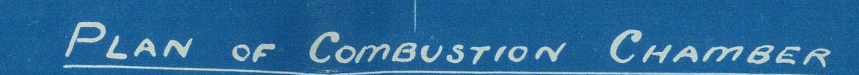

Stay tubes shown nutted, to
have nuts outside plates at both ends.

N^os 212. 213.

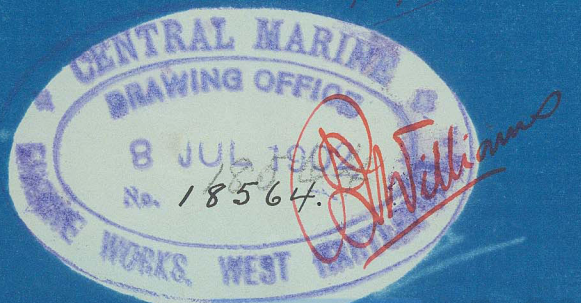

Londonderry Shipbuilding
& Engineering Co Ltd
No. 52
D. P. 140



2879
Lloyd's Cert
300 lbs
H. A. S.

20.10.02

"Bidston"

~~Hpl. Report No. 11997~~

Del. 5571.



© 2021

Lloyd's Register
Foundation