

287

7

J. J. Cerea,

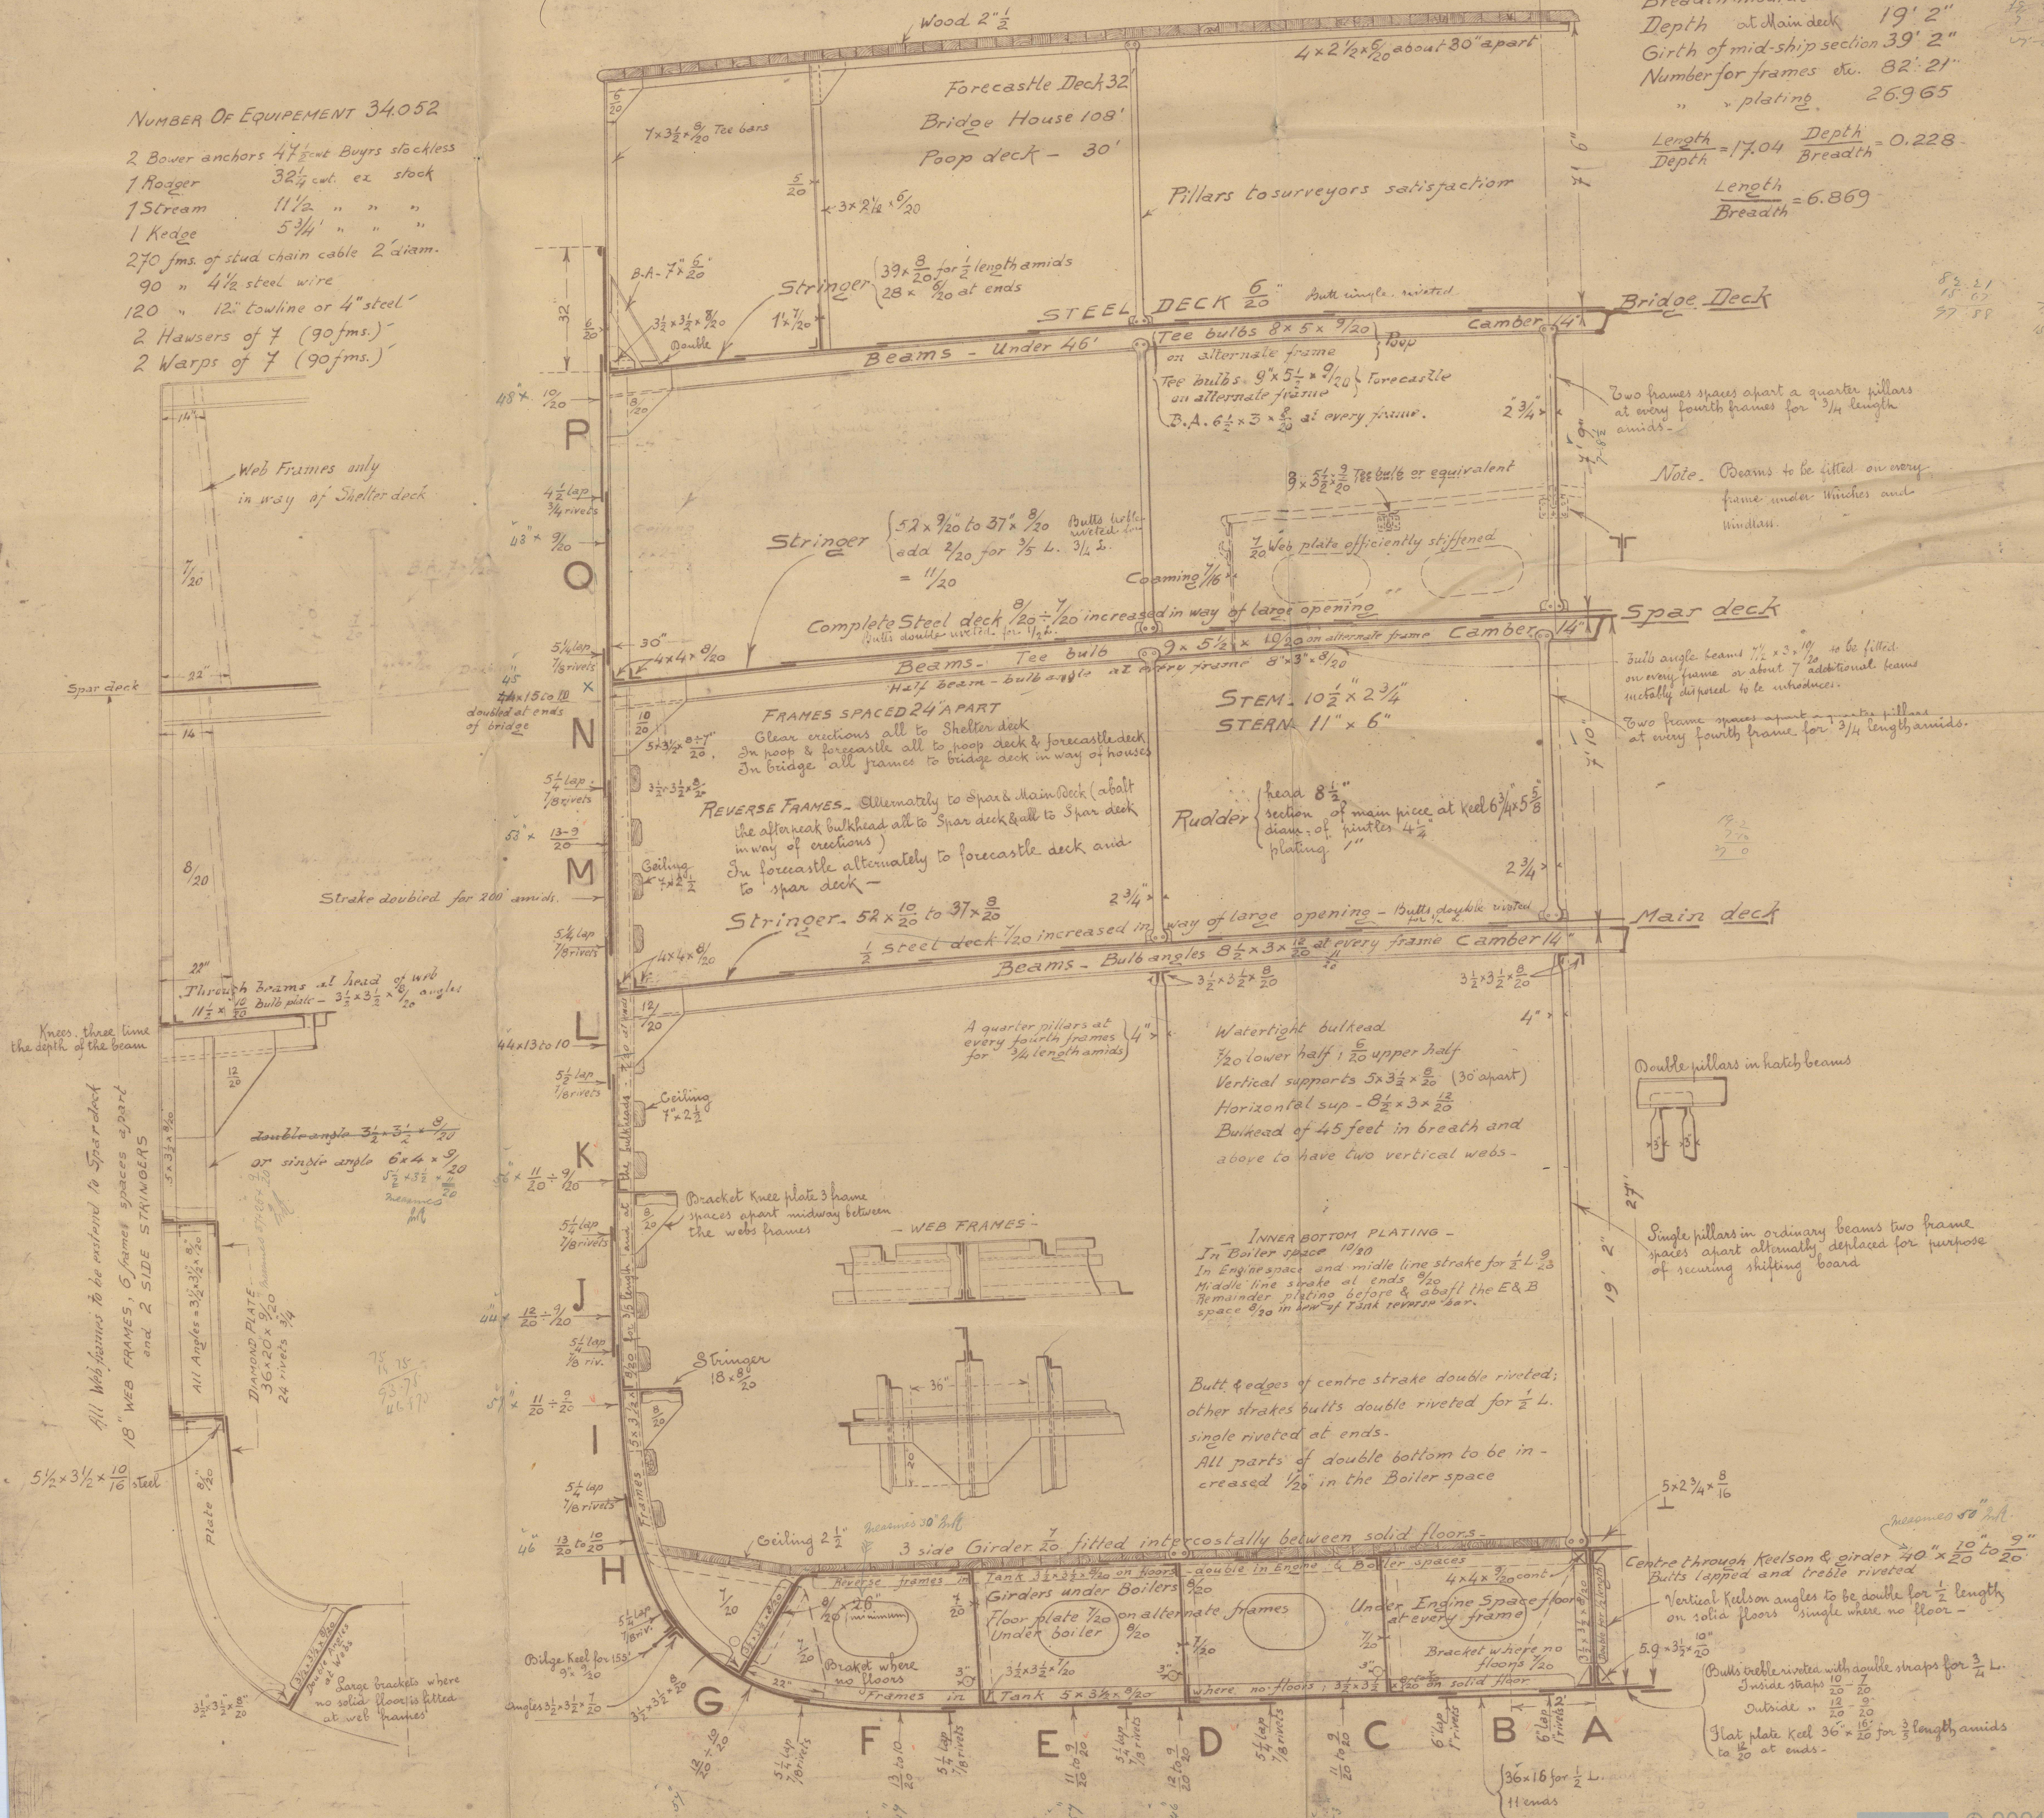


Scale 1:25

2 Bow anchors 4 1/2" Buys stockless
7 Rogger 32 1/2 cwt. ex stock
1 Stream 11 1/2 " " "
1 Kedger 5 3/4 " " "
270 fms. of stud chain cable 2" diam.
90 " 4 1/2 steel wire
120 " 12" towline or 4" steel"
2 Hawseers of 7 (90 fms.)
2 Warps of 7 (90 fms.)

Length between perp. 328' 2"
Breadth moulded 44' 9"
Depth at Main deck 19' 2"
Girth of mid-ship section 39' 2"
Number for frames etc. 82' 21"
 plating 26.965

$$\frac{\text{Length}}{\text{Depth}} = 17.04 \quad \frac{\text{Depth}}{\text{Breadth}} = 0.228$$

$$\frac{\text{Length}}{\text{Breadth}} = 6.869$$


W1404-0071

Cerea

Madship Action
S.B. Cerea"
Muggians to y

RETAILER

© 2021

Lloyd's Register
Foundation

W1404-0071