


# Midship Section of Steel Steam-Drifter.

Scale  $\frac{3}{4}$  = 1 foot.

H<sup>o</sup> 14.

Class. 100 A.1.

Length as per rule 77.062 ✓  
Breadth moulded 17.75 ✓  
Depth " 9.00 ✓

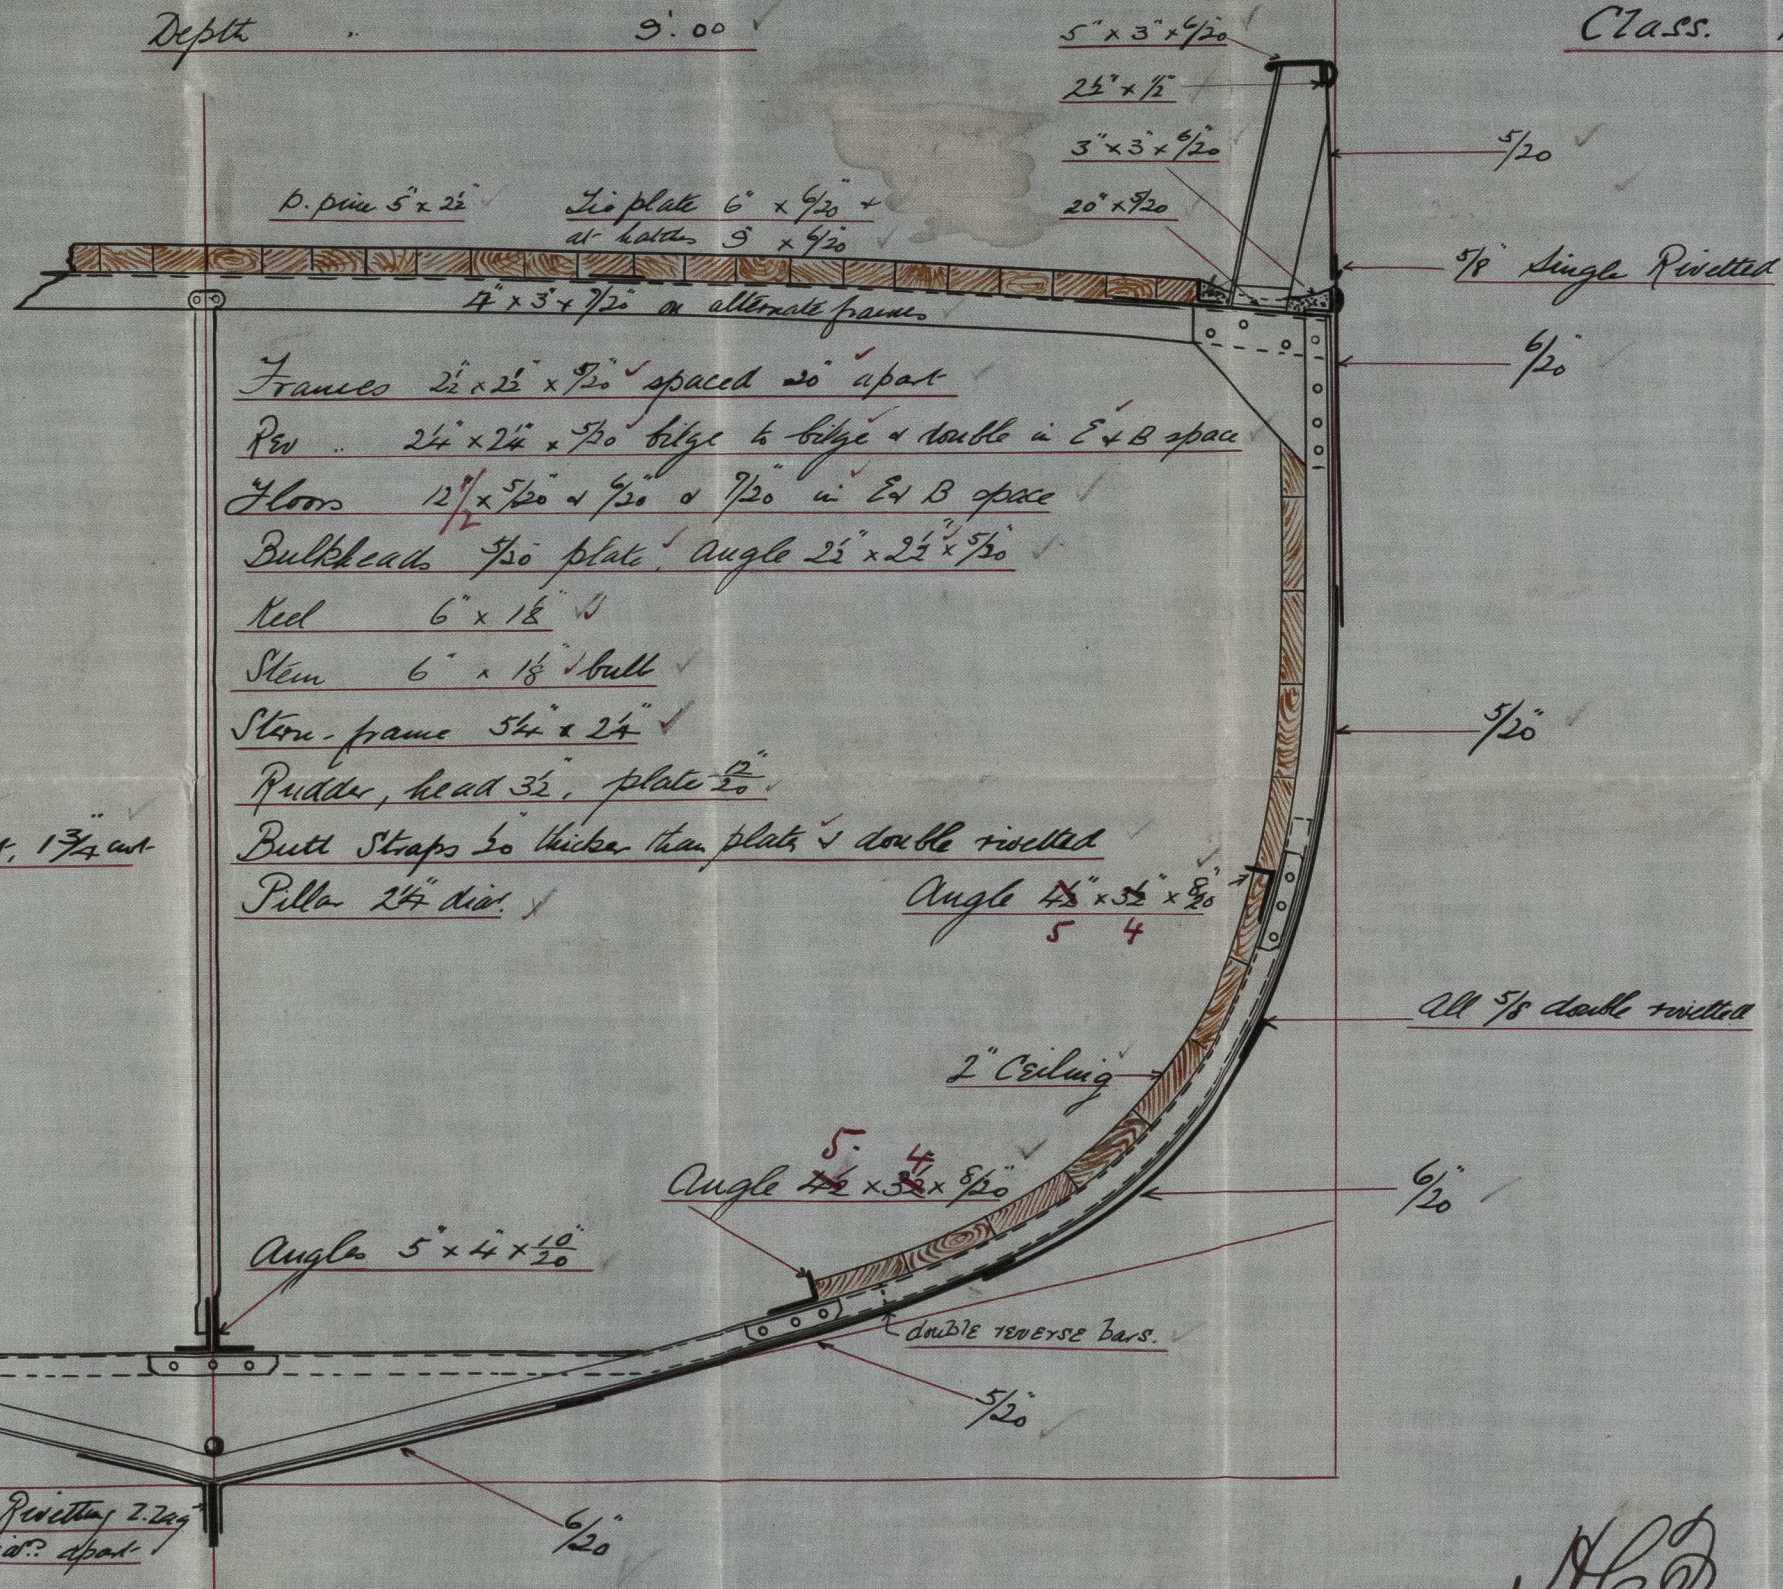

## Equipment

Anchor . ex. stock . . . 3 cut, 3 cut, 1 3/4 cut ✓  
60 fathoms 7/8" chain cable ✓  
60 " of 6" hawser ✓  
60 " 2 1/2" warp ✓

George Cosper  
Ship Designer  
Hull.  
23.4.03

C.D.  
24.4.03.





Gridship Section

Drifter N<sup>o</sup>. 14  $\frac{3}{4}$

Geo Cooper

$\frac{3}{4}$  Earn

Hull Report No. 15643

© 2021

Lloyd's Register  
Foundation

W1431-0246