

S.S. No 417
PROFILE & DECK PLAN

SCALE 1/8" = 1 FOOT

DIMS 405' 0" B.P. 55' 6" MID 34' 10" TO UNITS OF



BULB ANGLES TO 1924 BRITISH
STANDARD EXCEPT WHERE STATED.

L = 404' 0", D = 35' 8" B = 35' 5" d = 23' 6"

To CLASH 100% WITH FREEBOARD COMPLETE SUPERSTRUCTURE WITH TONNAGE OPENING

NOTE -
LARGE BAYS TO BE FITTED TO TOP AND BOTTOM
OF DOUBLE STIFFS ON THE BHD. AT HATCH
END, IN HOLDS AND TWEEN DECKS
PLACING UNDER WINDLASS, WINCHES, AND
MASTS TO SURVEYOR'S SATISFACTION.

Setting under windlass, winches, mast or
6.6.6. to be under tank

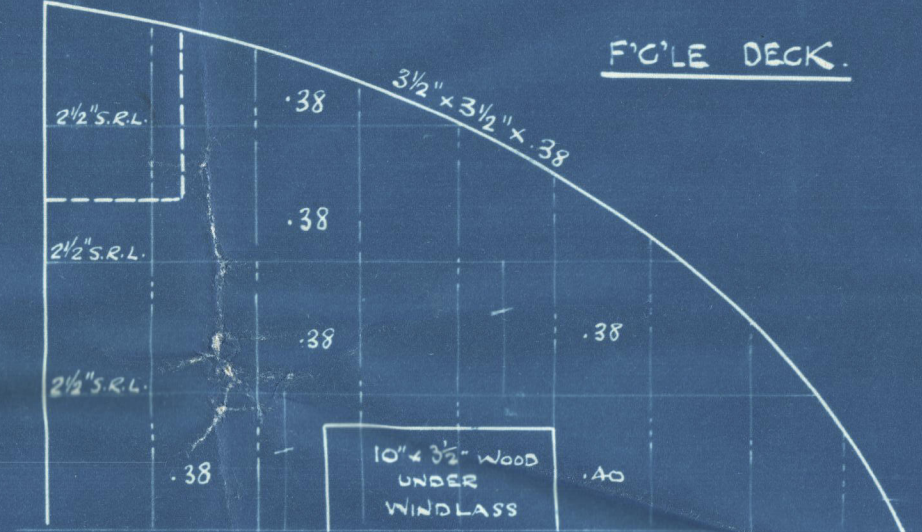 


The Greenock Dockyard &
S. S. "BARRWHIN"

N^o 417.

Profile & Deck Plans.

Amended.

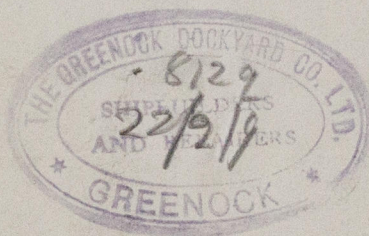

G.K. Rep^t N^o 19106.

W148-0046



© 2021

Lloyd's Register
Foundation