

# S.S. 417 PROFILE AND DECKS

SCALE 1/8" = 1 FT

See Note on p. 101 of British Standard  
draft No. 1000 (1933)

See Note on p. 101 of British Standard  
draft No. 1000 (1933)

L. 404 Q. D. 35.85. B. 55.5. d. 73.02

To CLASS 100 A1. With FREEBOARD. COMPLETE 3.3. WITH TONNAGE OPENING


Following under tonnage which must be  
to tonnage satisfactory

Detail sketch of connection of hull  
and branch deck showing 6-6  
submitted

The Greenock Dockyard  
COMPANY LIMITED  
GREENOCK

DIMS. 405' O.P. 55' G.M.D. 35' 10" U.P. 7' 10" D.

Hull frames taking 100 lbs. to be increased to 100 lbs. in hull  

 


## ALTERNATIVE PANTING ADDENDUM

See Frames 35, 36, 37, 1000

APPROVED  
LLOYD'S REGISTER OF SHIPPING

DATE 21. 1. 29



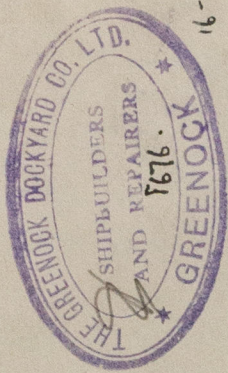

16-1-19

Profile and Decks

No 417.

See later

X1148-0048

The Greenock Dock. Co.  
S.S. "BARRWHIN"  
No 417.

Profile & D.K. plans.  
See also amended plan.

Gr.K. Ref. No. 19106.

X1148-0048



© 2021

Lloyd's Register  
Foundation