

Scale $\frac{1}{2}$ " Inch = 1 Foot.

The Greenock Dockyard Co^{ltd}.
Greenock.

DIMENS L 404'-0" x 55'-6" x { 27'-10" SECOND DECK
36'-10" UPPER DECK.
TO CLASS 100A.1. COMPLETE SUPERSTRUCTURE VESSEL
WITH TONNAGE OPENING (WITH FREE BOARD)

6 x 3 1/2" x 40"
4 7/8" RVS. THRO. REV. FR.

SKELETON FLOOR

The Greenock Dock Co.

S.S. "BARRWHIN"


N. 417.

Midship Section
as Built.

Genl. Rep. N. 19106.

W148-0049

W148-0049

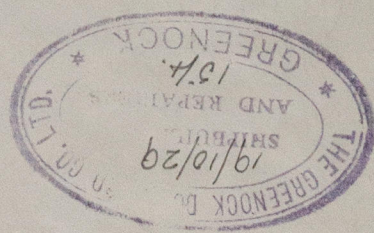

© 2021

Lloyd's Register
Foundation