


EQUIPMENT NO.

SCALE $\frac{1}{2}" = 1$ FOOT.

EQUIPMENT		QTY
2	STOCKLESS ANCHORS BOWER	630 LBS EACH
1	" " " "	540 LBS
1	STREAM ANCHOR EX STOCK	170 LBS
270	FATHOMS	2 1/2" STUD CHAIN CABLE
90	"	4 3/4" STEEL WIRE
120	"	5" " " " TOWLINE
2 AT 90	"	2 3/4" " " " HAWSEERS
2 AT 90	"	7" MANILLA

W148-0079

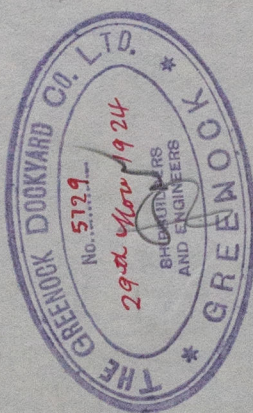

The Greenock Dockyard Co.
S. A. "BARRON" ^{PLE}
No. 408.

Midship Section
(amended)

Genl. Ref. No. 18479.

W148-0079



© 2021

Lloyd's Register
Foundation