


S.S. No 408.
PROFILE & DECK PLAN.
SCALE 1/8" = ONE FOOT.

DIMS. 400'-0" x 54'-0" MLD. x 28'-8" MLD.
Ruled Length 399.75 (Net 3 par. 1)

Supports under windlass winches must be to Surveyors Satisfaction

 

APPROVED
LLOYDS REGISTER OF SHIPPING
Mantagonville for 1414
DATE 14.11.14

The Great Dock C. L.

S. S. "BARRADALE"

No. 408.

Profile & Deck plans.

Gen. Rep. No. 18479.

VII48-0083



© 2021


Lloyd's Register
Foundation

Nº 408

Lloyds. App.

PROFILE + DECK

3

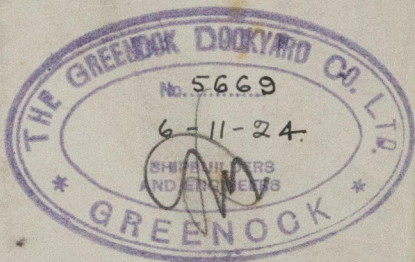

"Barrdale"

Srk. 18479.

W148-0083



© 2021

Lloyd's Register
Foundation