

PROFILE AND DECK PLANS


DIMENSIONS - 390'0" x 52'6" x 27'3" MOD. NO. 55-3 MOD. NO. 52

To Class 100A1 At Lloyd's




Scale 8" = 1'00'

MINIMUM SCANTLINGS REQUIRED


28.6.19  
10.5.20  
28.1.20 (545)

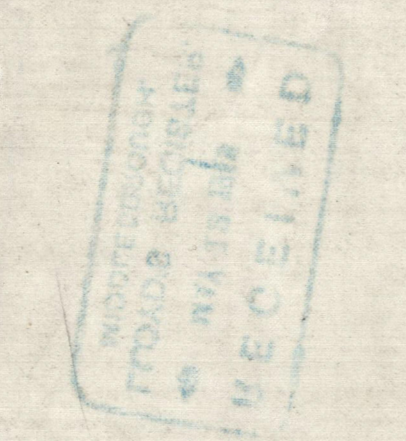


anchors, Winches, Windlasses & other gear  
as specified to Surveyors Certificate

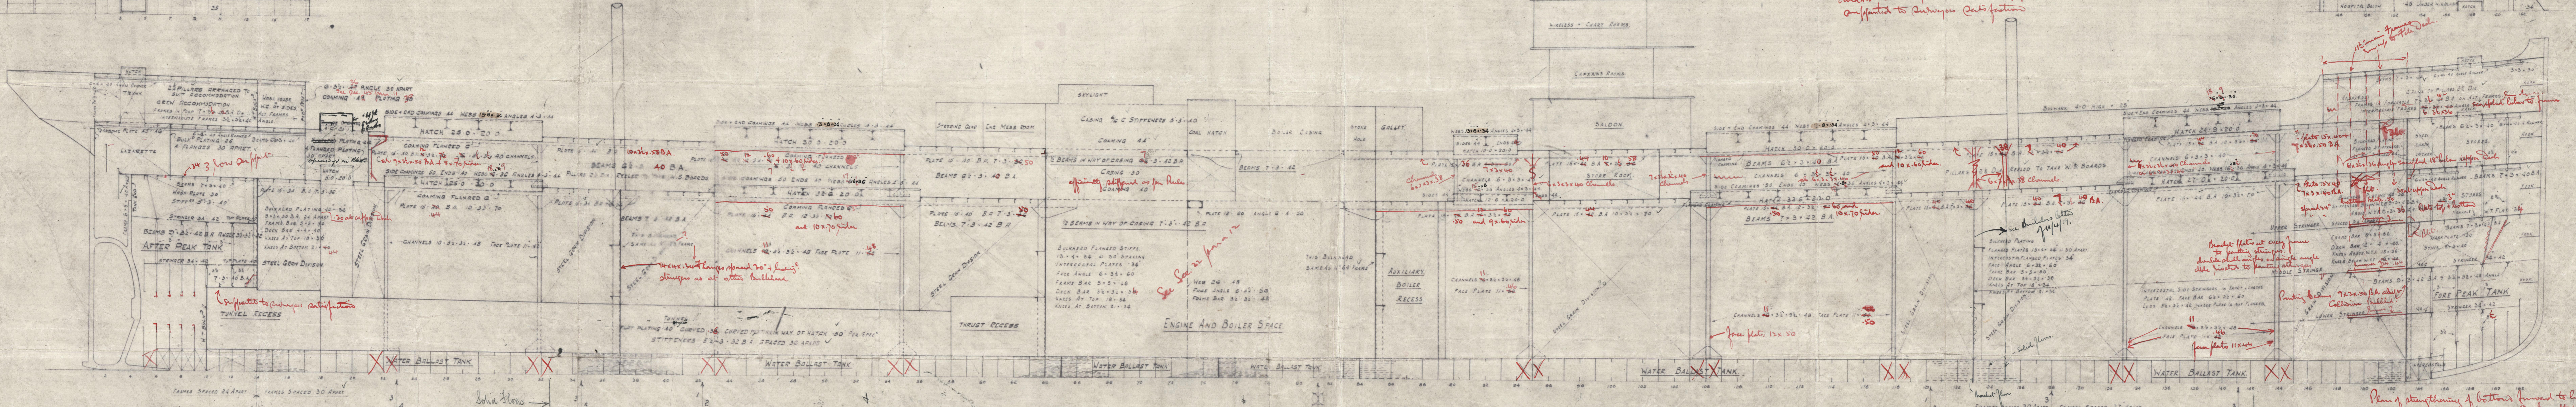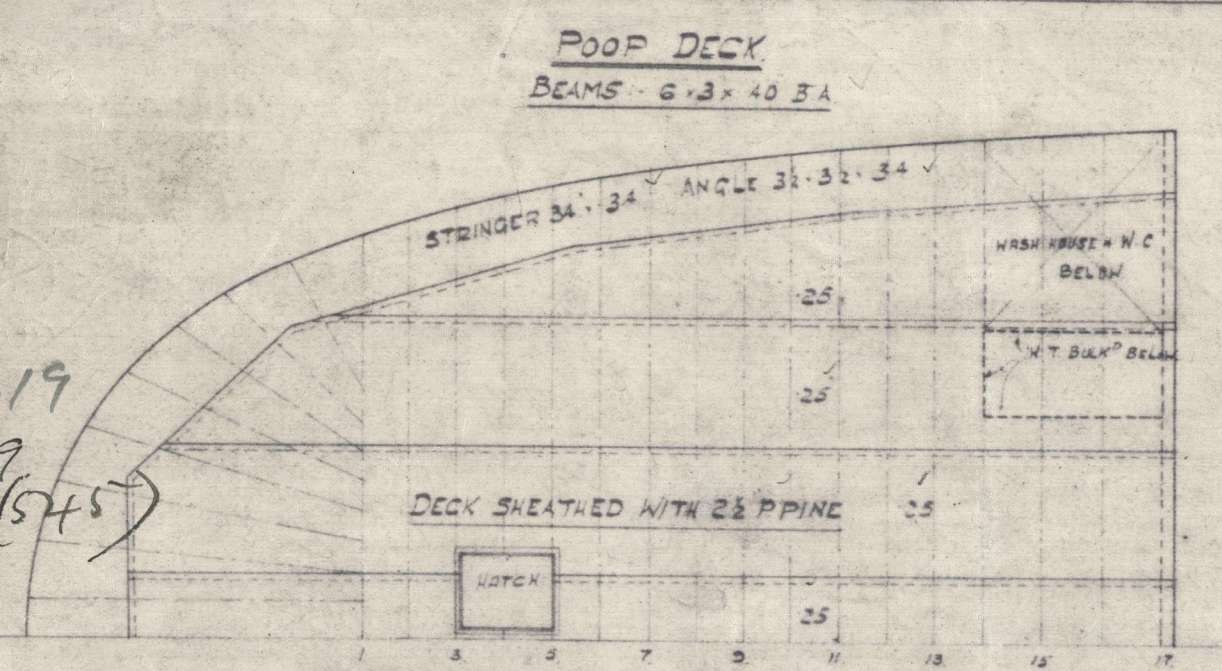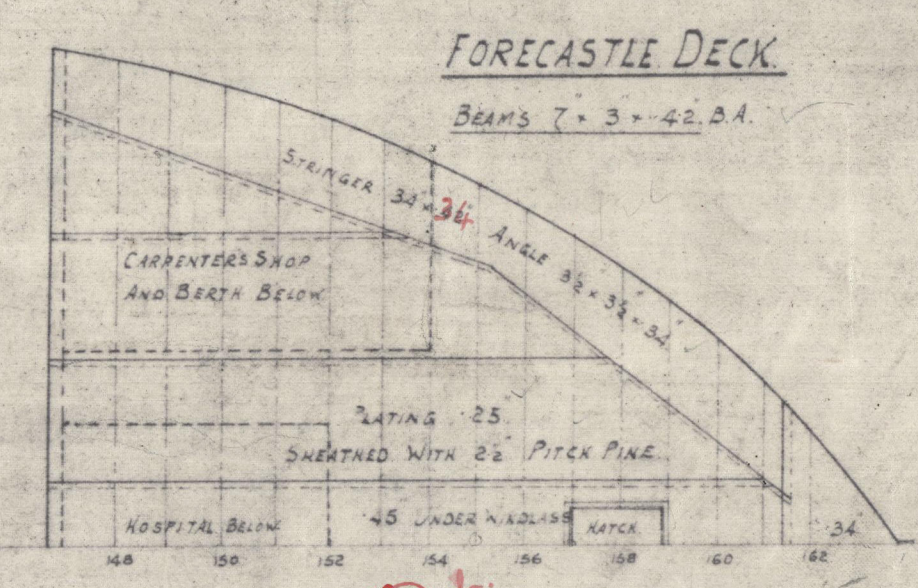

SHELTER DECK  
BEAMS 6-3 x 42 B.A.

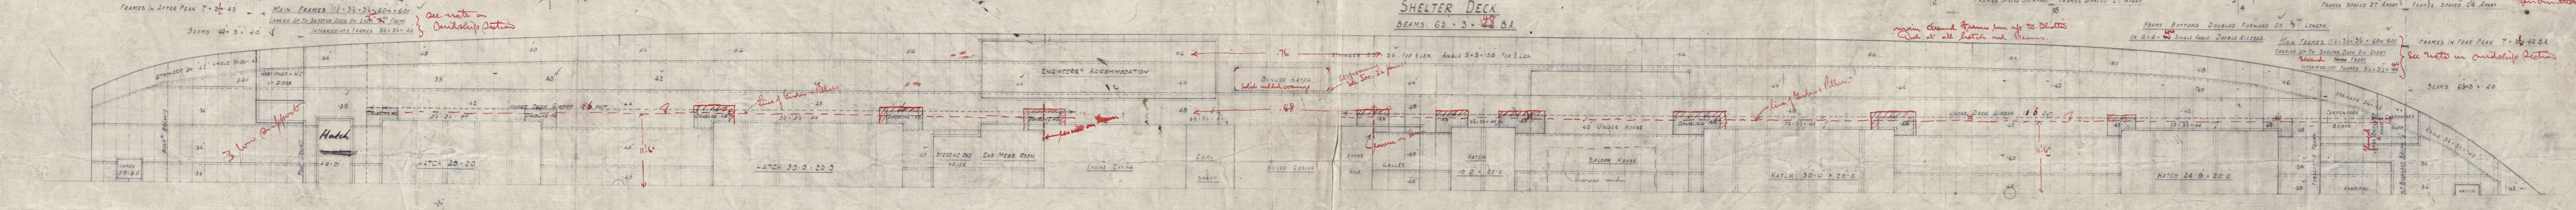

UPPER DECK  
BEAMS 7-3 x 42 B.A.

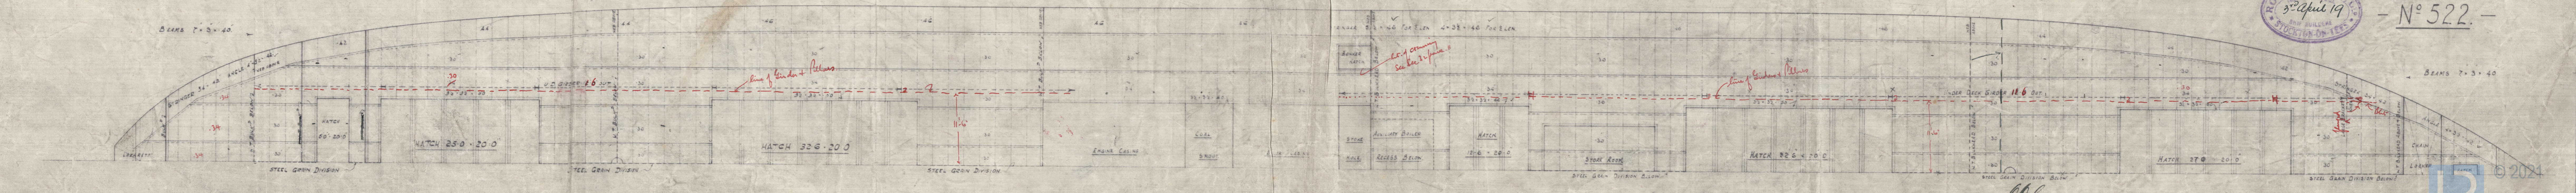




N° 522

28.6.19



Miss Roper House

No. 522, 545  
Profile & Decks

"Aust"  
No 522. S.S. H.H. Roquith.  
Mdt report No 10713

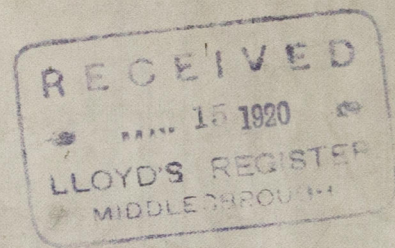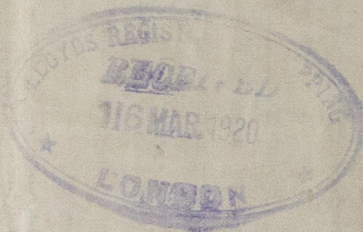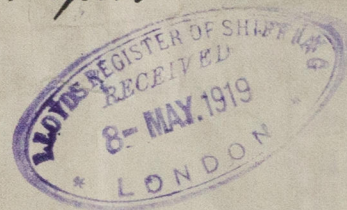

W148-0149

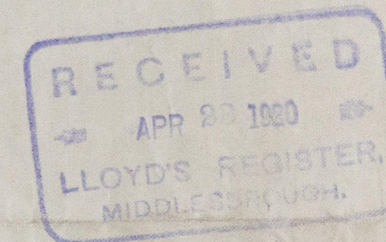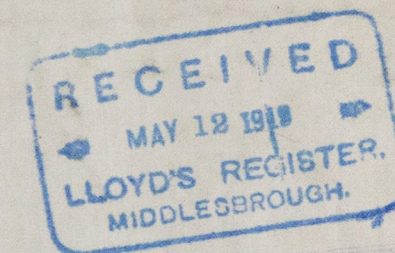

W148-0149



© 2021

Lloyd's Register  
Foundation