


PROFILE. (as built)

NO 1036-7

TURBINE STEAMER 380'-0" x 45'-0" x 18'-6" (TO MAIN DECK)

T.S.S. "CAMBRIA" & "SCOTIA".

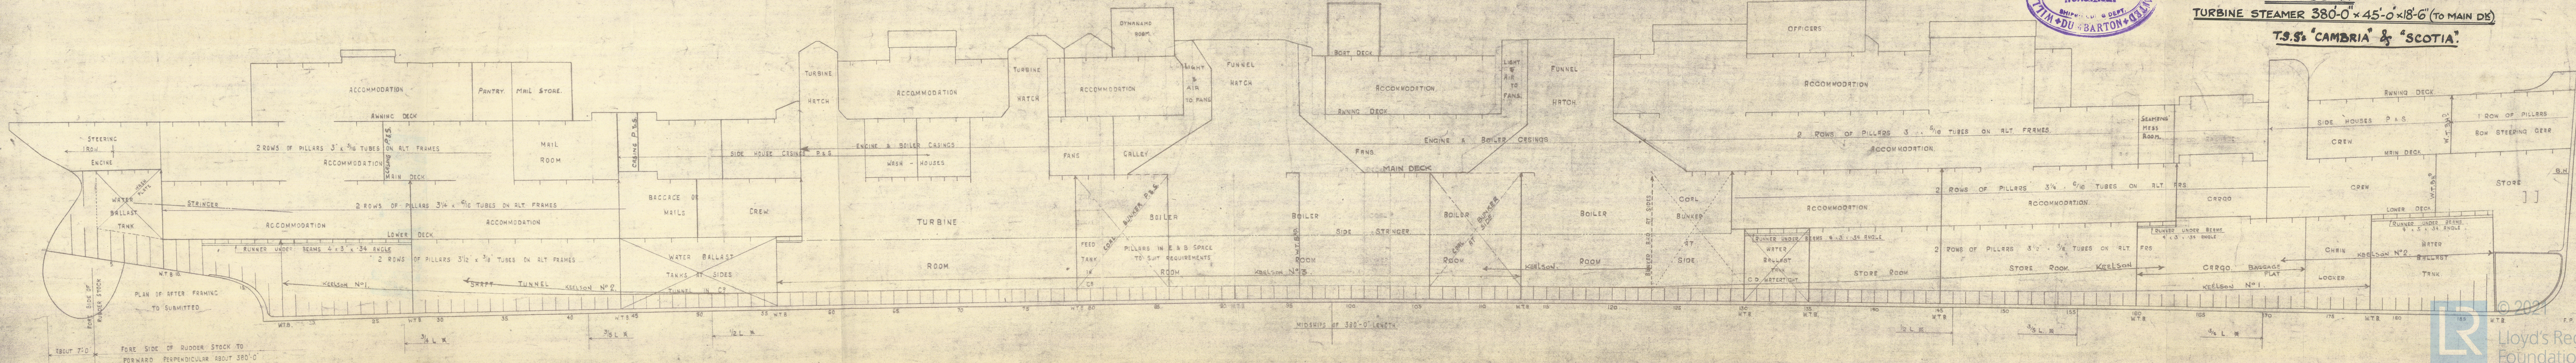

W. Denny Bros. Ltd.

No. 1036.

T.S.S. "Lambica"

GLASGOW REPORT No. 41541

Profile (as built)

RETAIN



© 2021

Lloyd's Register
Foundation