

Yard No 30

THIS DRAWING IS STRICTLY CONFIDENTIAL
AND MUST ON NO ACCOUNT BE COPIED OR
DISCLOSED FOR ANY THIRD PERSON.

ODENSE, DATE: 2-8-27.
THOMAS B. THRIGE.

2 1/2 - 27. Noef.


Drw. No 97784

Pinion and shaft 11 Teeth corr. Mod. 2.2
for Steering Gear

1:2.5

Material: Best forged Siam. or Steel 60-70 kg/mm²
Elongation however not less than
25 per cent.

17/8/27

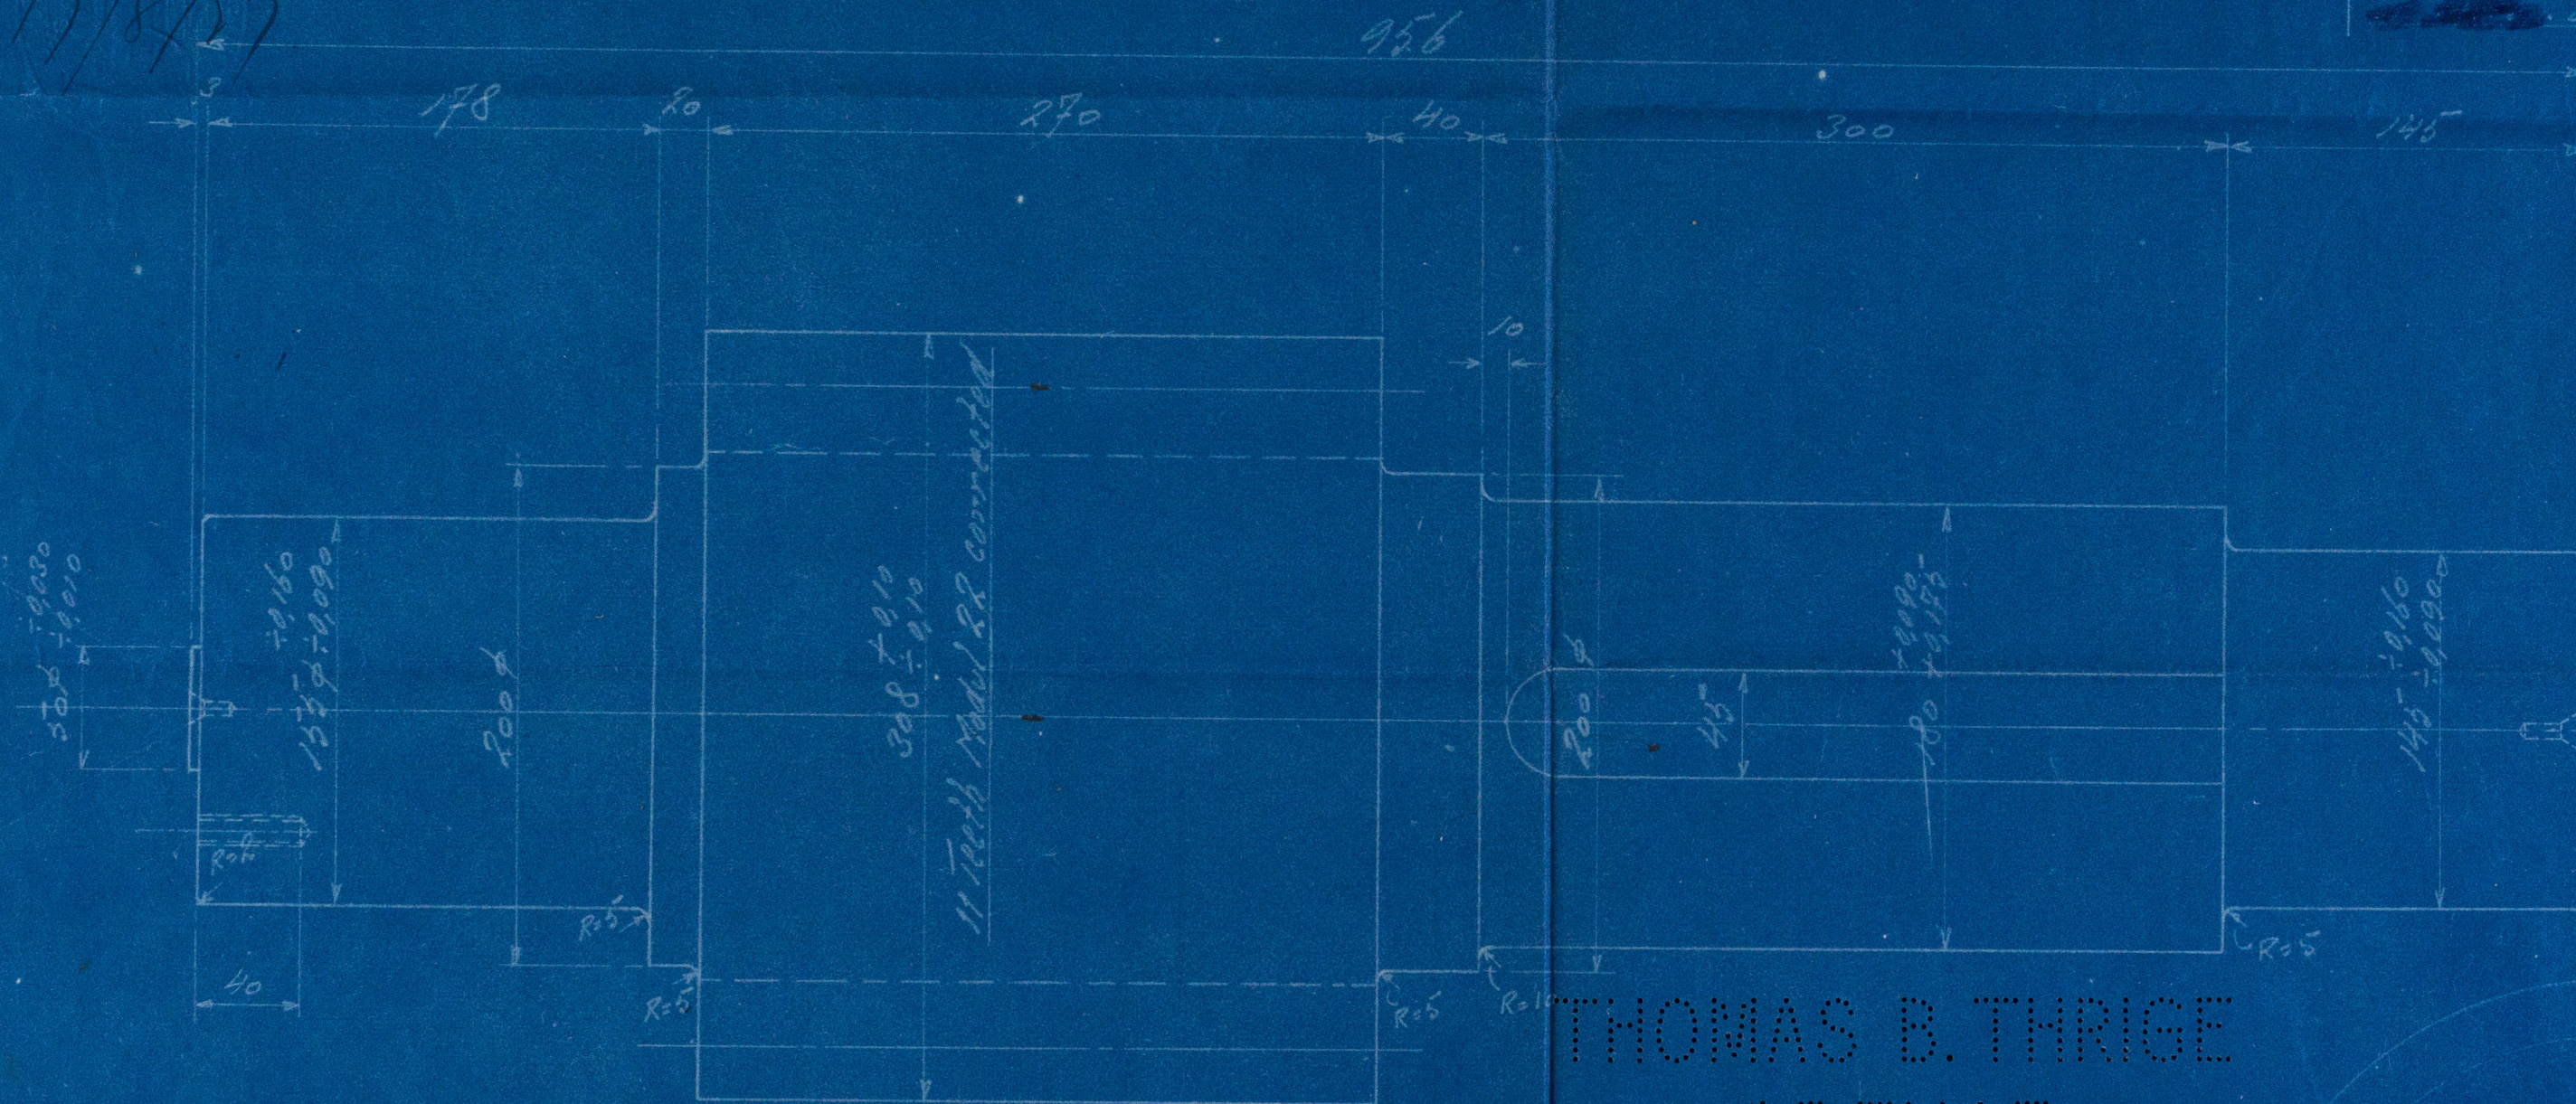


*rough sketch
of the gear
and
shaft*

Obs! 60° Centerholes
in ends of shaft

THOMAS B. THRIGE
ODENSE.

Teeth to be carefully cut.

Pinion and Quadrant should mesh especially
well, without play.

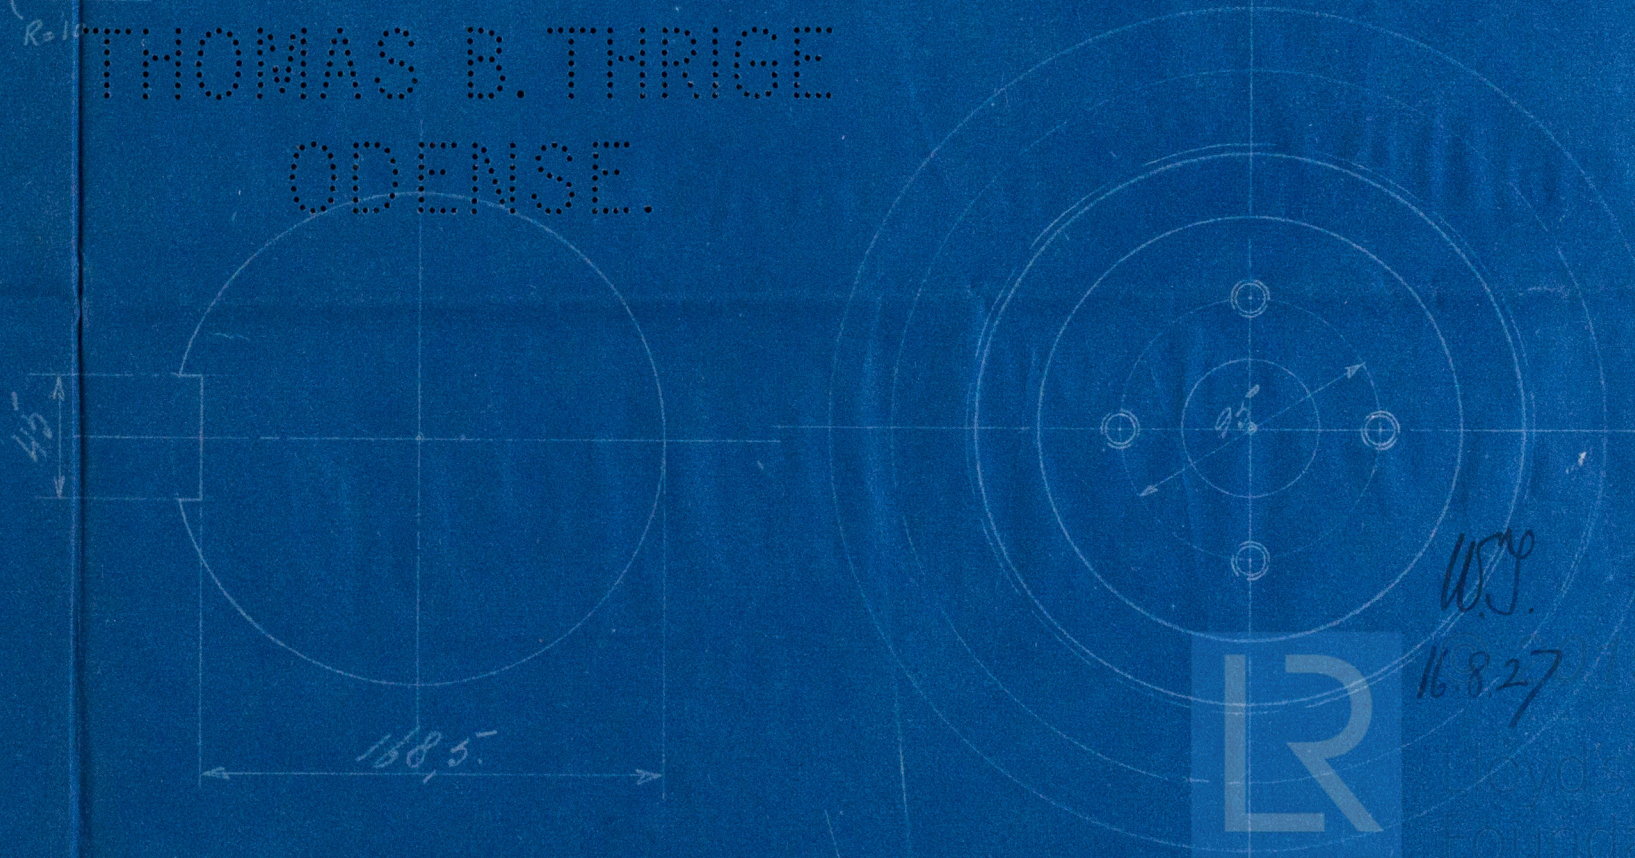

LR

16.8.27

1X151-0103

Pinion & Shafts


for Electric Steering gear
being made by

Thomas B. Thøgers, Odense,
for

the vessel Yacht No 30

being built by

Odense Skibsbyggeri,
ret A. P. Hiller.

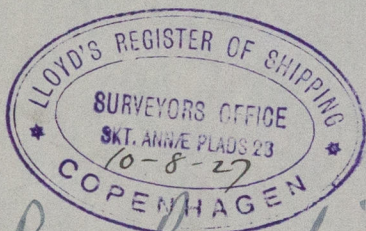

Ben Brush ex

M/s Caroline Mærsk

of Fredericia

cop. Rpt. Nr. 7845.

W151-0103



© 2019

Lloyd's Register
Foundation

97284