

E-13

$$\text{TOTAL G.D}^2 \text{ ---} = 9650 \text{ KG.M}^2$$

AKTIESELSKABET  
BURMEISTER & WAIN  
MASKIN- & SKIBSBYGGERI  
5-2 1921 N 34411

5010-1911

Intermediate Shafts

and

Screw Shafts


being made

by

AKTIESELSKABET  
BURMEISTER & WAIN'S MASKIN- OG SKIBSBYGGERI

for

Mrs. Odense Skalkitværk's  
Newbuilding Yard No 30.

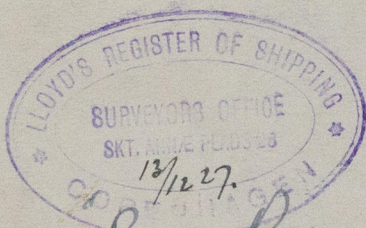

Ben Brush & Co

4/s Caroline Mask of Fredericia.

Apr. Rpt. v. 7845.

Lloyd's Register

W151-0105 Foundation