


— SCALE $\frac{1}{2}" = 1$ FOOT —

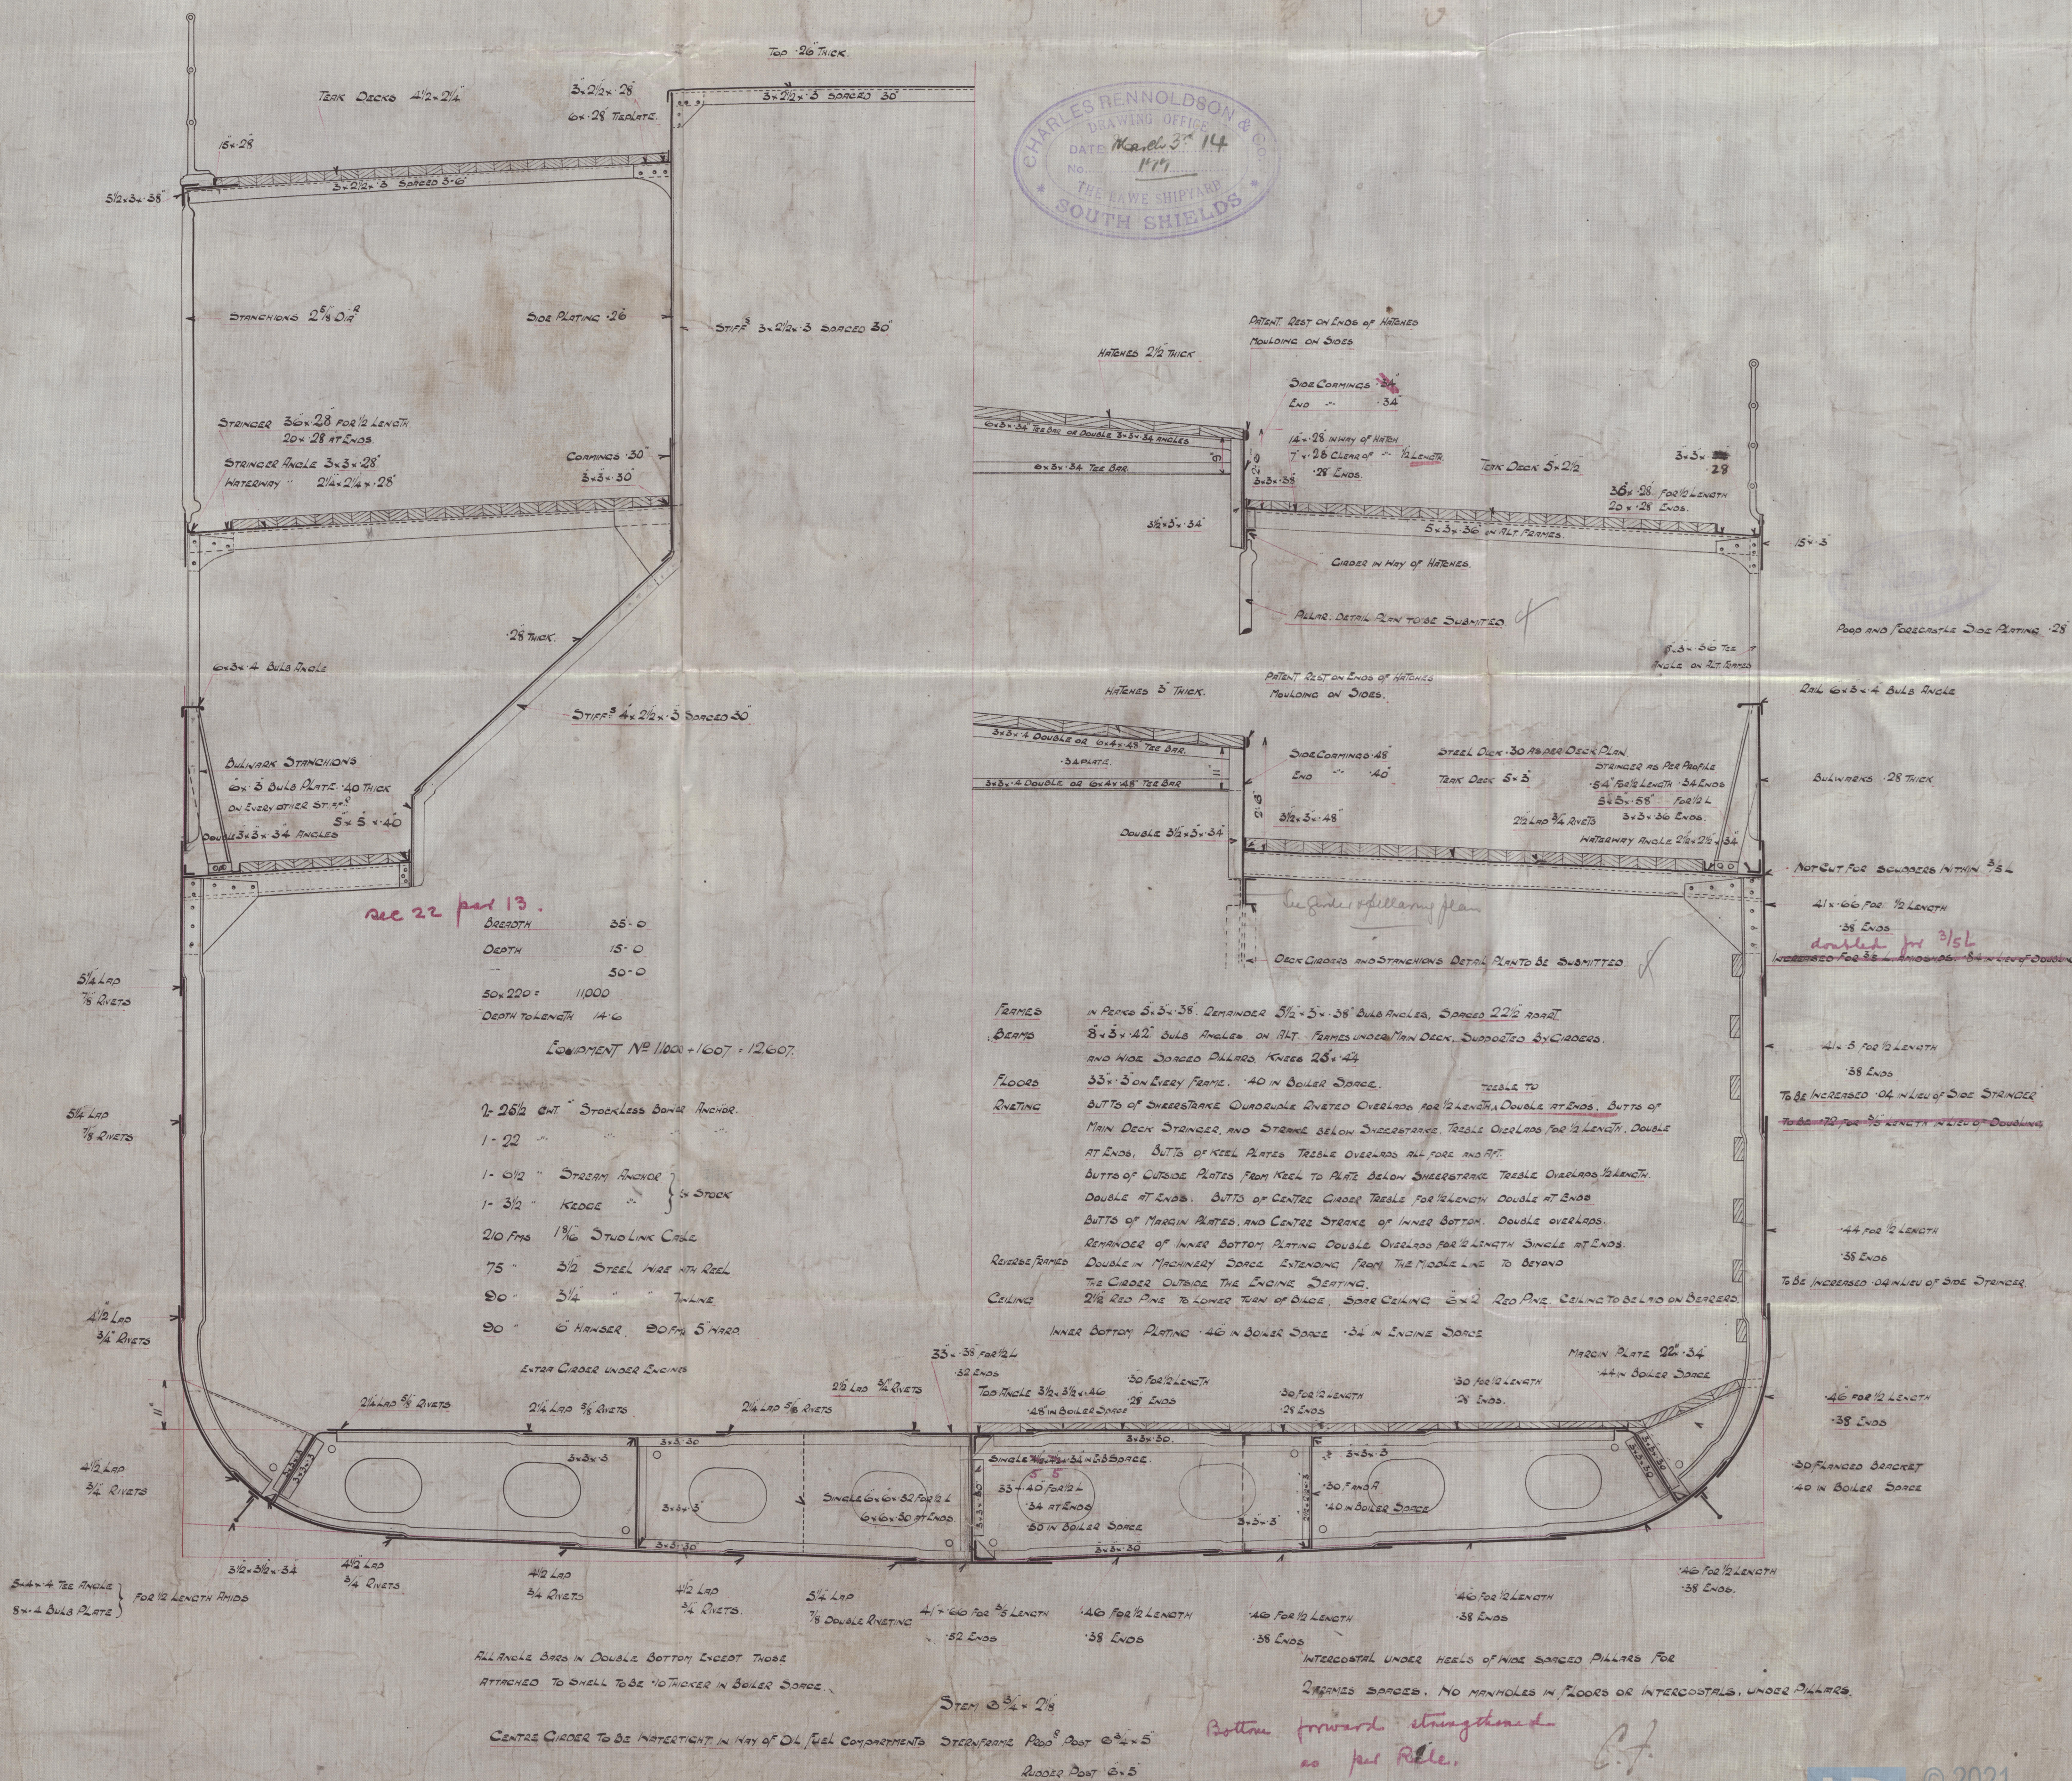

C. Renoldson & Co

167 Ship

Midship Section

S/S "MATA HARI"

NEWCASTLE ON TYNE

Report No 67646



© 2021

Lloyd's Register
Foundation

W1530-0172



C. Renoldson & Co

167 Ship

Midships Section

5/8 "MATA HARI"

NEWCASTLE ON TYNE

Report No 67646



01520-0172



© 2021

Lloyd's Register
Foundation