


SKETCH 3	Copied for	Date	Returned
JOB M. 159			
To			

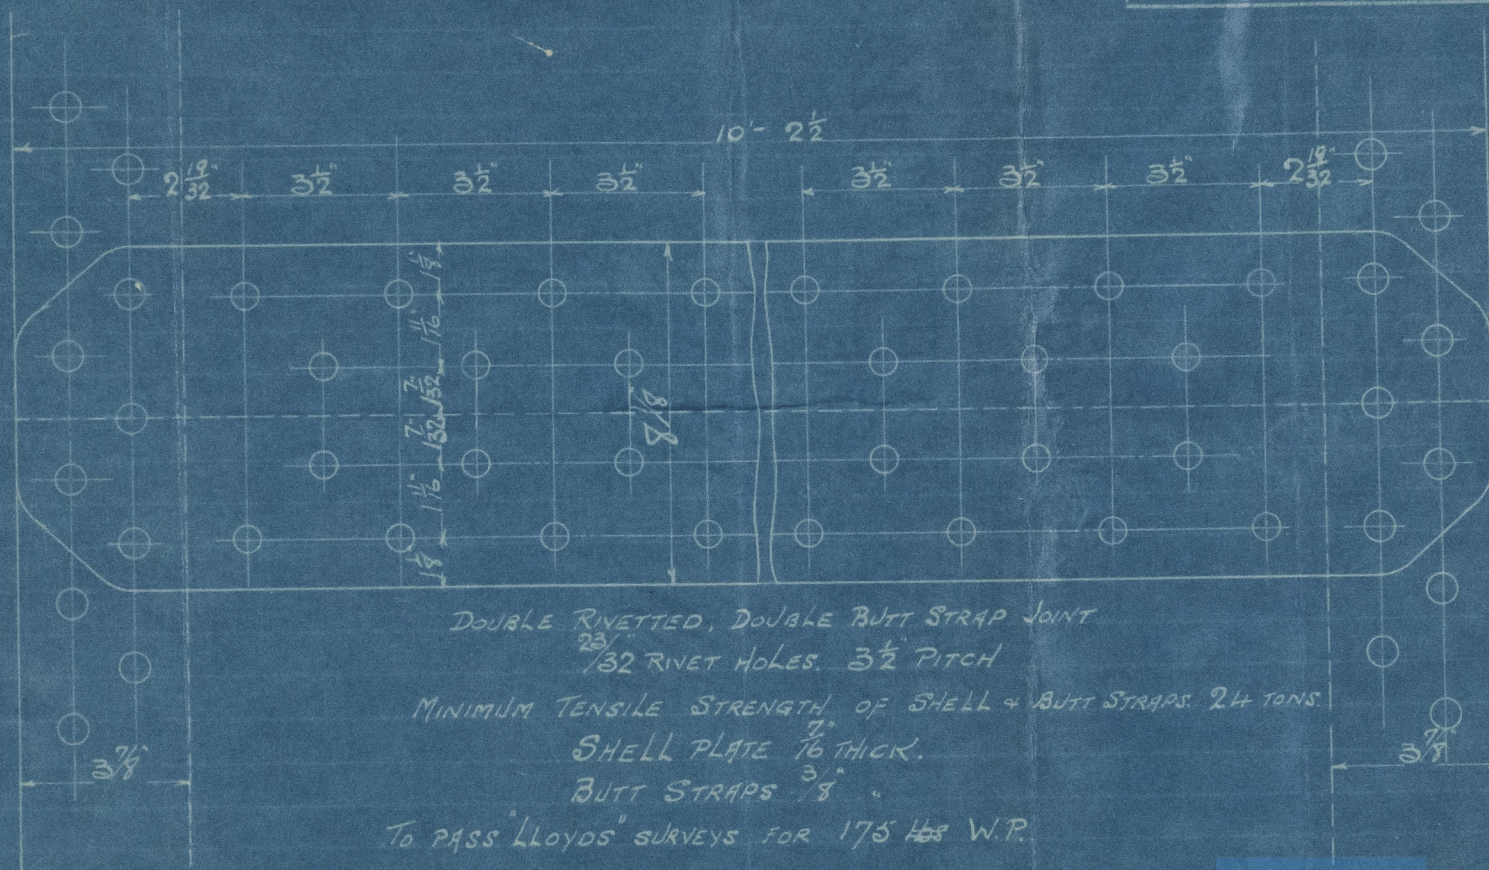

*Amended plan of seam of steam drum* HC

Checked by	Date	BABCOCK & WILCOX LTD., RENFREW.		
		Drawn by	Checked by	Passed by

Lloyd's Register  
 Foundation