


12/2/18

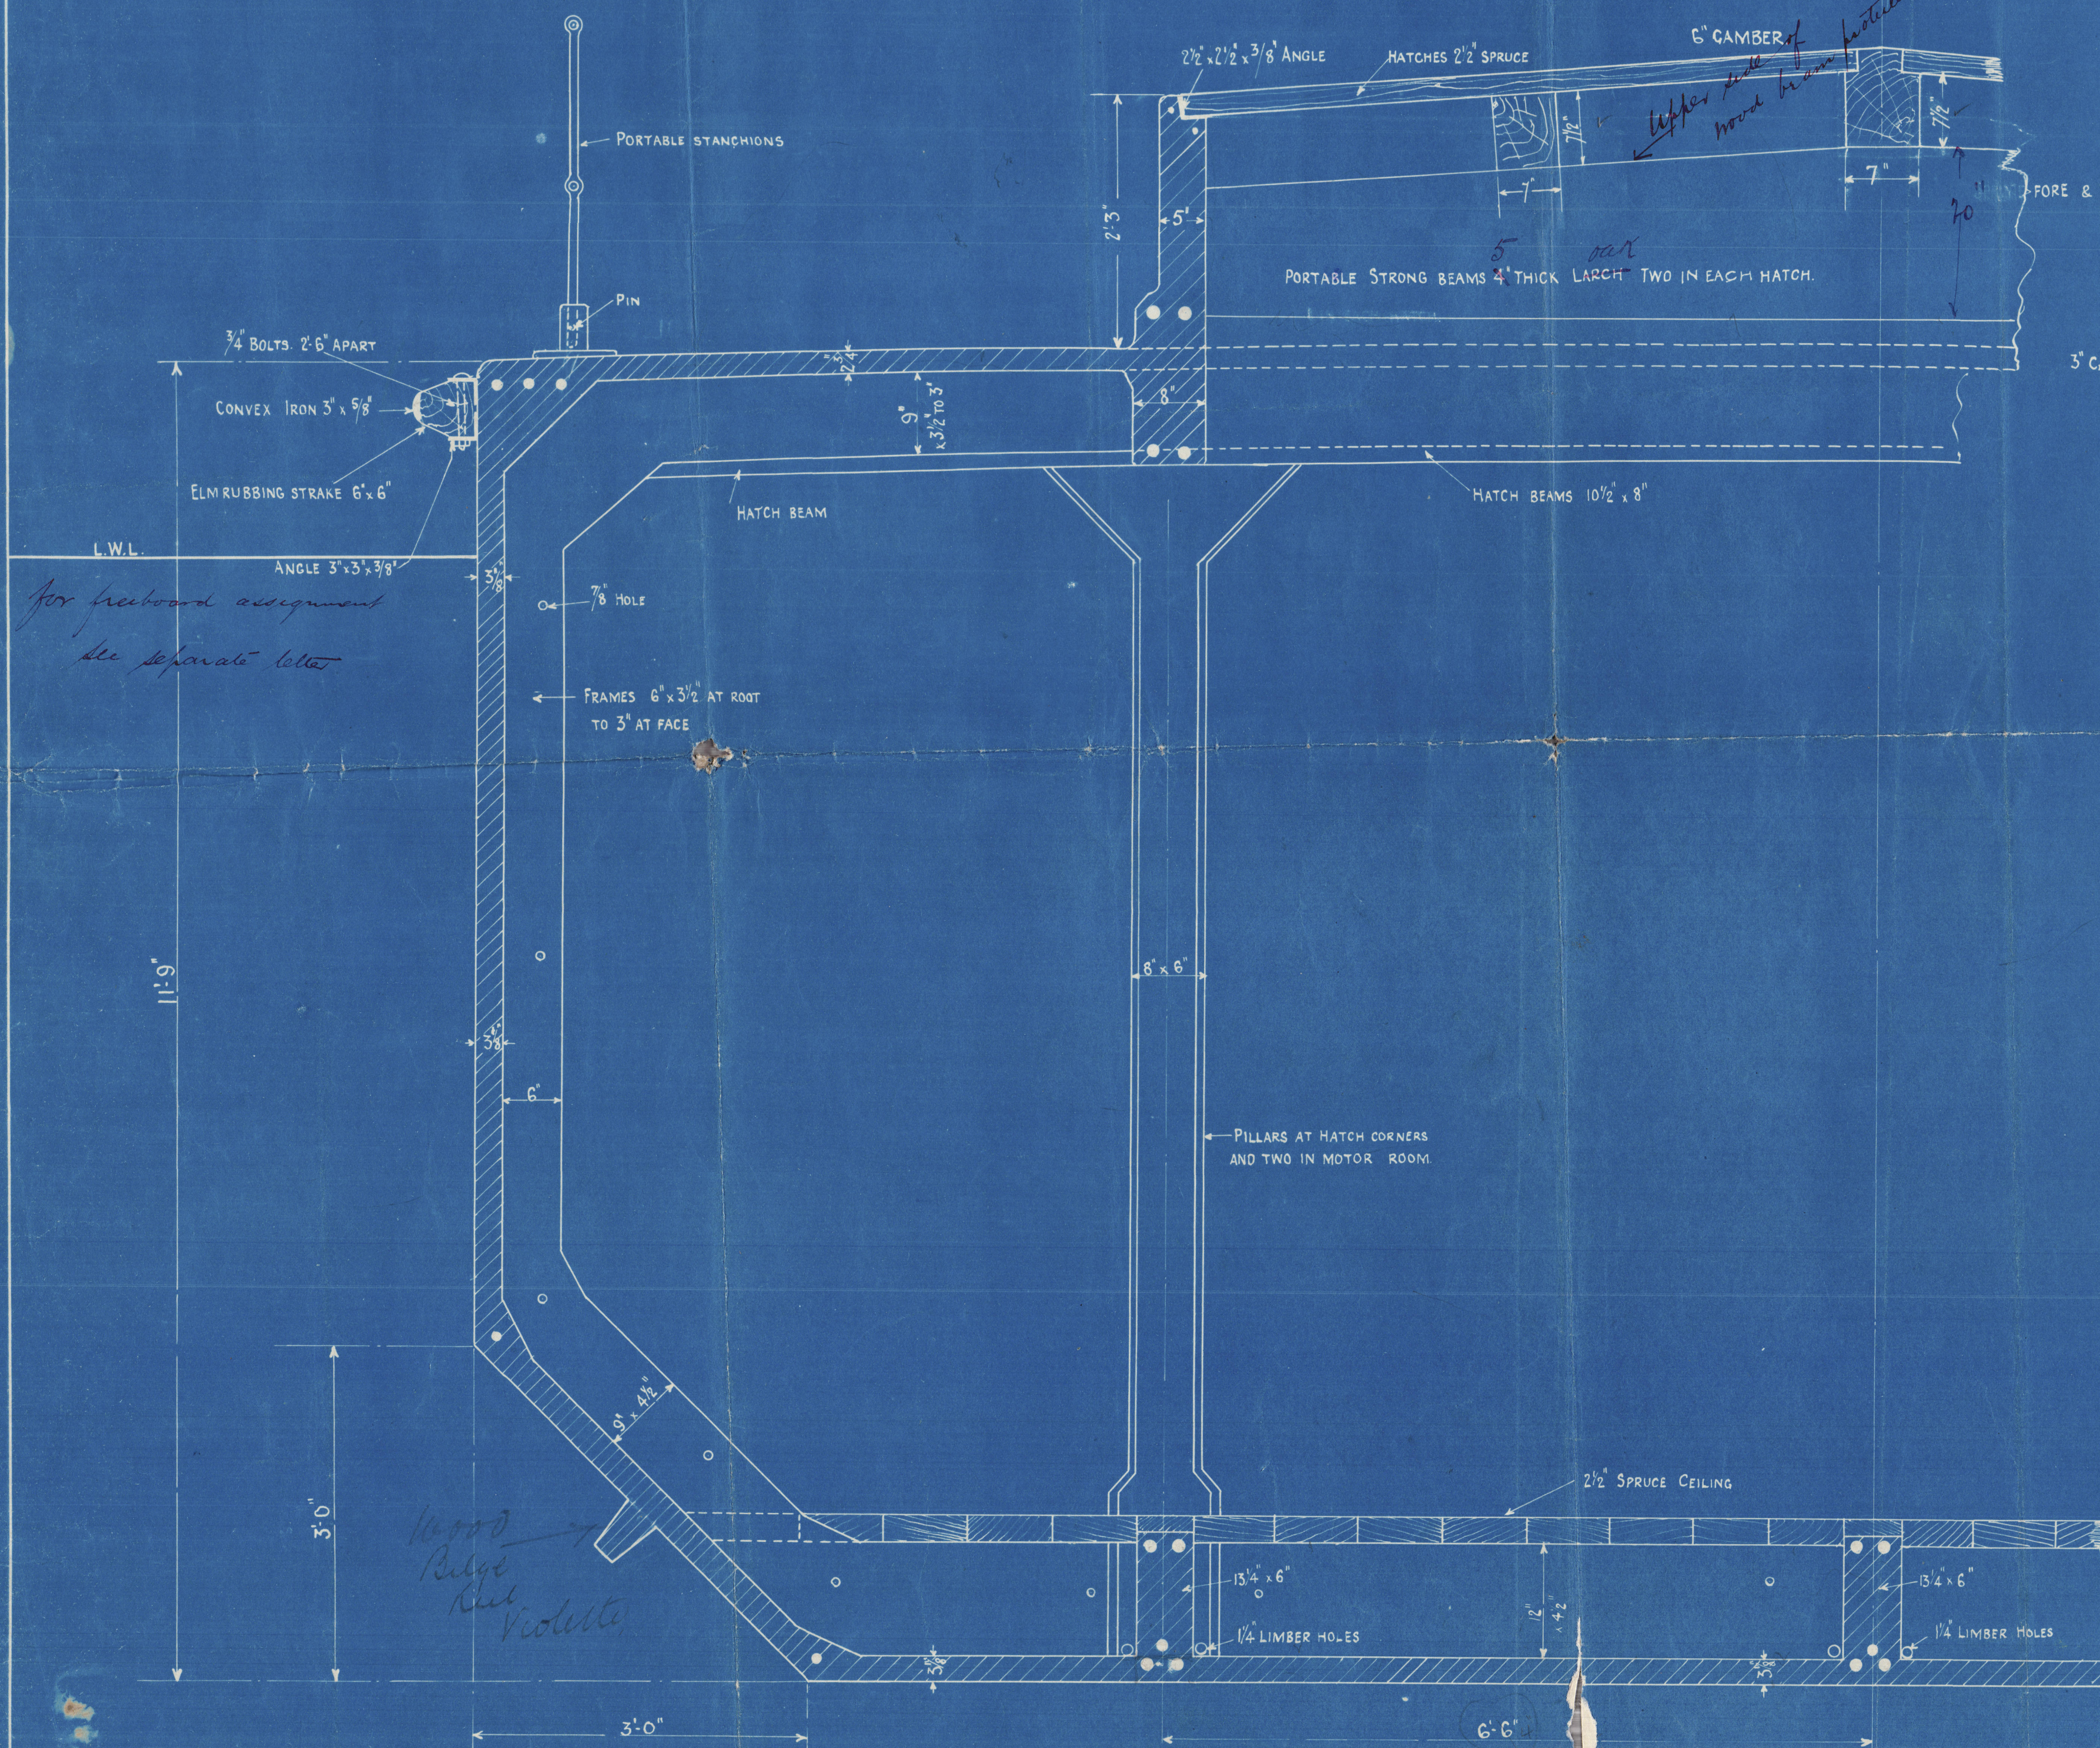

# MIDSHIP SECTION REINFORCED CONCRETE COASTER

125'-0" B.P. x 25'-0" x 11'-9" MLD.

SHIP N° 889

SCALE ~ 1" = 1 FT

120 B.H.P. "M" TYPE ENGINE.

## ANCHORS, CHAINS & WARPS

EQUIPMENT N° 4741

2 BOWER ANCHORS, COLLECTIVE WEIGHTS - STOCKLESS.

1 STREAM ANCHOR. EX. STOCK

1 KEDGE ANCHOR. EX. STOCK

160 FATHOMS 1 1/2" STUD LINK CABLE

45 " 1 1/2" STREAM CHAIN

75 " 6 1/2" HEMP

90 " 4" WARP

14 1/4 CWTs

2 1/4 "

3/4 "

PLAN N° 15723

JAMES POLLOCK SONS & CO., LTD.  
SHIPBUILDERS & ENGINEERS

3 LLOYDS AVENUE  
LONDON, E.C.

Lloyd's Register  
Foundation



Midship Section

Hatchways

(Midship Section)

Auxiliary Schooner  
"Molliette"

Lon Rpt 81543

**RETAIN**



© 2020

Lloyd's Register  
Foundation

W1549-0169