



# GENERAL ARRANGEMENT REINFORCED CONCRETE COASTER

125'-0" B.P. x 25'-0" x 11'-9" MLD.

SHIP N° 889

SCALE ~ 1/4" = 1 FT

120 B.H.P. 'M' TYPE ENGINE.

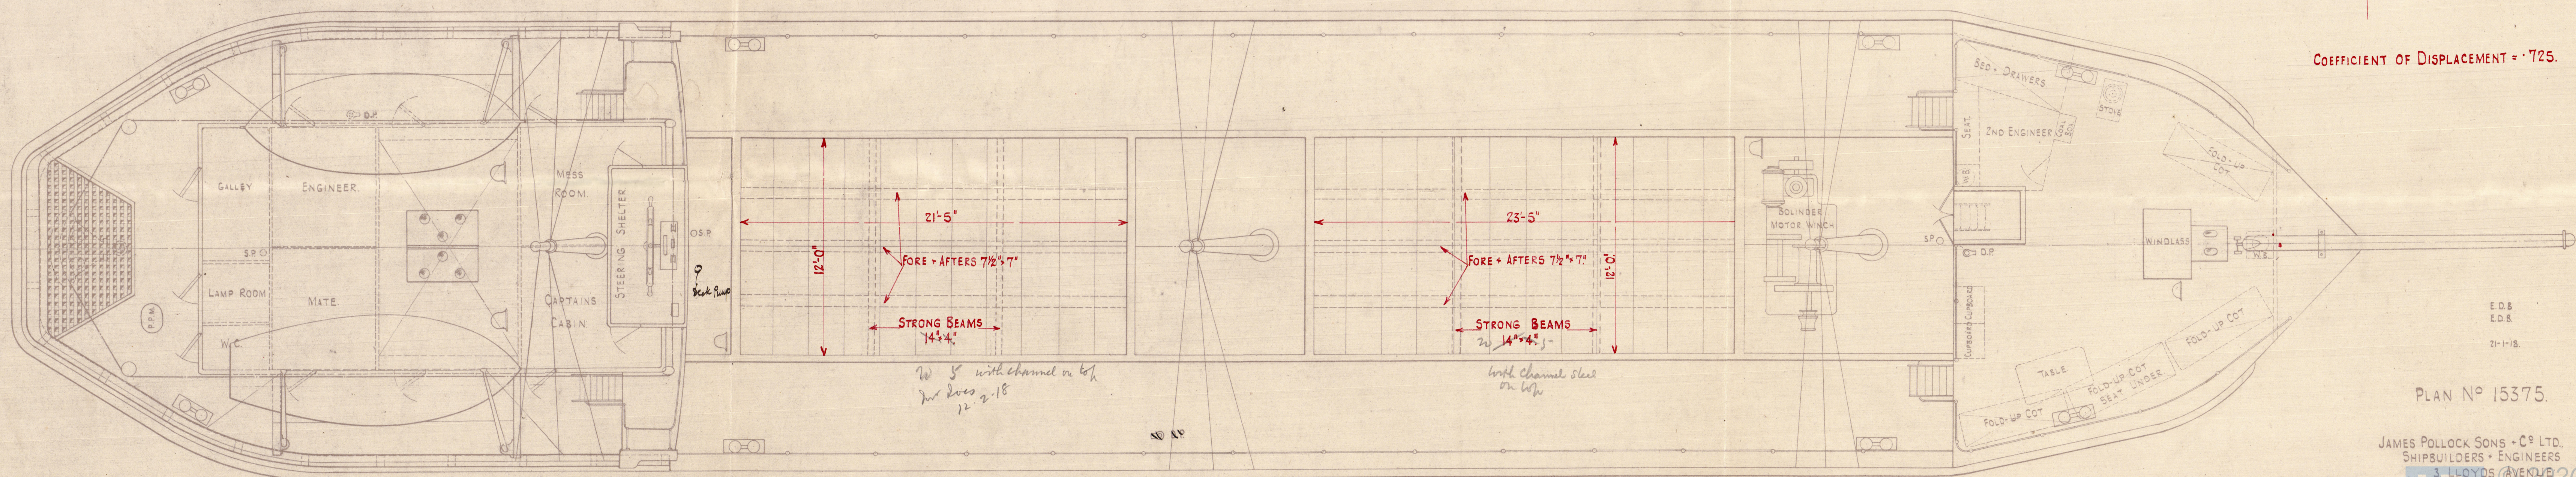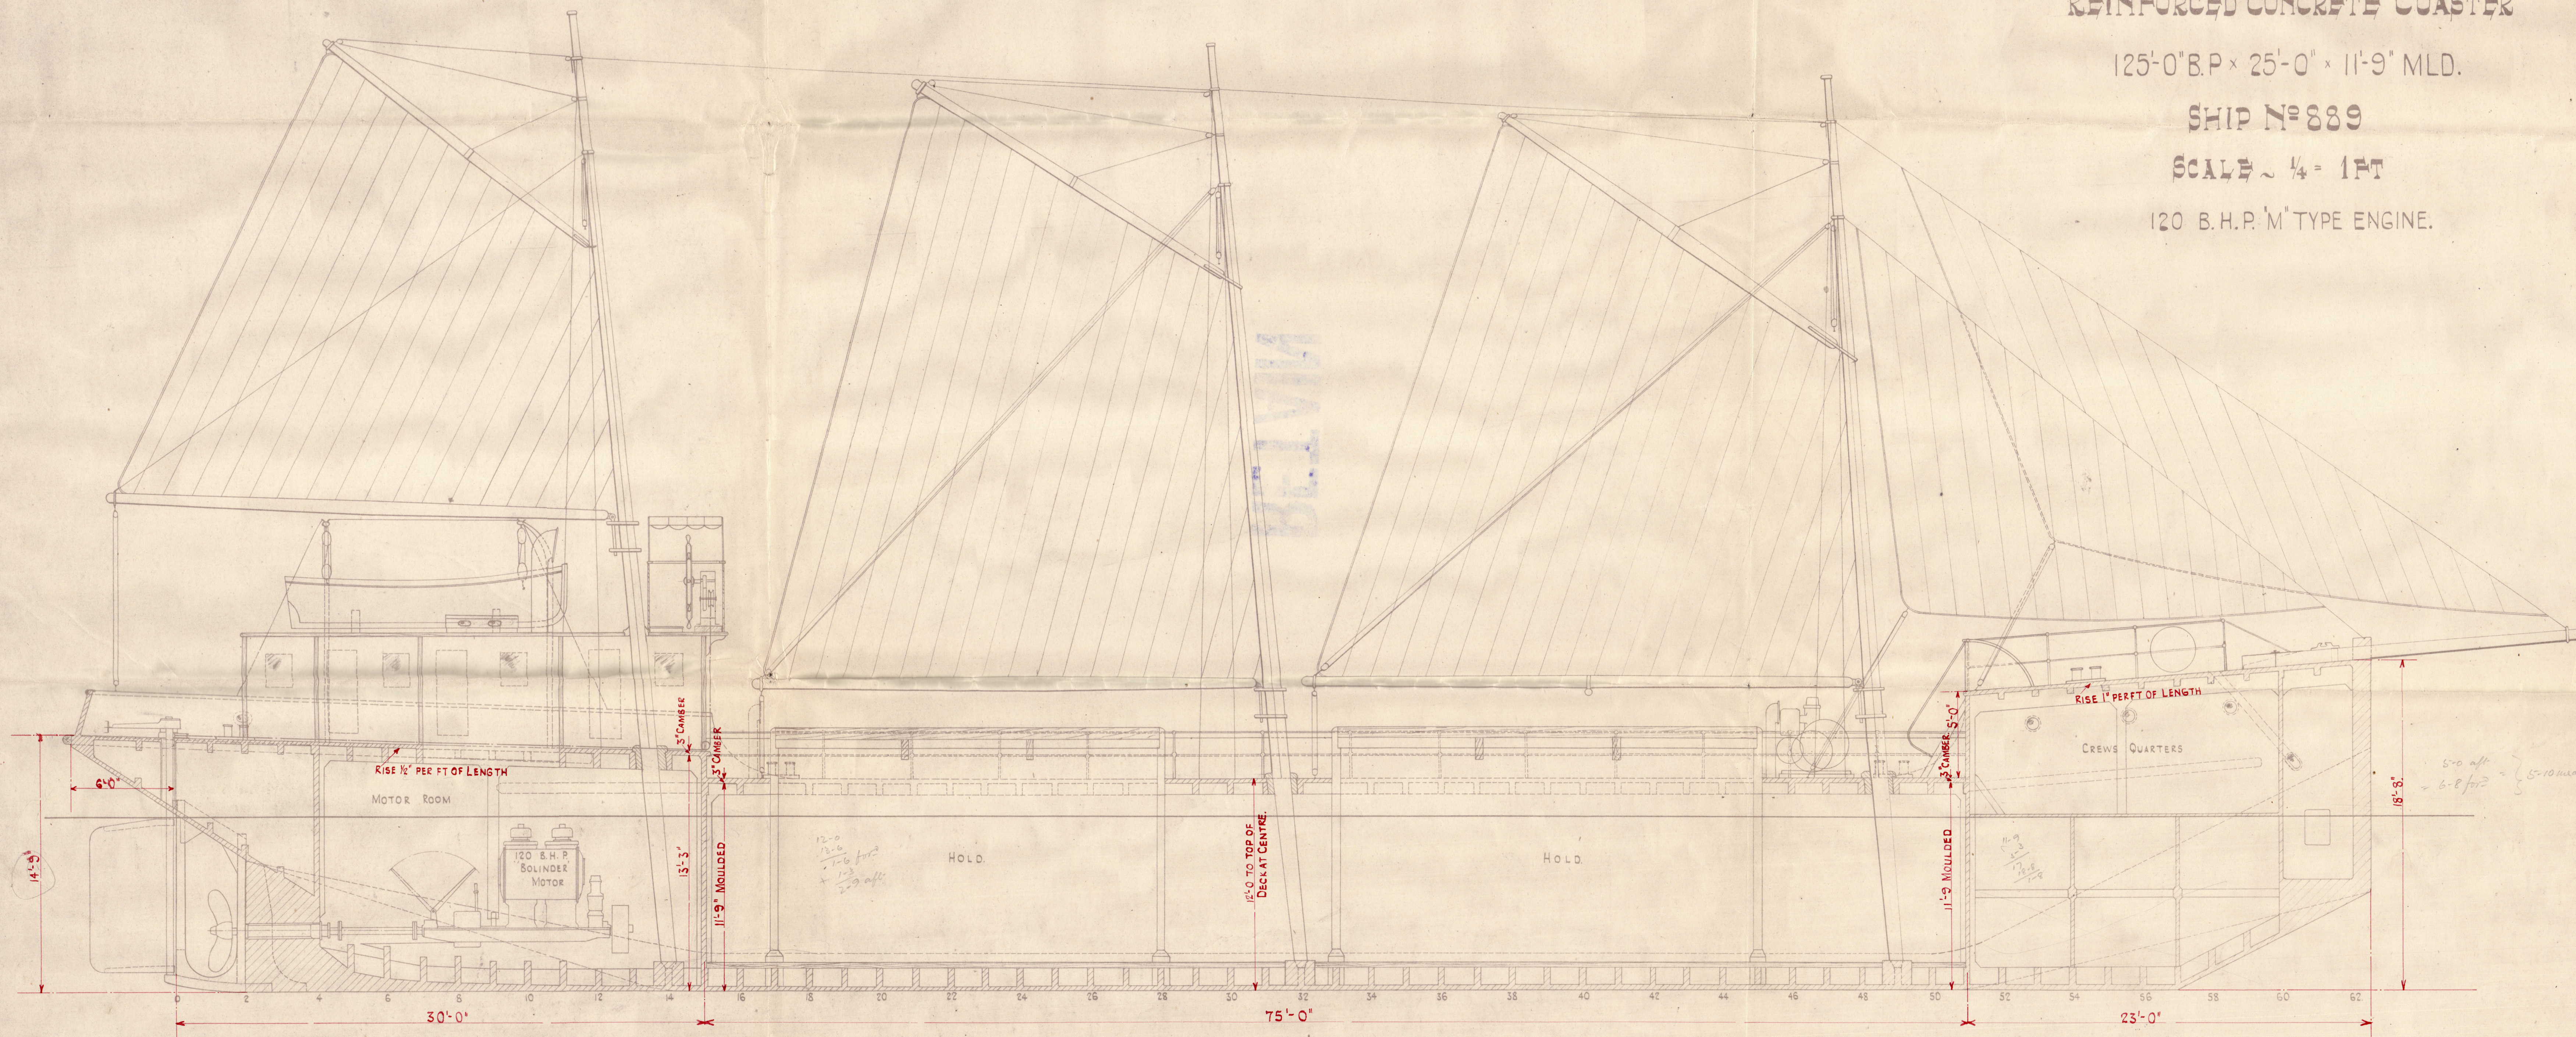

COEFFICIENT OF DISPLACEMENT = .725.

PLAN N° 15375.

JAMES POLLOCK & SONS - C<sup>o</sup> LTD.  
SHIPBUILDERS & ENGINEERS  
3, LLOYD'S AVENUE  
LONDON E.C.3.

Lloyd's Register  
Foundation  
W1549-0111



General Avgst

**RETAIN**



© 2020

Lloyd's Register  
Foundation