

LENGTH ON DECK BETWEEN STEM & STERN 119'-0"
 MOULDED BREADTH 22'-0"
 DEPTH AT SIDE FROM UNDERSIDE OF LINER STRAKE 9'-10"
 ROUND OF BEAM 0'-5 1/2"

DEPTH FROM UPPER PART OF KEEL TO THE TOP OF DECK BEAMS AMIDSHIPS 10'-3 1/2"

GIRTH ROUND THE HALFMIDSHIPS FRAME OF THE MOULDED MIDSHIP SECTION 19'-5 1/2"

1ST NUMBER = 1/2 BREADTH + DEPTH AT MIDDLE LINE + GIRTH OF HALFMIDSHIPS FRAME 40'-9" = 40.75


2ND NUMBER = 1ST NUMBER x LENGTH ON DECK 4849.3" = 4849.25

PROPORTION OF LENGTH TO BREADTH 50.409 = 1

" " " " DEPTH 11.05 = 1

Equipment No. 5175

MIDSHIP SECTION
 OF STEEL CARGO STEAMER.
 LENGTH BP 120'-0" x 22' x 9'10" DEPTH
 TO CLASS 100 A.L.LLOYDS
 SCALE 1/2" x 1'-0"
 NUMBER OF THE YARD 87

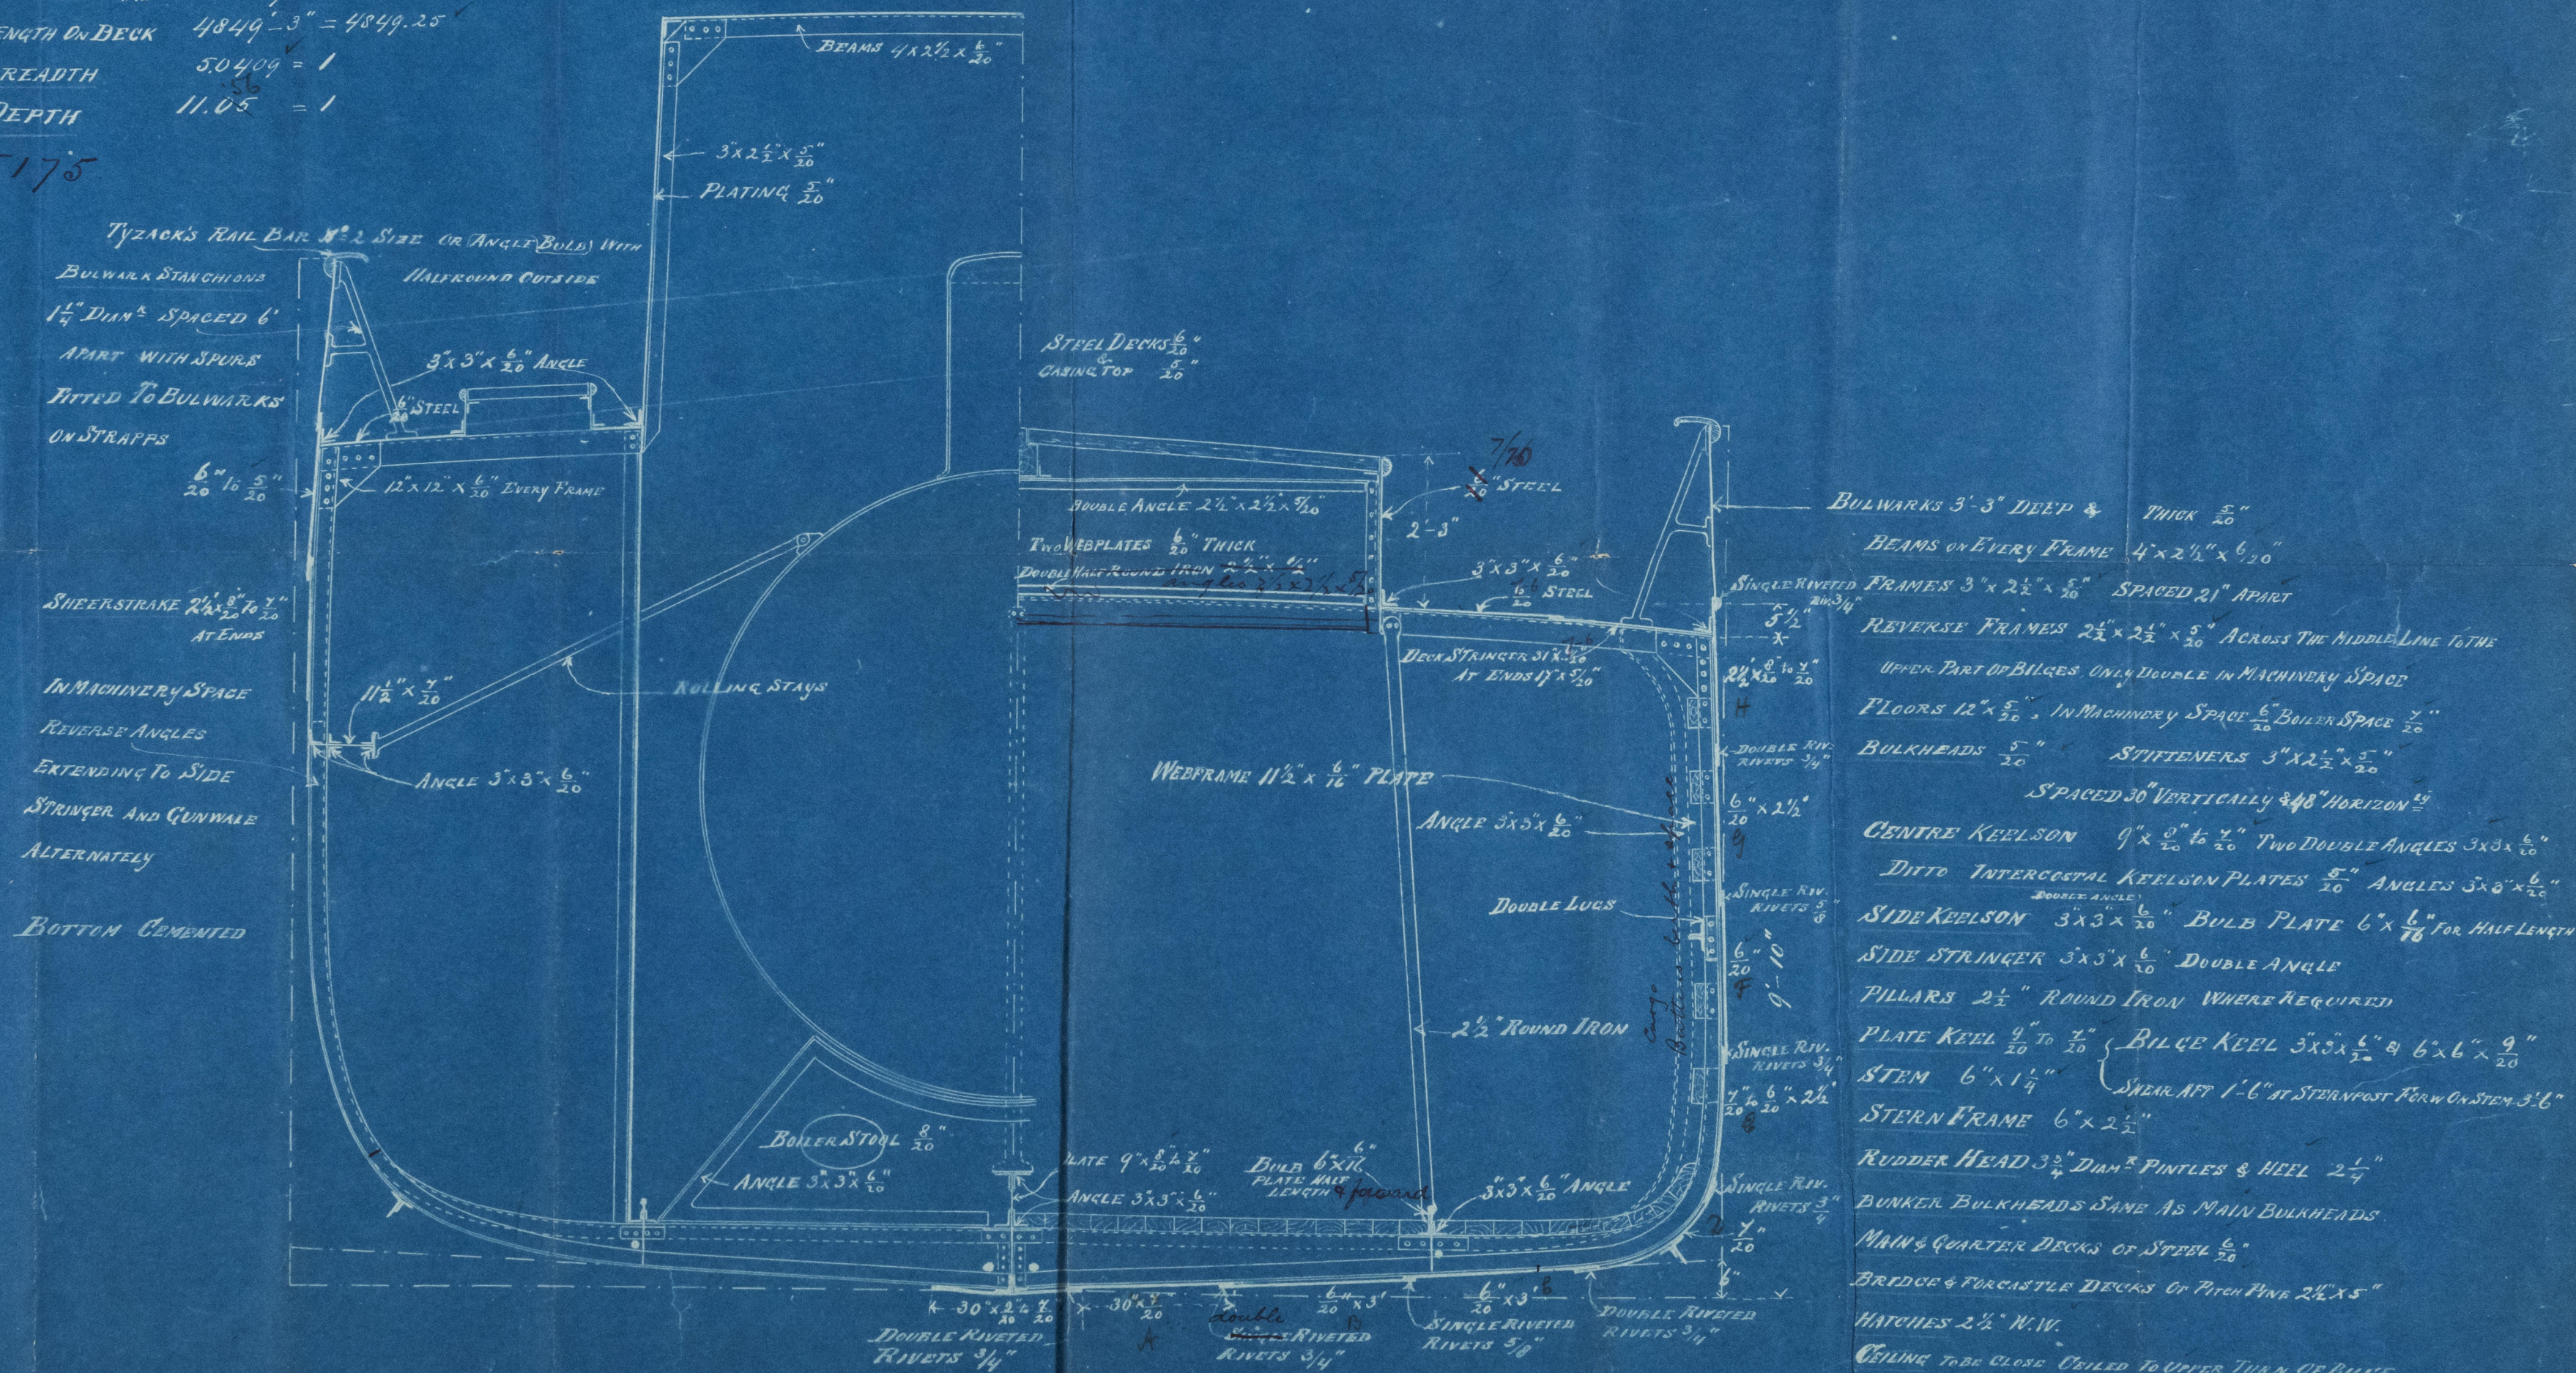

J.H.L.
 21/10/99 19.6.00.

W 1557-0075

Botje, Eusing vbo. 87

Amst. N^o. 2357


M/S



© 2021

Lloyd's Register
Foundation

W1557-0075

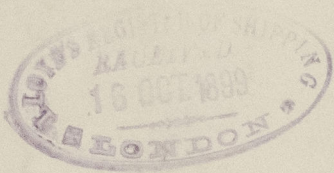

© 2021

Lloyd's Register
Foundation