

W. H. 12

Swamp P. 1000
Ed. 100

Swamp P. 1000
Ed. 100

PROFILE & DECK PLAN



N^o 563.

DIMS 110'-0" x 21'-0" EXT x 11'-0" MID

SCALE 1/4" = ONE FOOT

COCHRANE & SONS
IRON AND STEEL
7/11/12
SHIPBUILDERS
SELBY

RETAIN

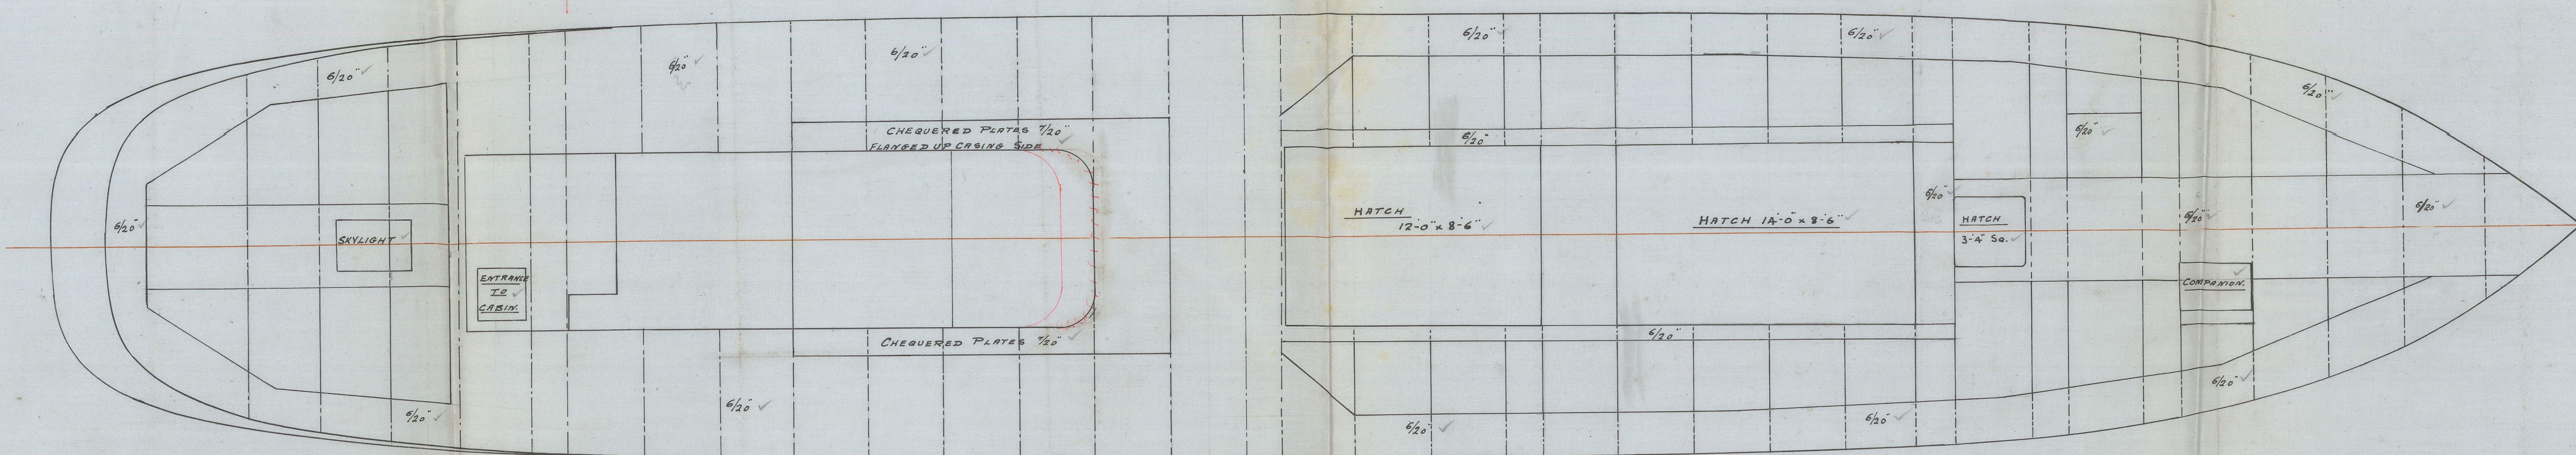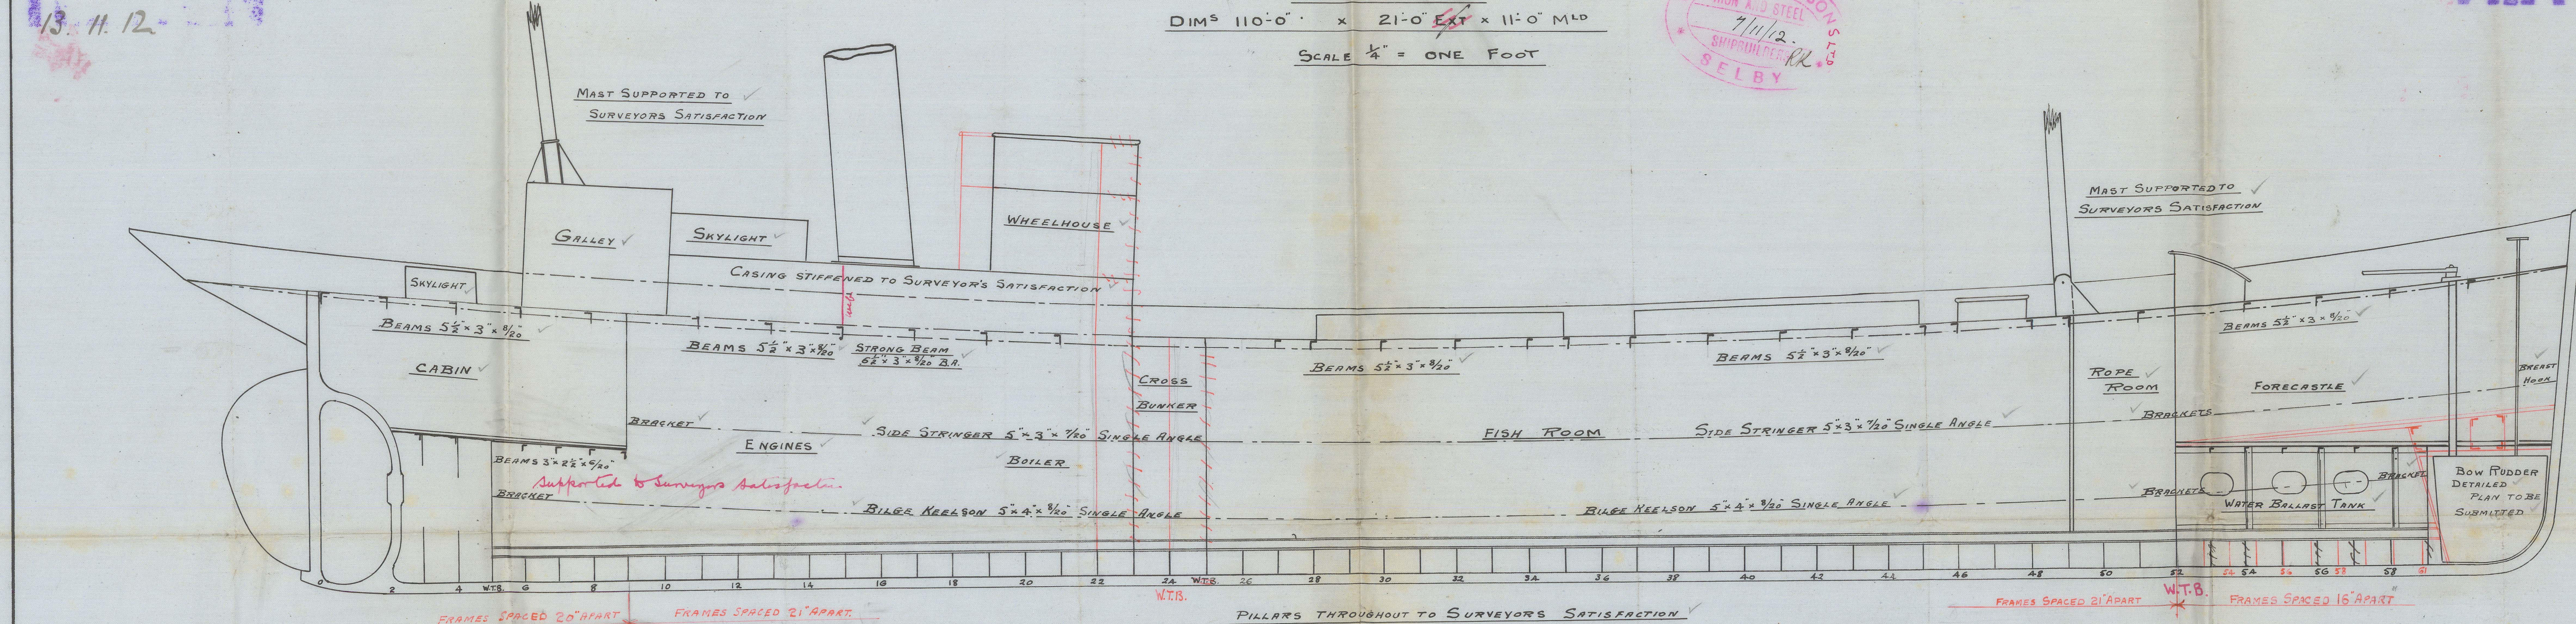


18.11.12.

Cochrane & Sons'
No. 563

Profile & Section
of R. R. S.

Hull Rpt No: 26364

RETAIN

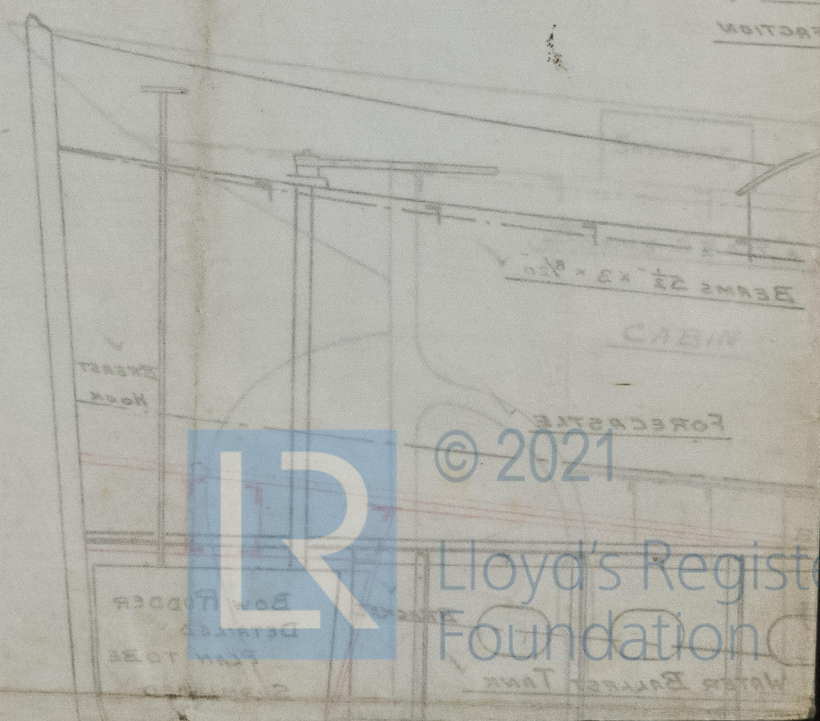

W1565-0027



© 2021

Lloyd's Register
Foundation