


20-1-03

# Cargo-boat B<sup>3</sup>

Go class 100 A 1 Threedeck, incl. Shelterdeck

Midship Section - Scale 1/2 in. per foot

Actual - Scantlings

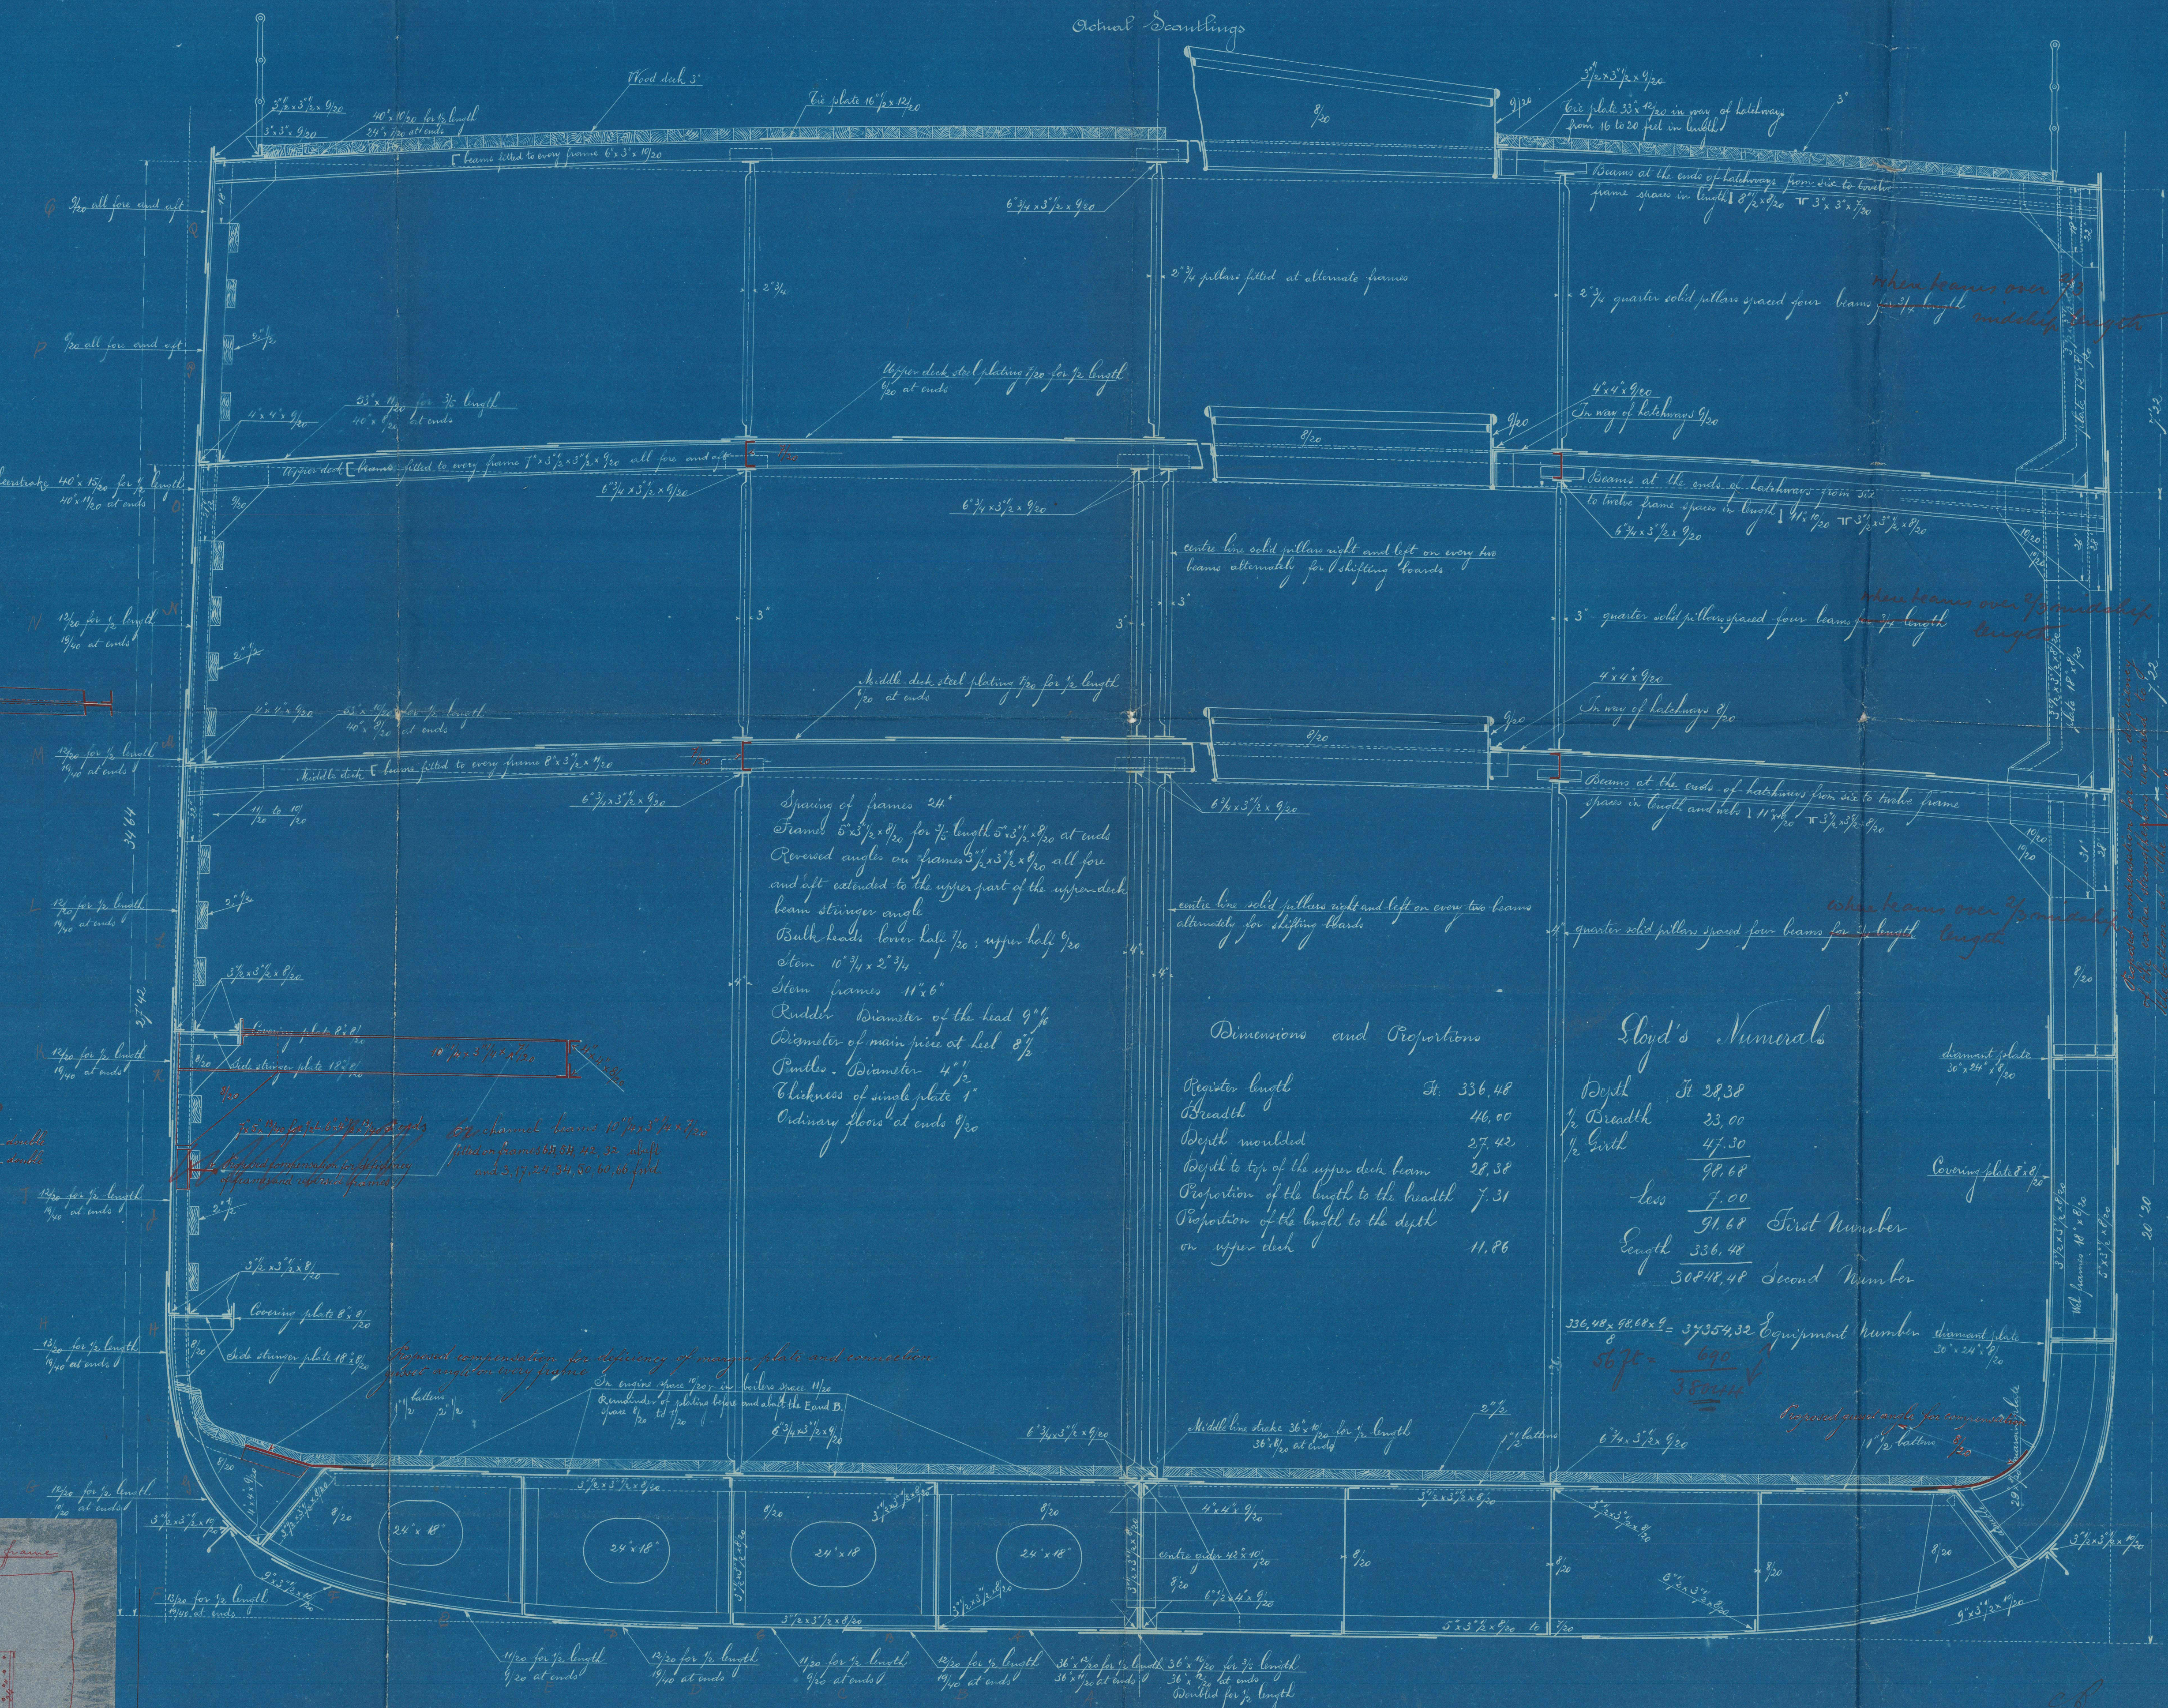


## Dimensions and Proportions

Register length	ft. 336.48
Breadth	46.00
Depth moulded	27.42
Depth to top of the upper deck beam	28.38
Proportion of the length to the breadth	7.31
Proportion of the breadth to the depth on upper deck	11.86

## Lloyd's Numerals

Depth	ft. 28.38
1/2 Breadth	23.00
1/2 Length	168.24
Less	7.00
Length	336.48
336.48 x 168.24 x 23.00 = 37354.32	Equipment Number

37354.32

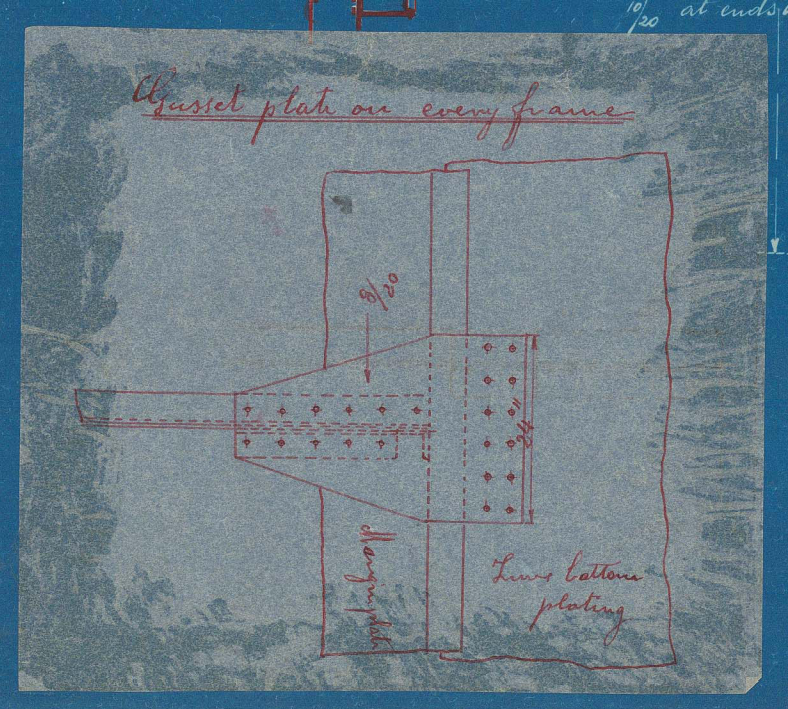

Double frames in trans frames of 3/4 in. per inch



B 31  
Leone Maestre

"Sicania"  
Lgn 175<sup>a</sup>

W1585-0025

RETAIN

M/S



© 2020

Lloyd's Register  
Foundation