

Enquiry No 1615 *L.P. No 786*
 Shelter Deck Cargo Steamer

N. 793 appd. 2/10/06
N. 794 appd. 10/11/06
N. 795 appd. 7/12/06
N. 796 appd. 27/12/06


Principal Dimensions
 Length Overall 412'-0"
 Length between perps 400'-0"
 Breadth extreme 52'-0"
 Depth moulded to Upper Deck 29'-9"
 Scale 1/16" = 1 Foot.

N. 798 + 799
 Appd. 4/5/07

Class + 100 A.1 Lloyds 3 Decks with Shelter Decks

Note:- Arrangement of Pillars & Details of Hatches and Brackets under Lower Decks in way of Boilers to be same as in No. 779 Ship.

7.5.06
2.5.06
19.5.06
30.7.06
9.8.06
2.10.06
26.11.06
7.12.06
27.12.06
4.5.07
27.11.08
16.3.11
17.4.11

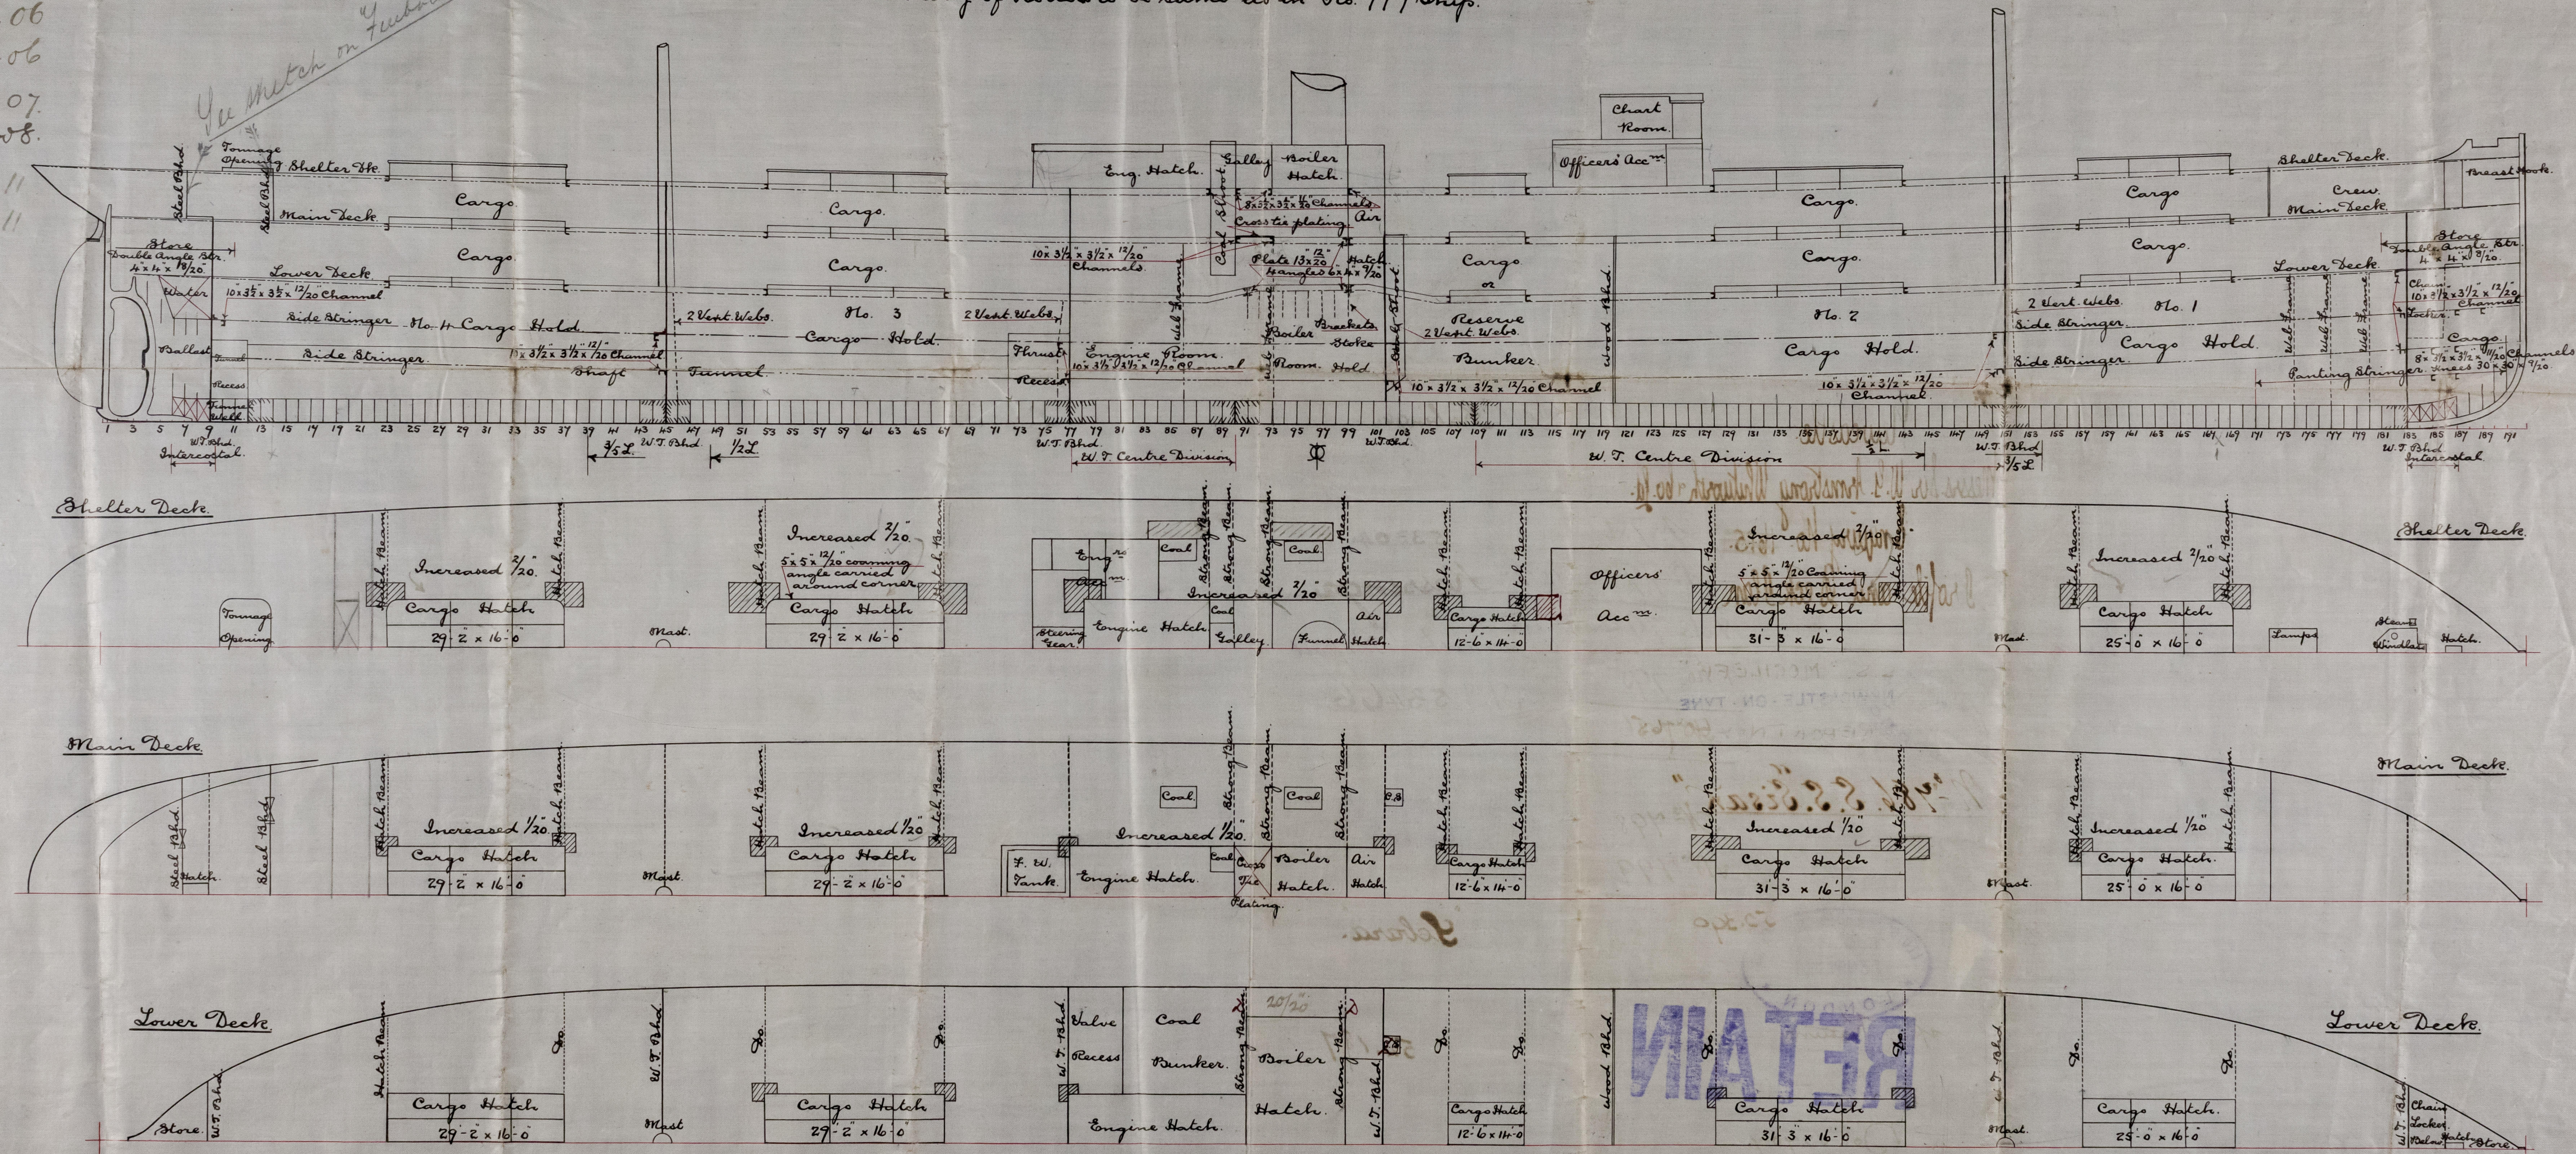

Newcastle.

Messrs Sir W. G. Armstrong Whitworth & Co. Ltd.

Enquiry No. 1615.

Profile and Deck Plan.

S.S. "MOGILEFF"

NEWCASTLE-ON-TYNE


REPORT No. 795

N^o 486 S.S. "Sisak"

N^o 798

N^o 799

52.390

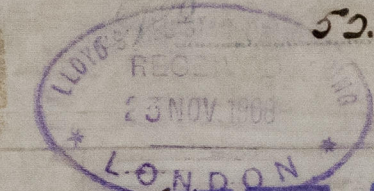

sp. Katuna
RETAIN

No 52407.

"Karnja"-794 nucle 53043.

S.S. Sebara. no. 798

S.S. Kabinga

53304

S.S. Kassenga

Newcastle Post

N^o 53466

S.S. "Sebara"

54.187

W1587-0190



© 2020

Lloyd's Register
Foundation