
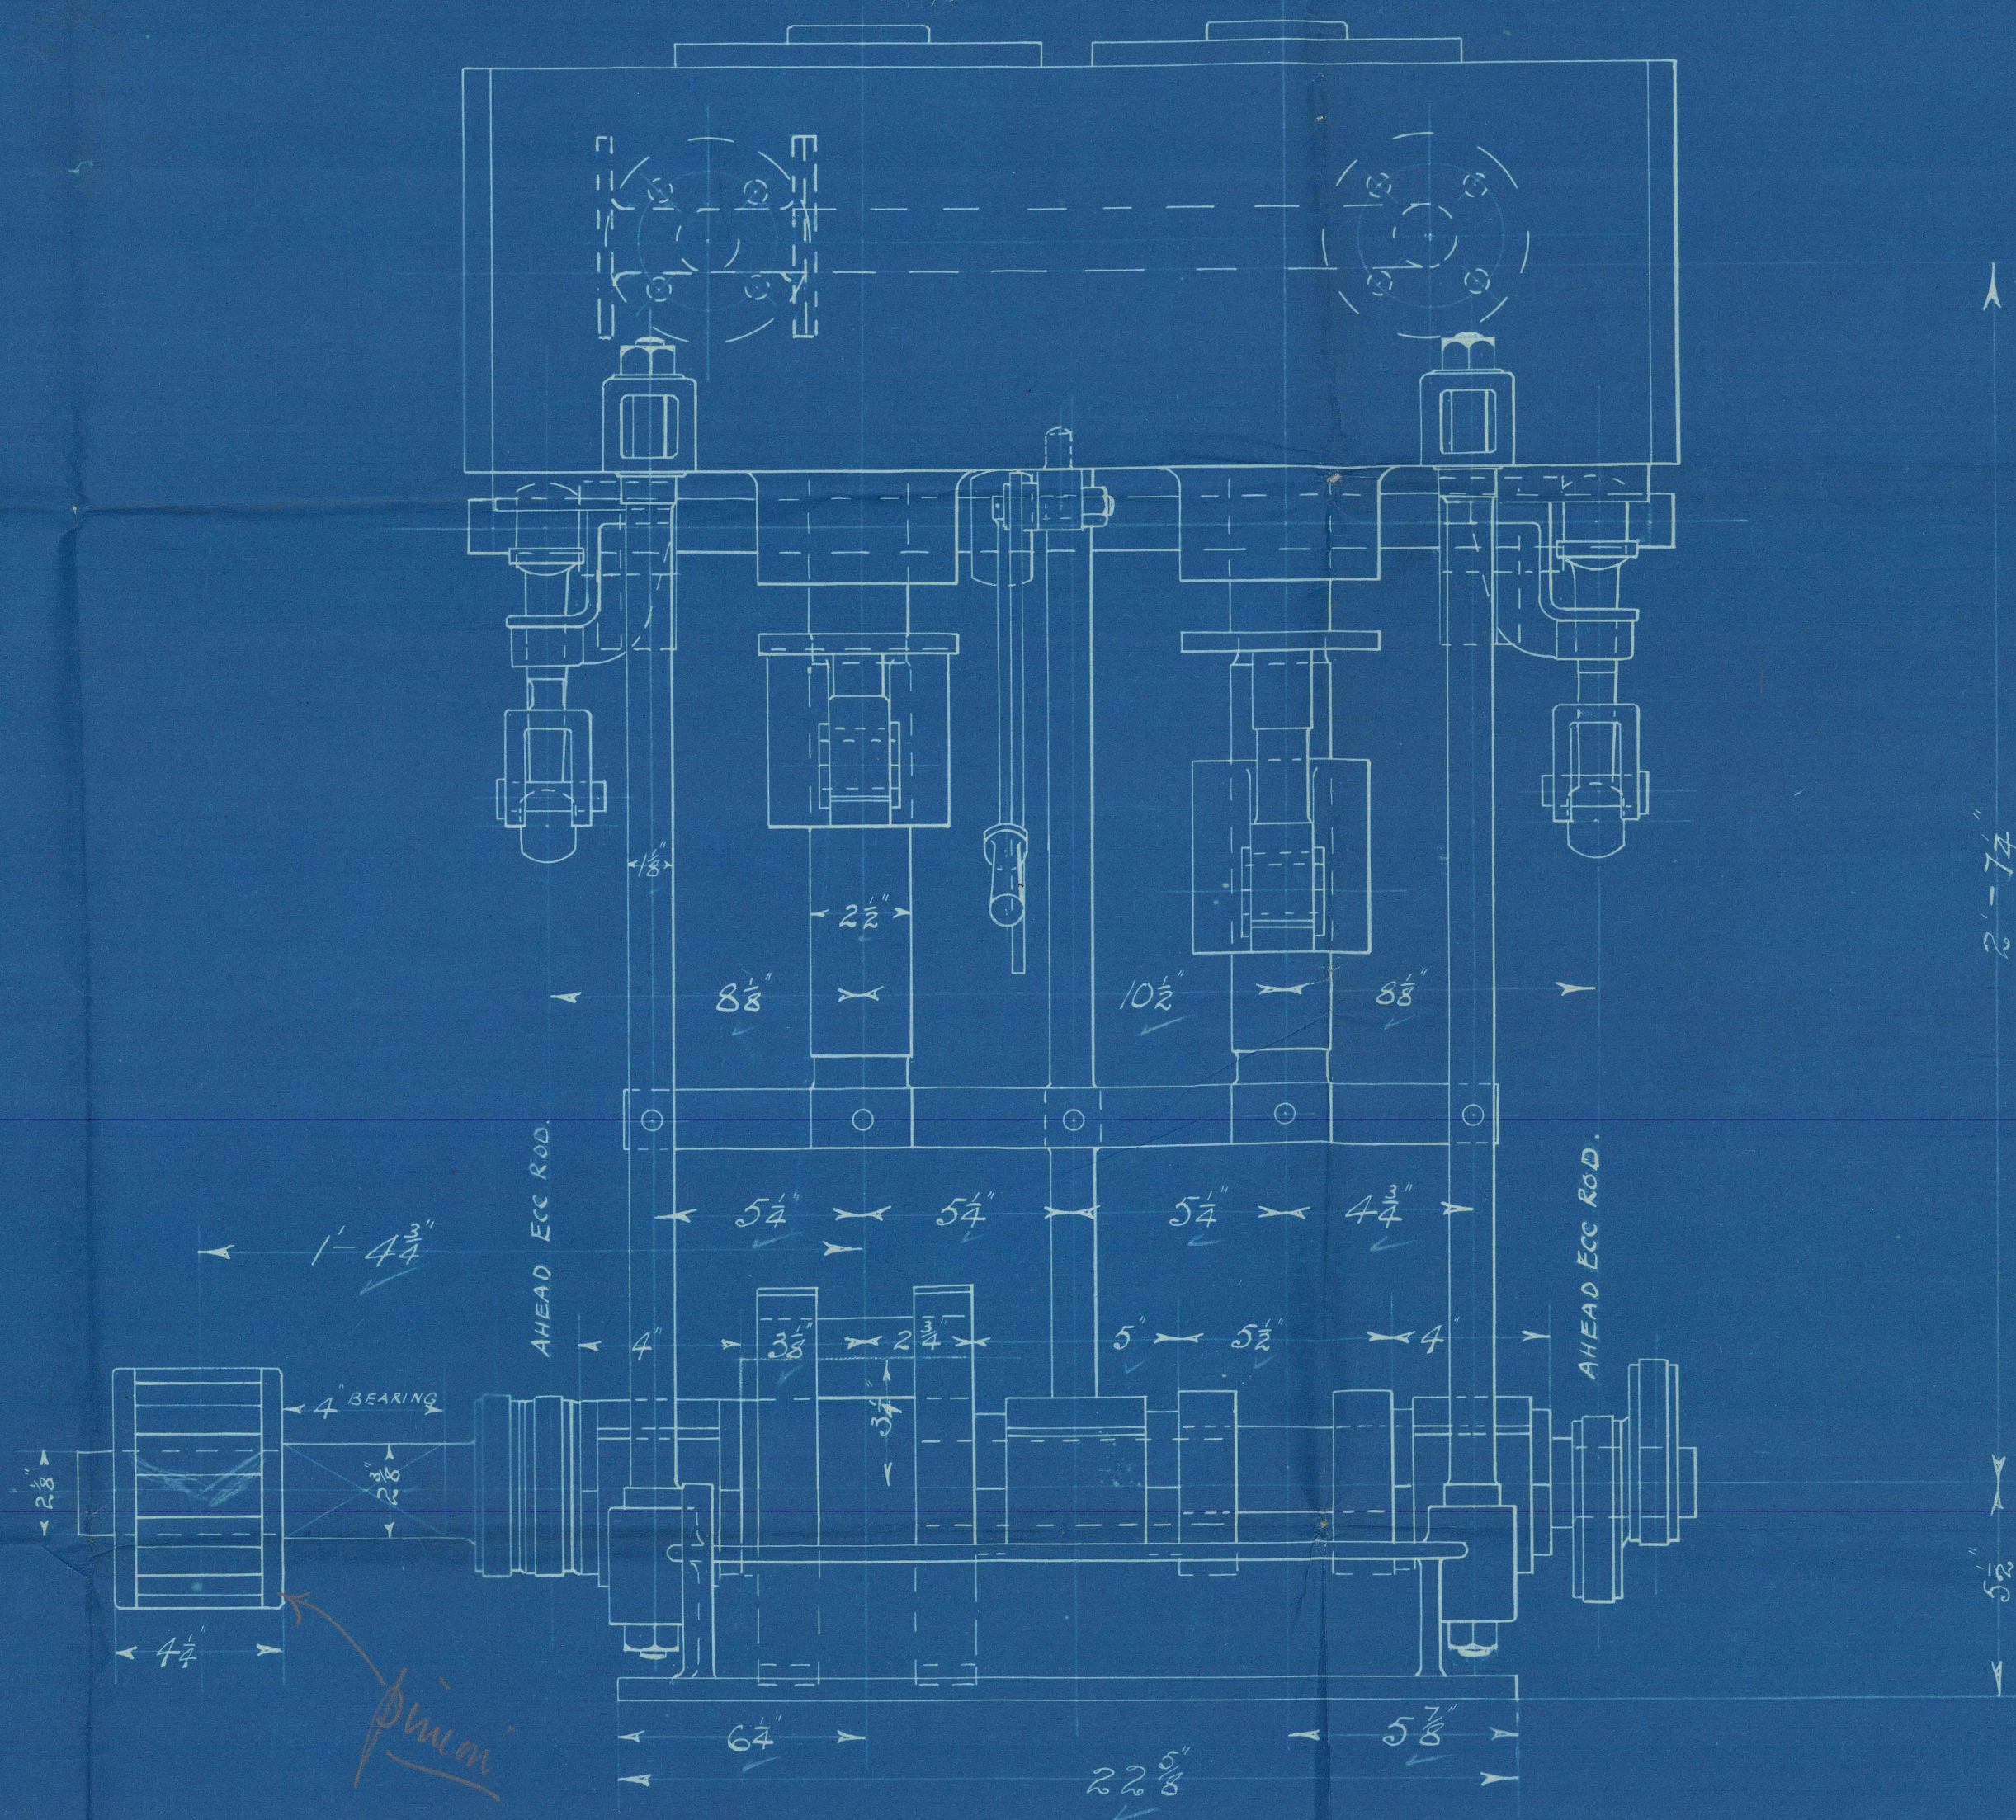


JOB. N^o 919. 1-SET OFF.

2/2/14

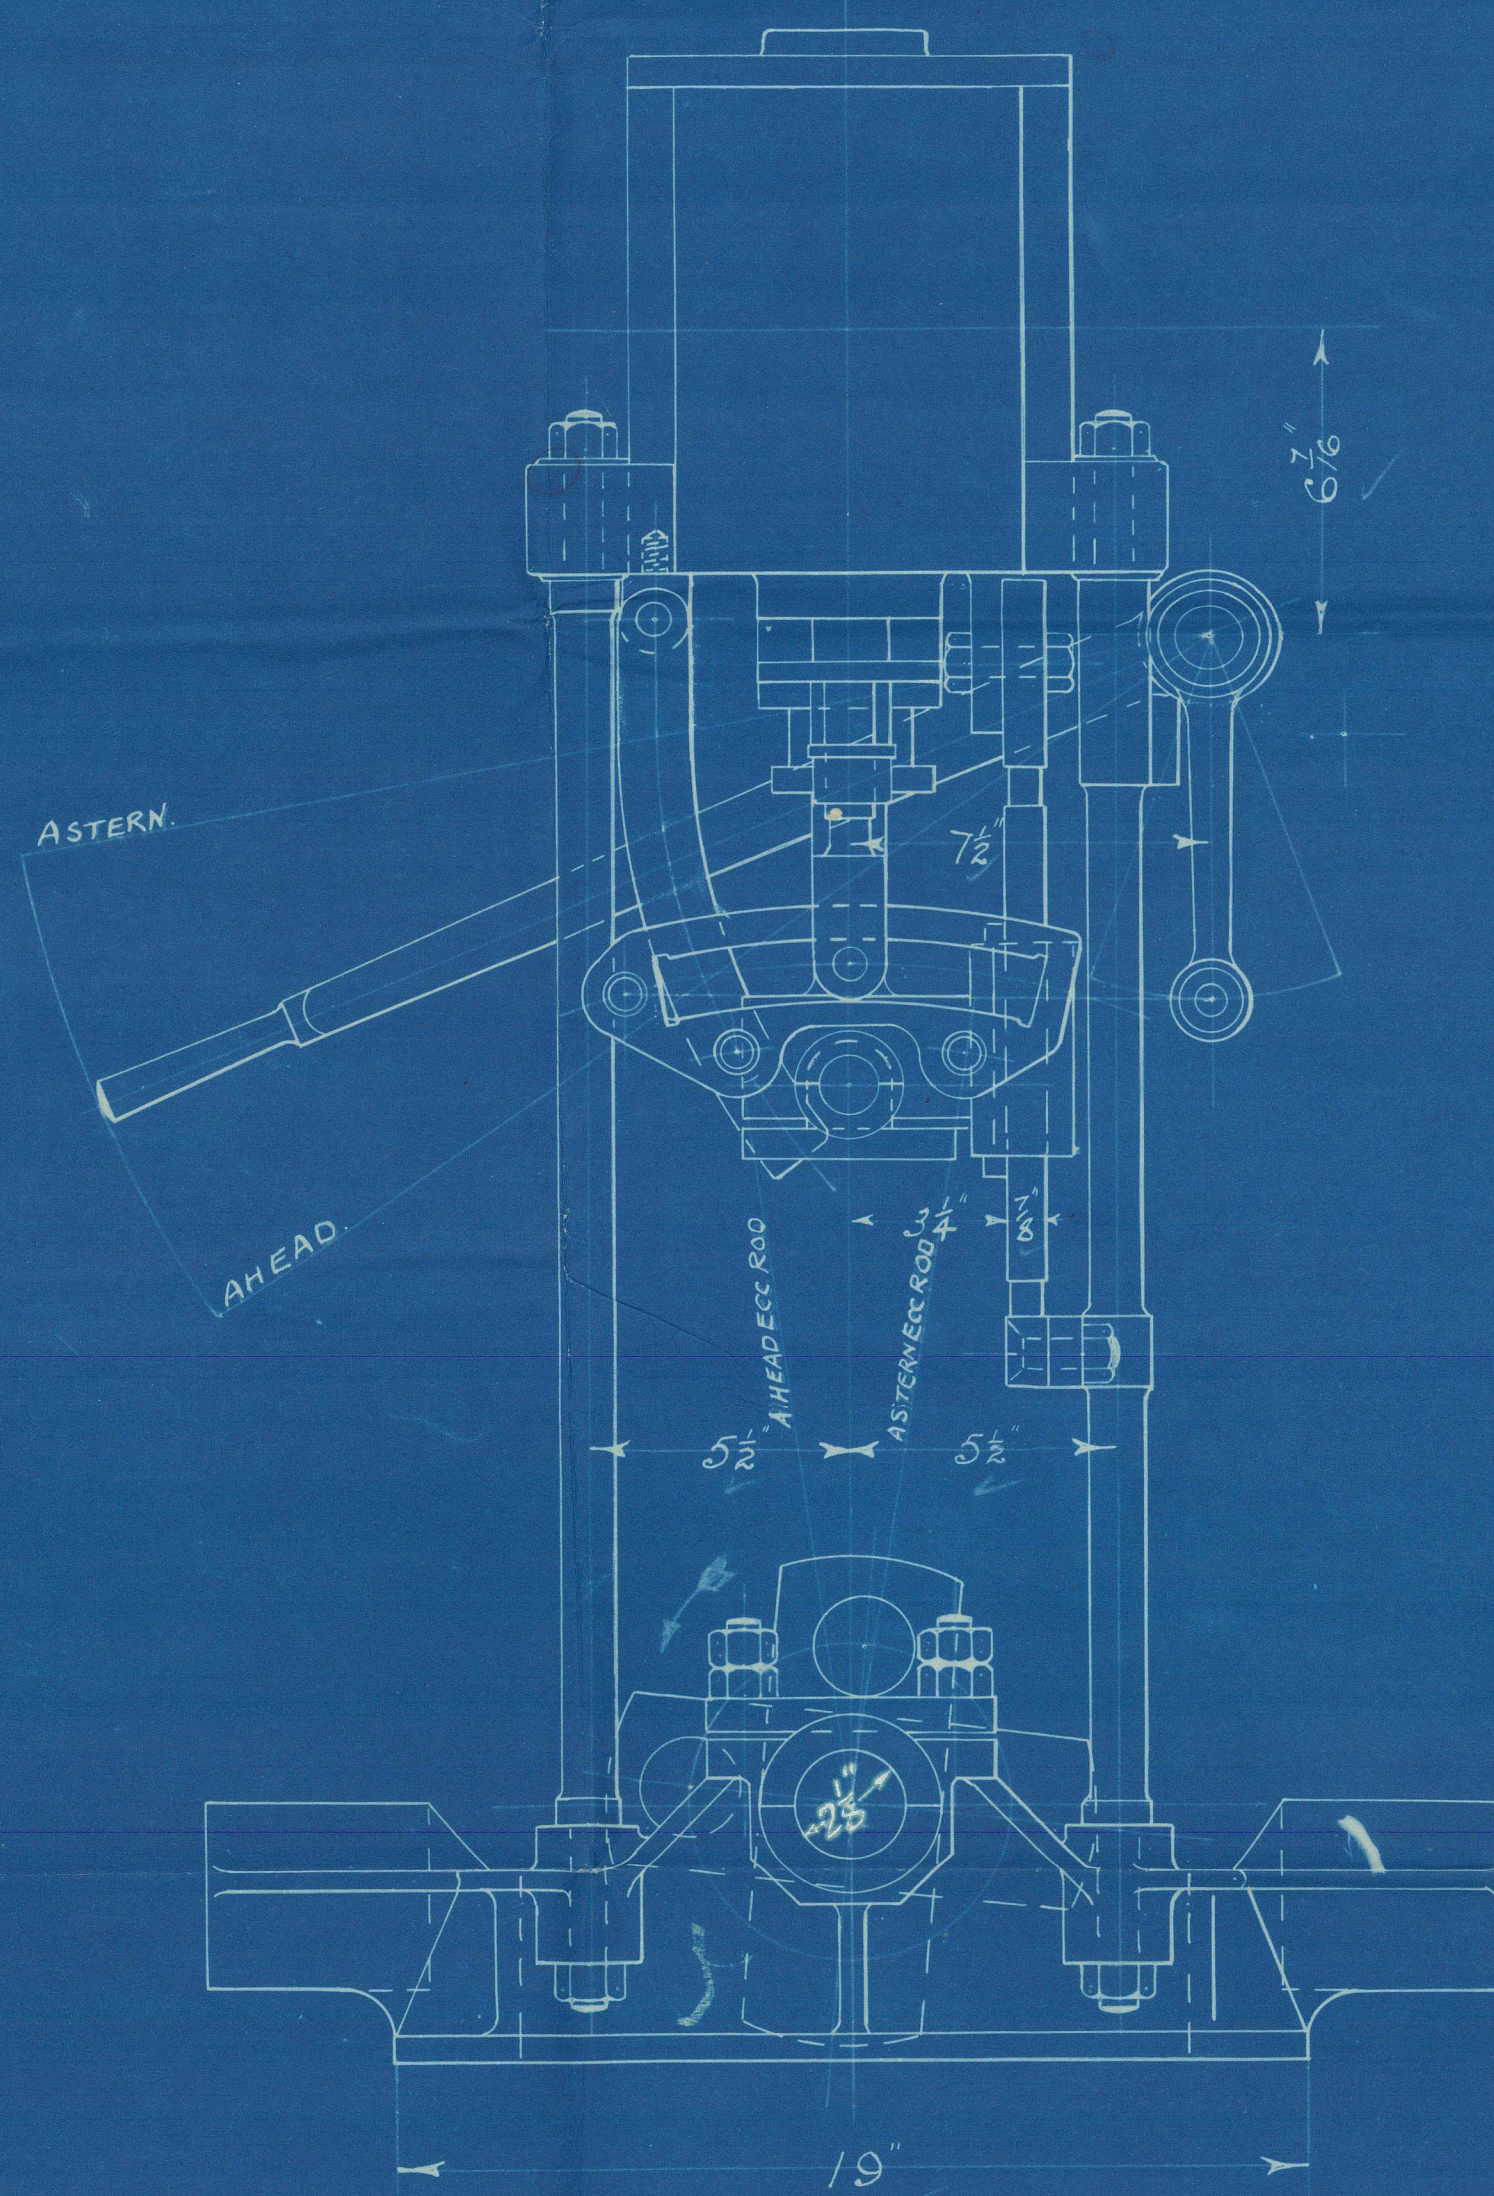

CAMPBELL & CALDERWOOD,
ENGINEERS & BOILERMAKERS,
PAISLEY.

GENERAL ARRANGEMENT.


OF

TWIN CYLINDER ENGINE $\frac{6 \times 6}{6 \frac{1}{2}}$ FOR 100 LBS. WP.

SCALE 3" INCH = 1' FOOT.

18/2/14. R.B.

J.P.R.
20.2.14

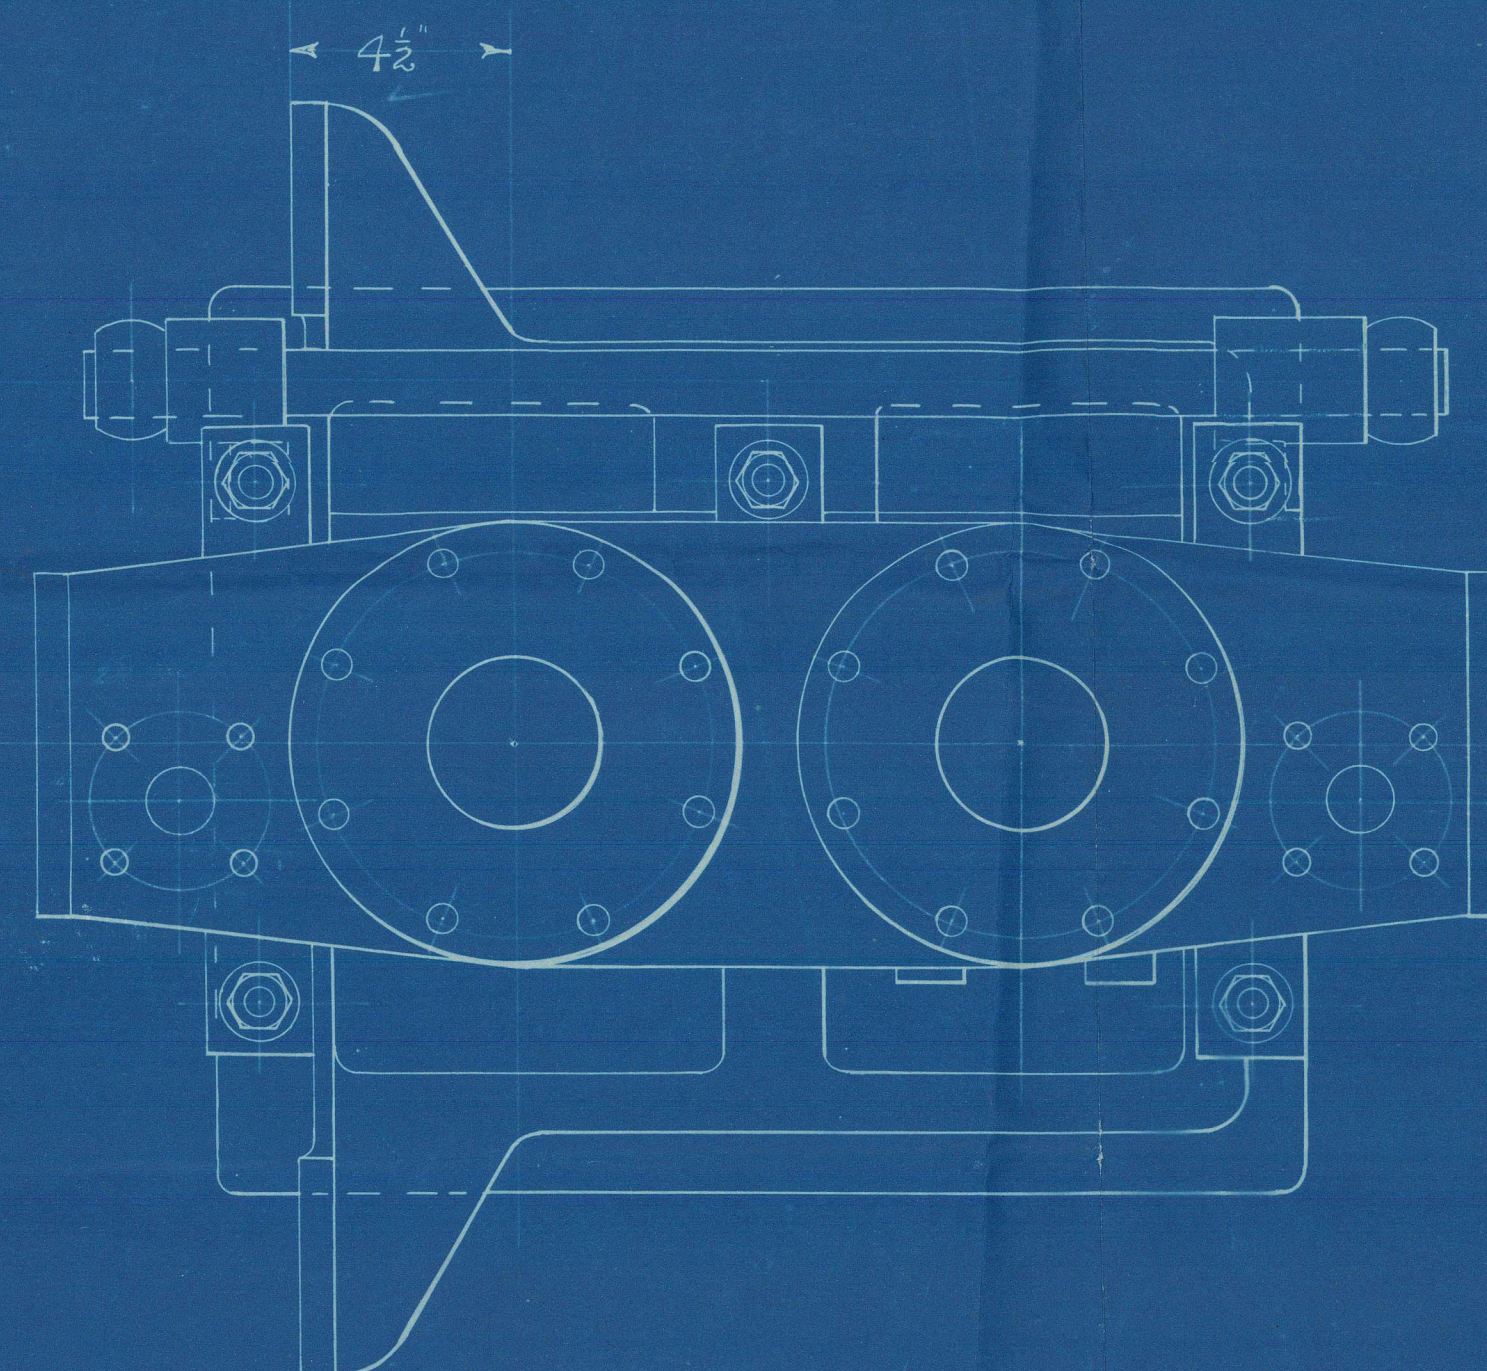

DRAWN BY J.P.R.
TRACED BY J.P.R.
CHECKED BY J.P.R.

IR

Lloyd's Register
Foundation


Glasgow
Small engines by Campbell
& Calderwood, Paisley
for Ferry

to be built by Alley &

MacLellan - 527

"Windermere Ferry"

GLASGOW REPORT No. 33960

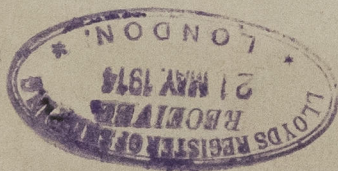

RETAIN

W1624-0116

© 2021



Lloyd's Register
Foundation