


5.2.14
16.9.14

— STEEL WORK ARRANGEMENT. —

— STEAM FERRY —

DIMENSIONS. LEN B.P.s. 56'0" 18'0" 2'7" MOULDED.

To CLASS "A" AT LLOYD'S FOR FERRY PURPOSES ONLY ON LAKE WINDERMERE.

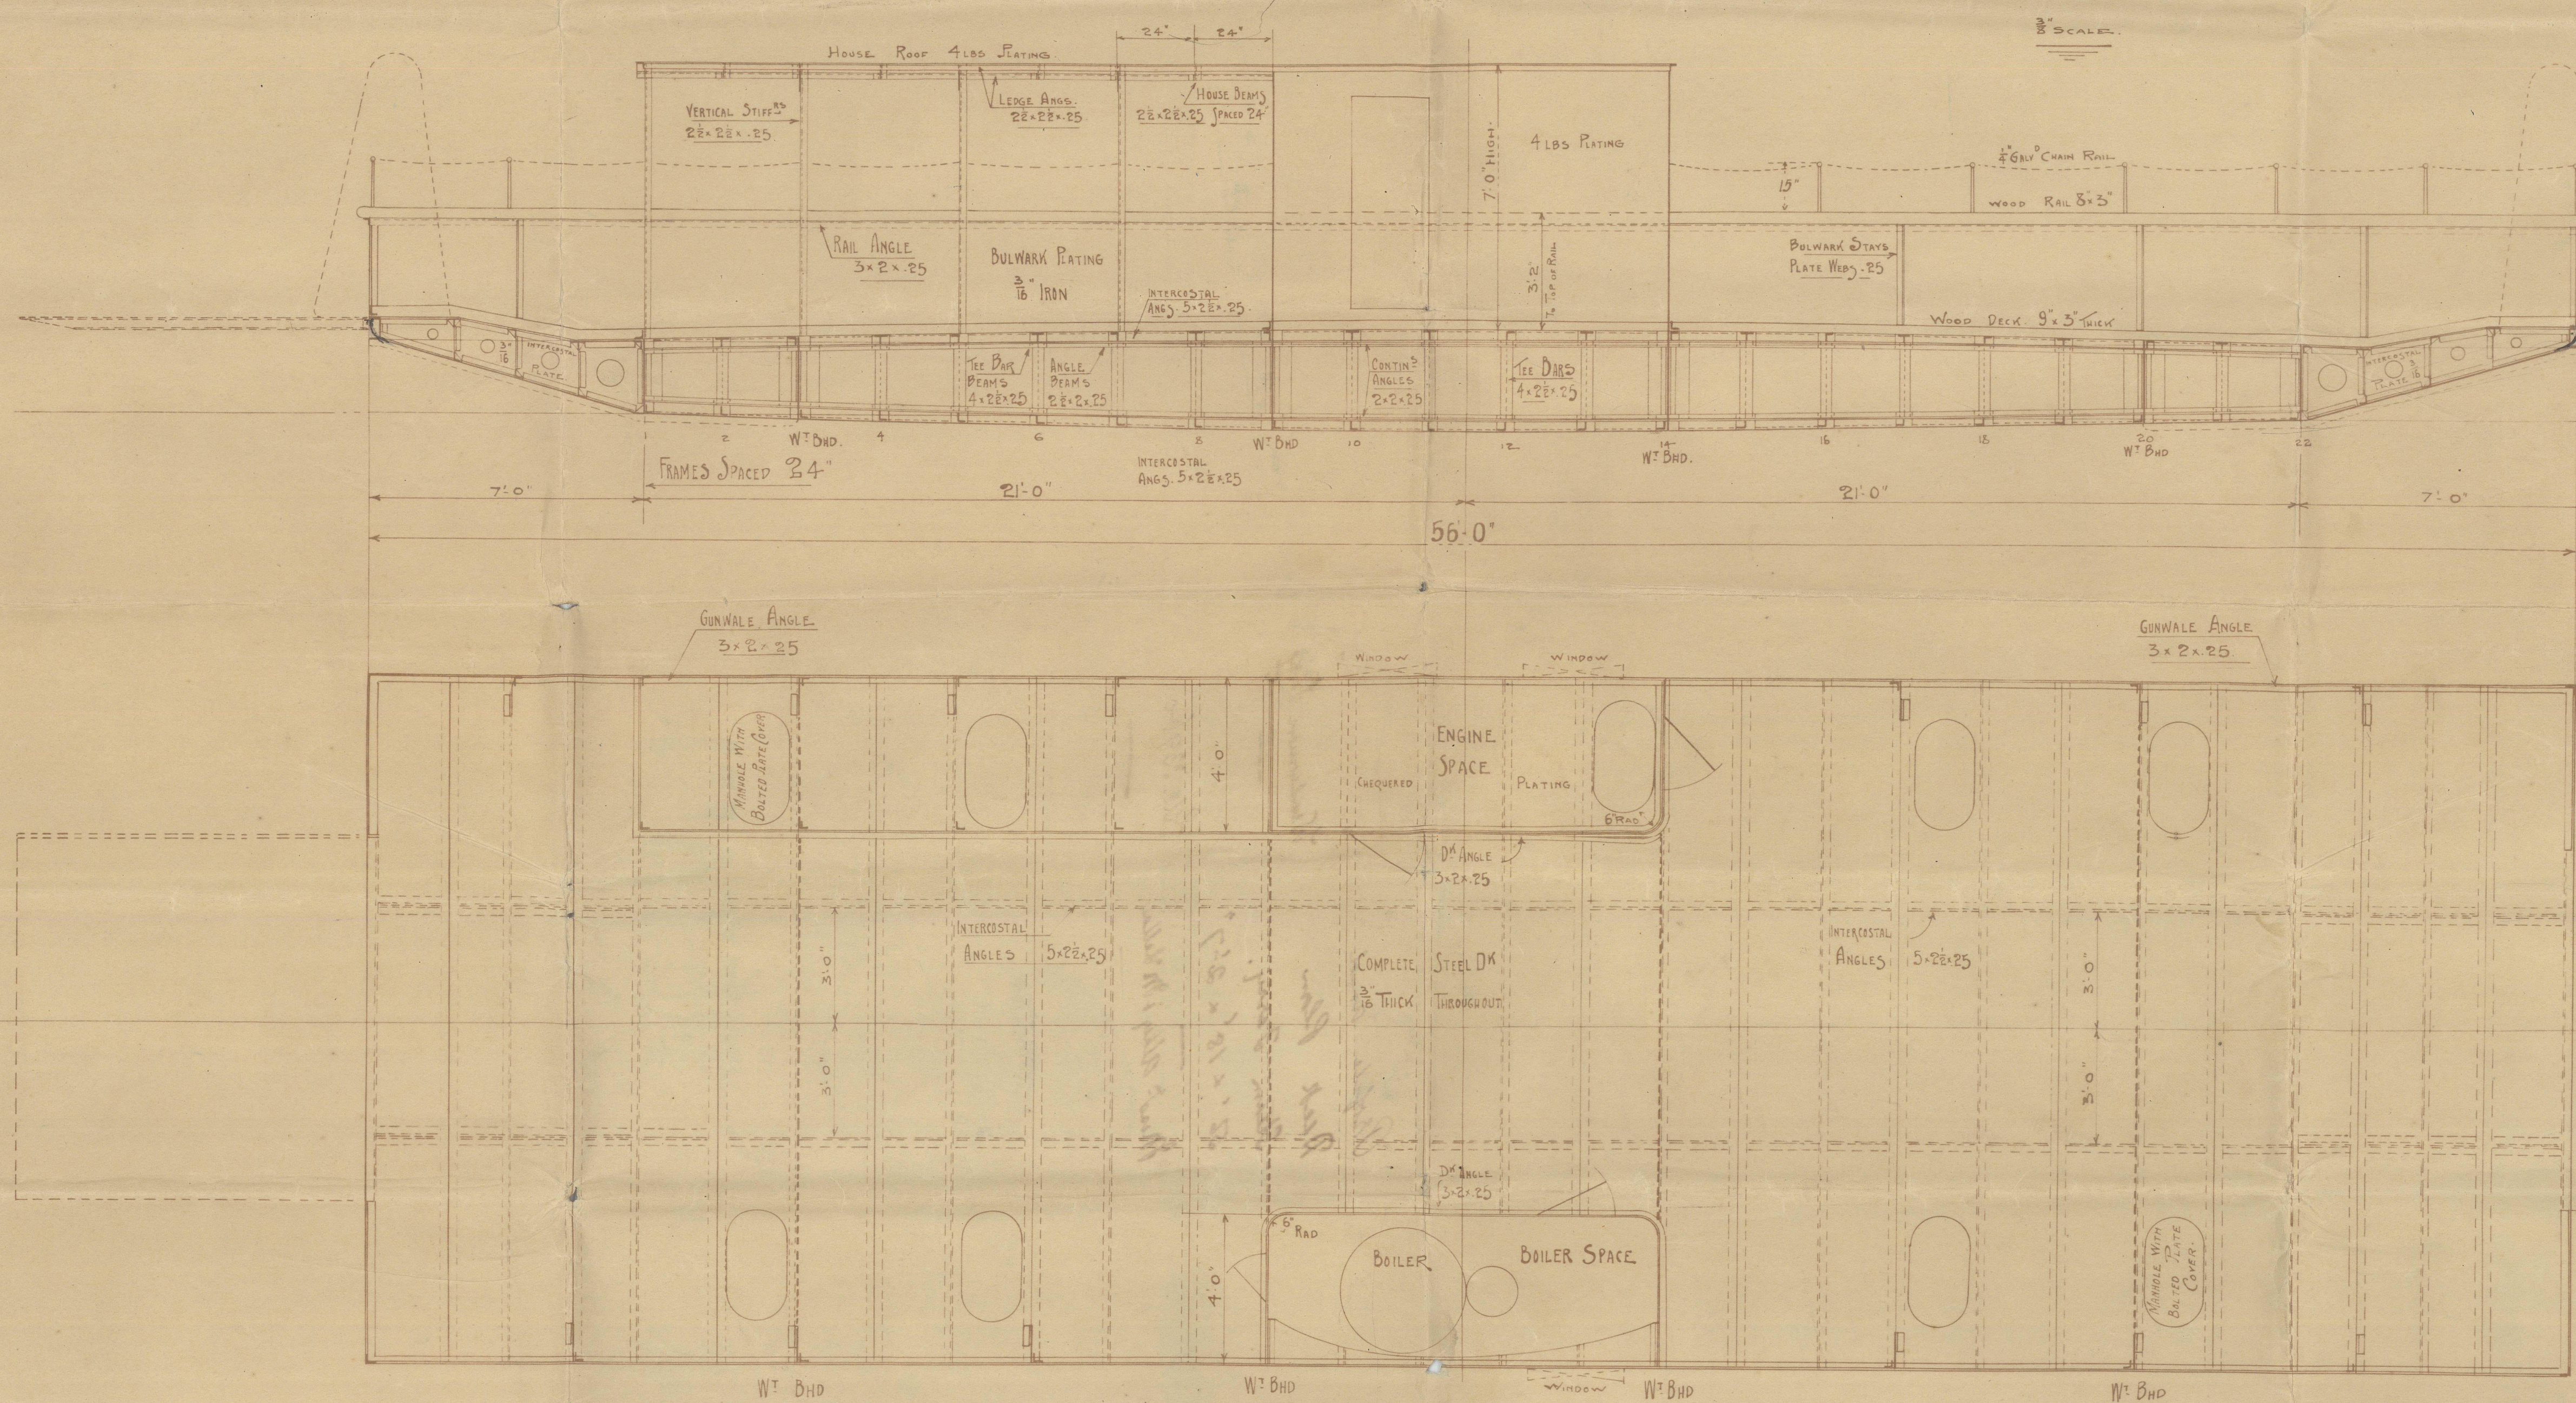

5.2.14



11126-0118

N^o 527
Profile and
Deck Plan
Steam Ferry.

56' x 18' x 2'-7"

Messrs. Alley & McLellan

"
Wunderman Ferry
—

Gl. 33960
—

